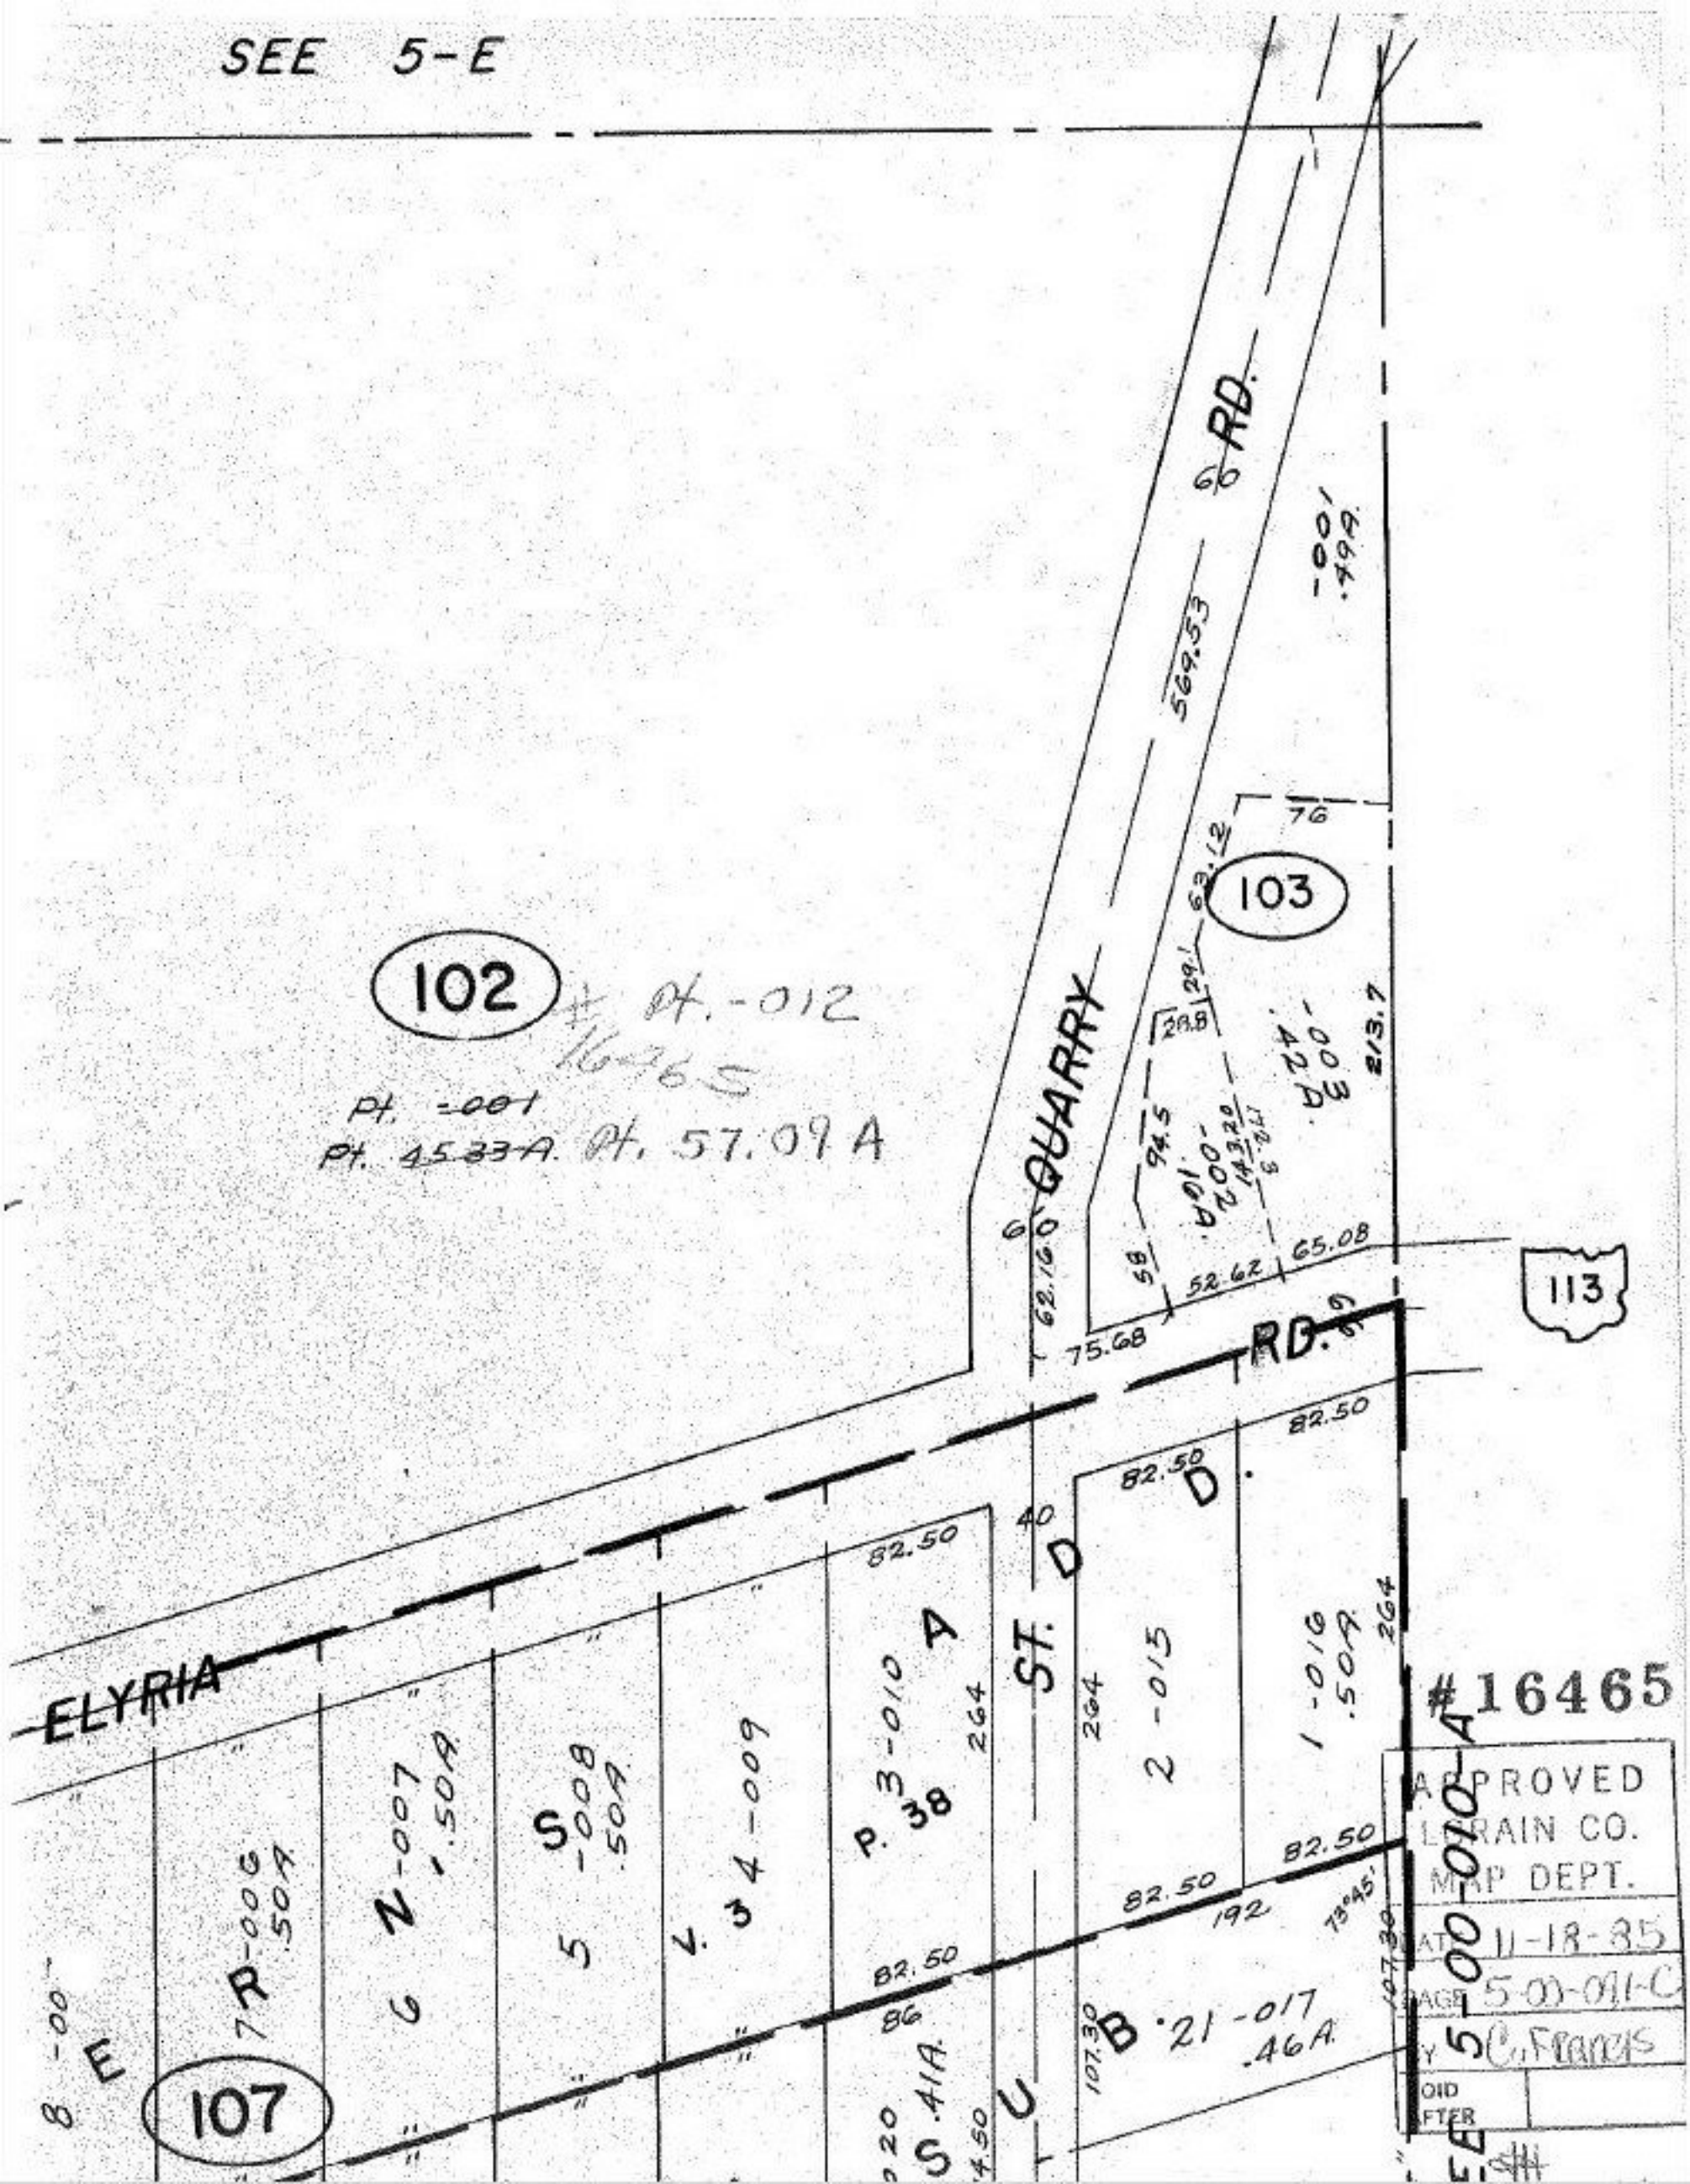
SEE 5-E
RD.
QUARRY
ELYRIA
RD.
ST.
102
103
107
113
#16465
Pt. -012
16465
Pt. -001
Pt. 45.33A. Pt. 57.09 A
569.53
-001
.49A.
76
63.12
29.1
28.8
94.5
58
52.62
65.08
75.68
62.16
213.7
-003
.42A.
-002
.16A.
82.50
40
264
192
107.30
73°45'
86
8 -00
7 R -006
.50A
6 N -007
.50A
5 S -008
.50A
V. 3 4 -009
P. 38 3 -010
A
2 -015
1 -016
.50A
B .21 -017
.46A.
S .41A.
U
5-00-010-A
#16465
APPROVED
LORAIN CO.
MAP DEPT.
DATE 11-18-85
PAGE 5-00-091-C
BY C. Francis
VOID
AFTER