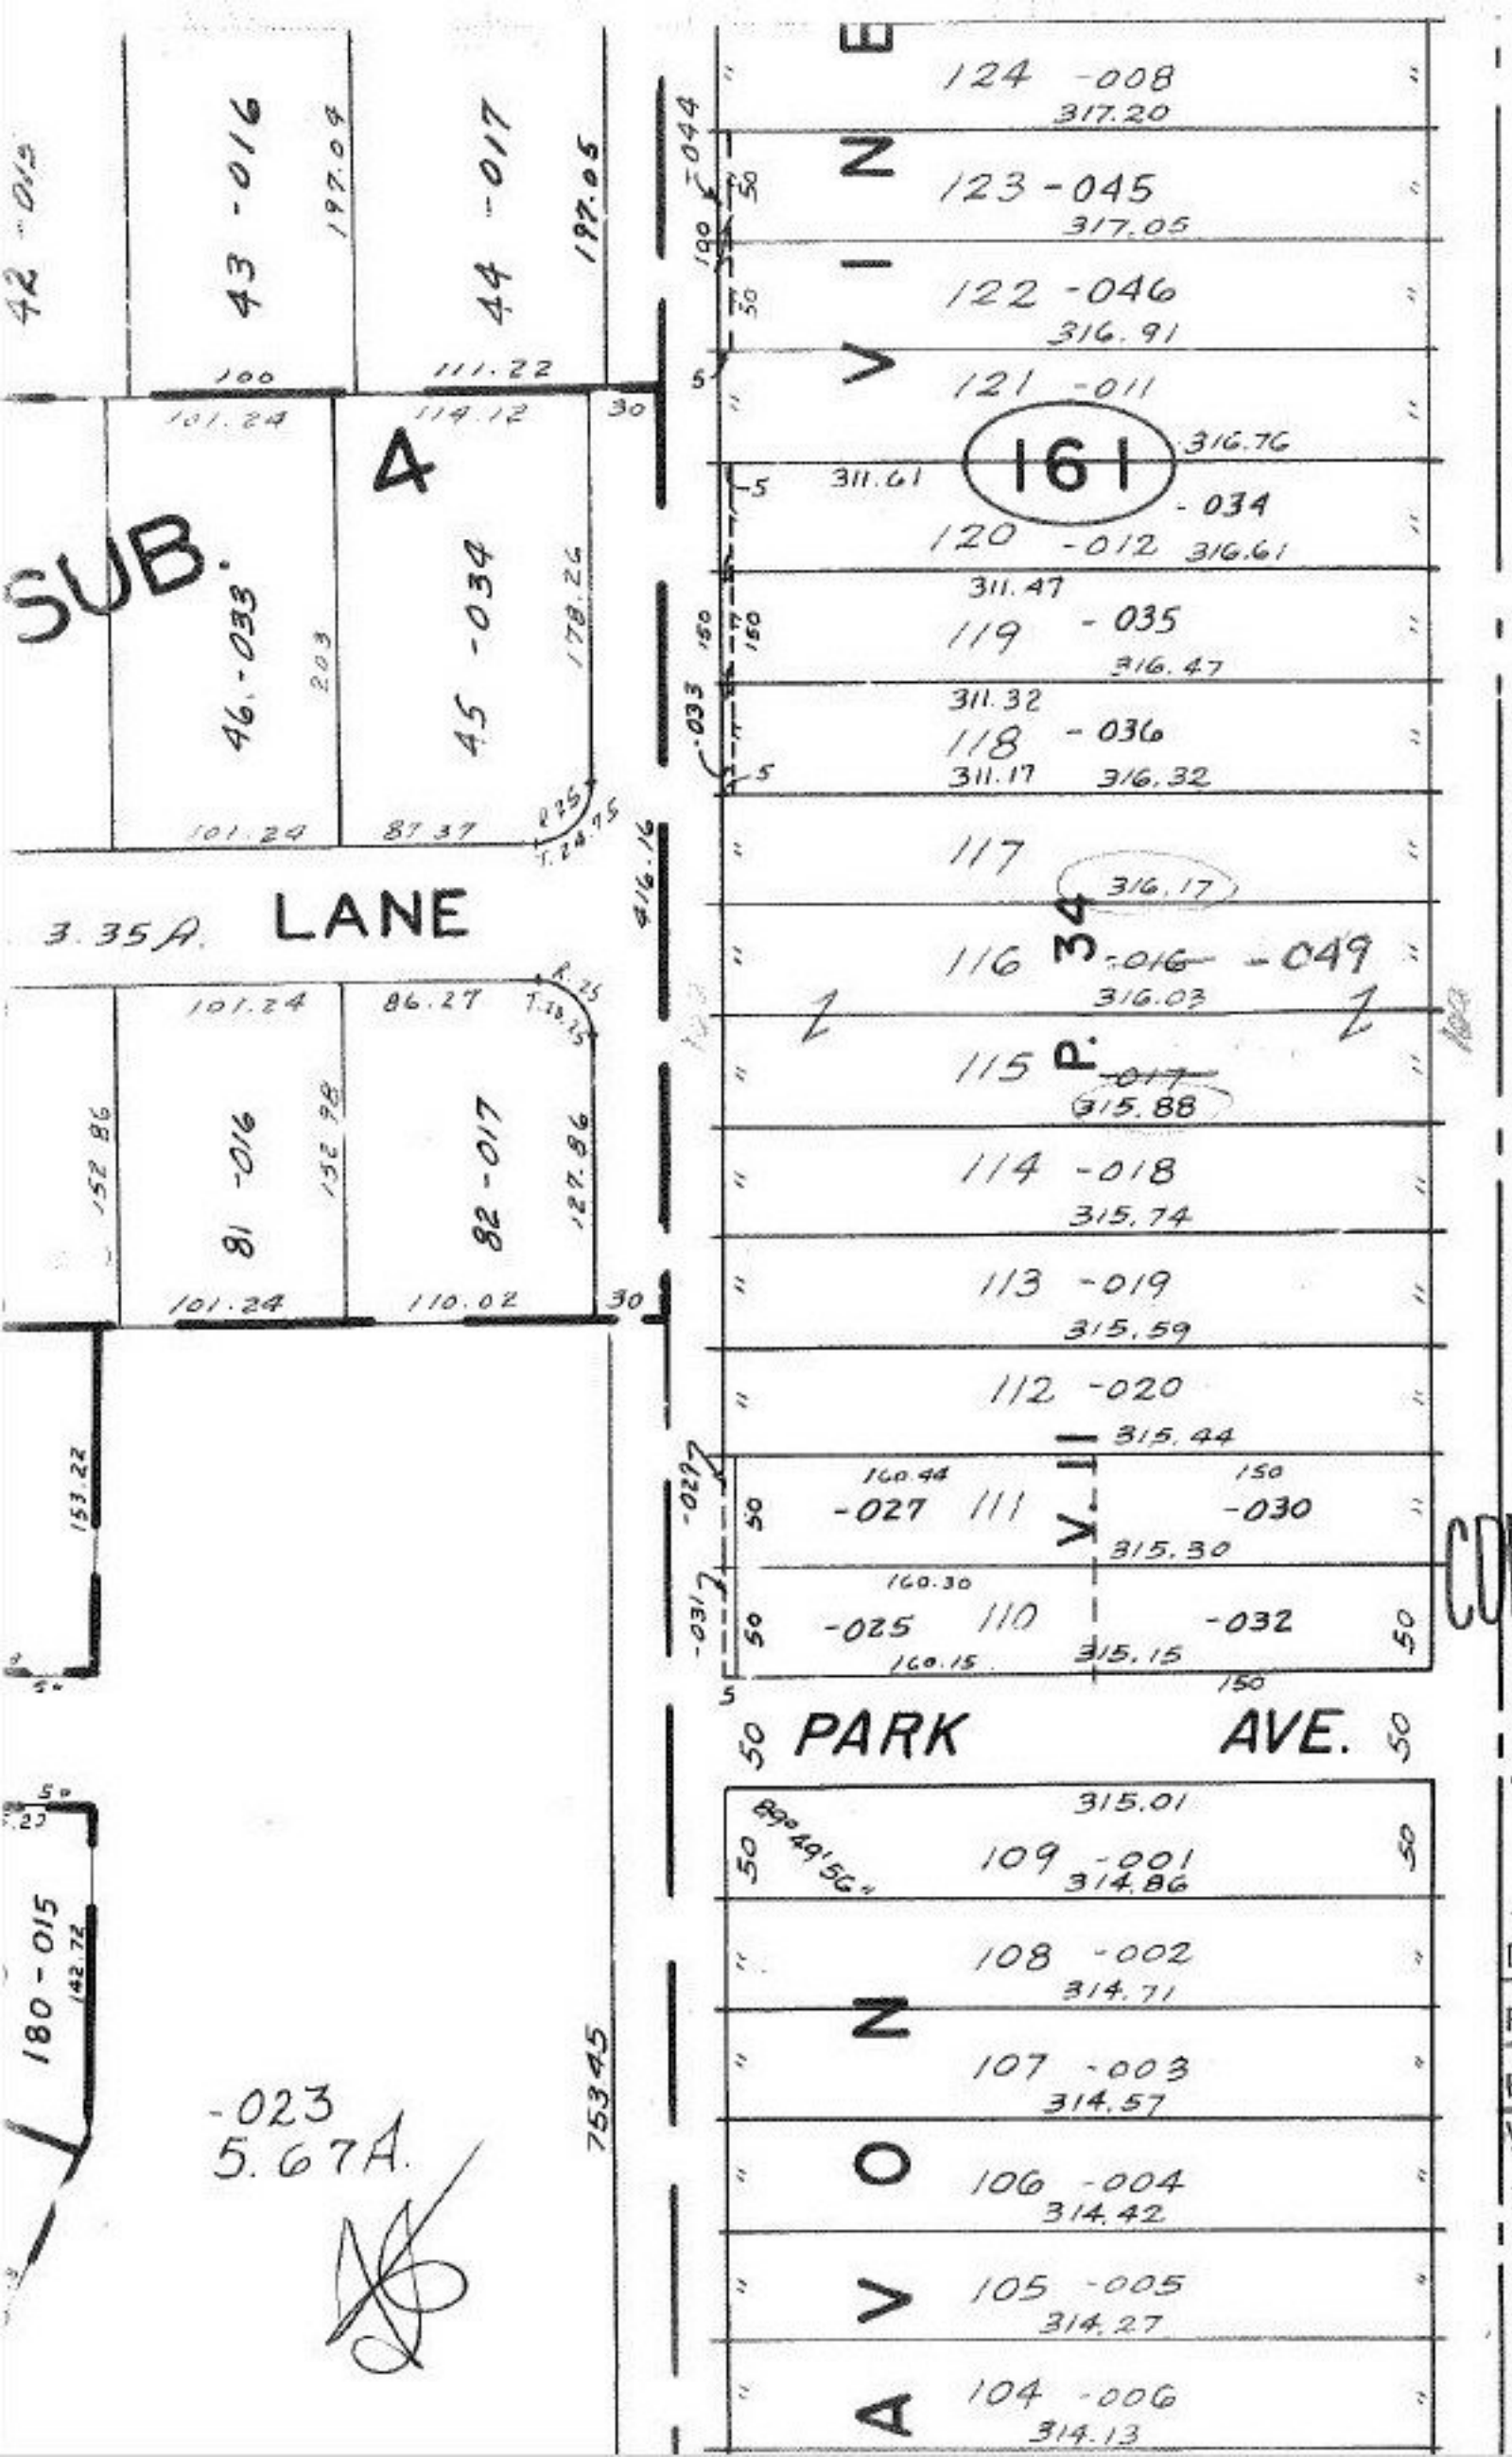

COMBINATION

#16470

APPROVED
LORAIN CO.
MAP DEPT.

DATE 11·19·85

PAGE 4·00·018·H

BY T. McNair

VOID

3-27-86

0-019-E