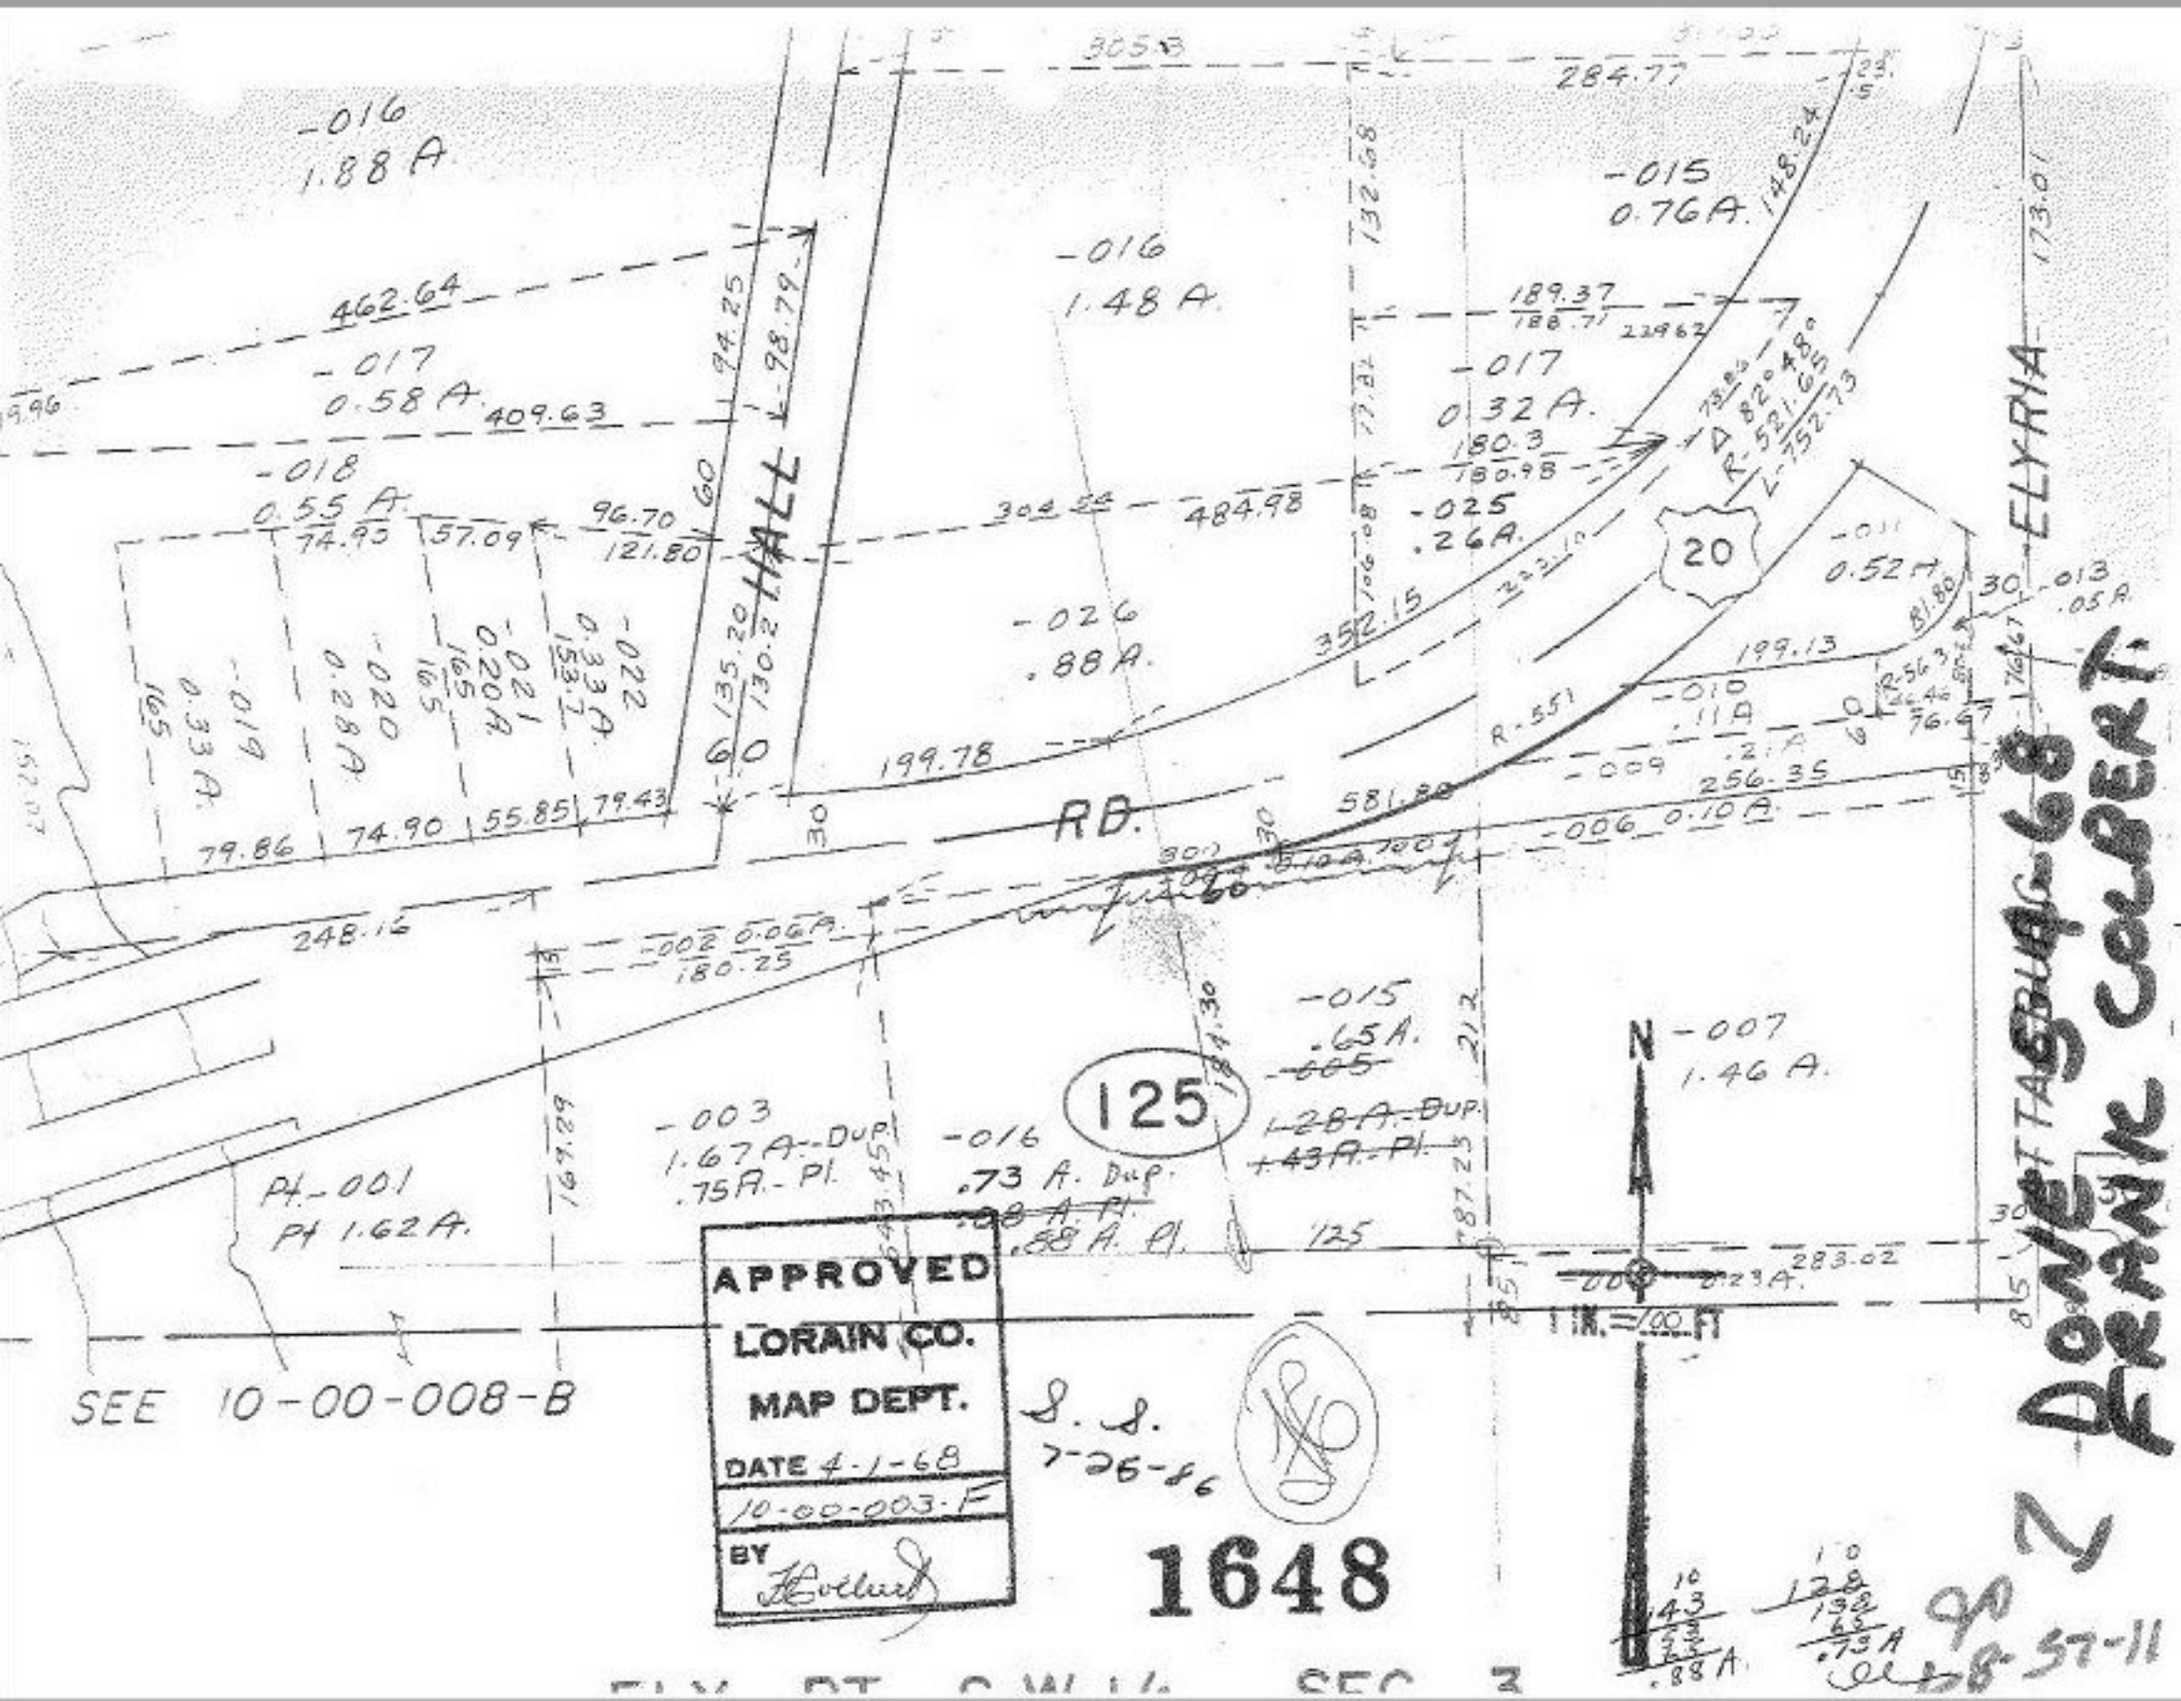
-016
1.88 A.
462.64
-017
0.58 A.
409.63
-018
0.55 A.
74.93
57.09
96.70
121.80
60
135.20
130.2
HALL
94.25
98.79
-016
1.48 A.
305.13
284.77
732.58
-015
0.76A.
148.24
189.37
188.71
22962
-017
0.32 A.
180.3
180.98
D 82° 48'
R-521.65
L-752.73
484.98
-025
.26A.
-026
.88A.
352.15
20
-011
0.52 A.
81.80
30
-013
.05 A
199.13
-010
.11A
-009
.21A
256.35
-006 0.10 A.
581.80
199.78
RD.
-022
0.33 A.
153.7
-021
0.20A.
165
-020
0.28A.
165
-019
0.33 A.
165
79.86
74.90
55.85
79.43
248.16
-002 0.06A.
180.25
-015
.65A.
-005
-28A.-DUP.
+43A.-PL.
-007
1.46 A.
N
-003
1.67 A.-DUP.
.75A.-PL.
-016
.73 A. DUP.
.88 A. PL.
125
PH-001
PH 1.62A.
APPROVED
LORAIN CO.
MAP DEPT.
DATE 4-1-68
10-00-003-F
BY
S. S.
7-26-96
1 IN. = 100 FT
SEE 10-00-008-B
1648
ELYRIA
DONE TAG 4-68
FRANK COLBERT
7
8-57-11