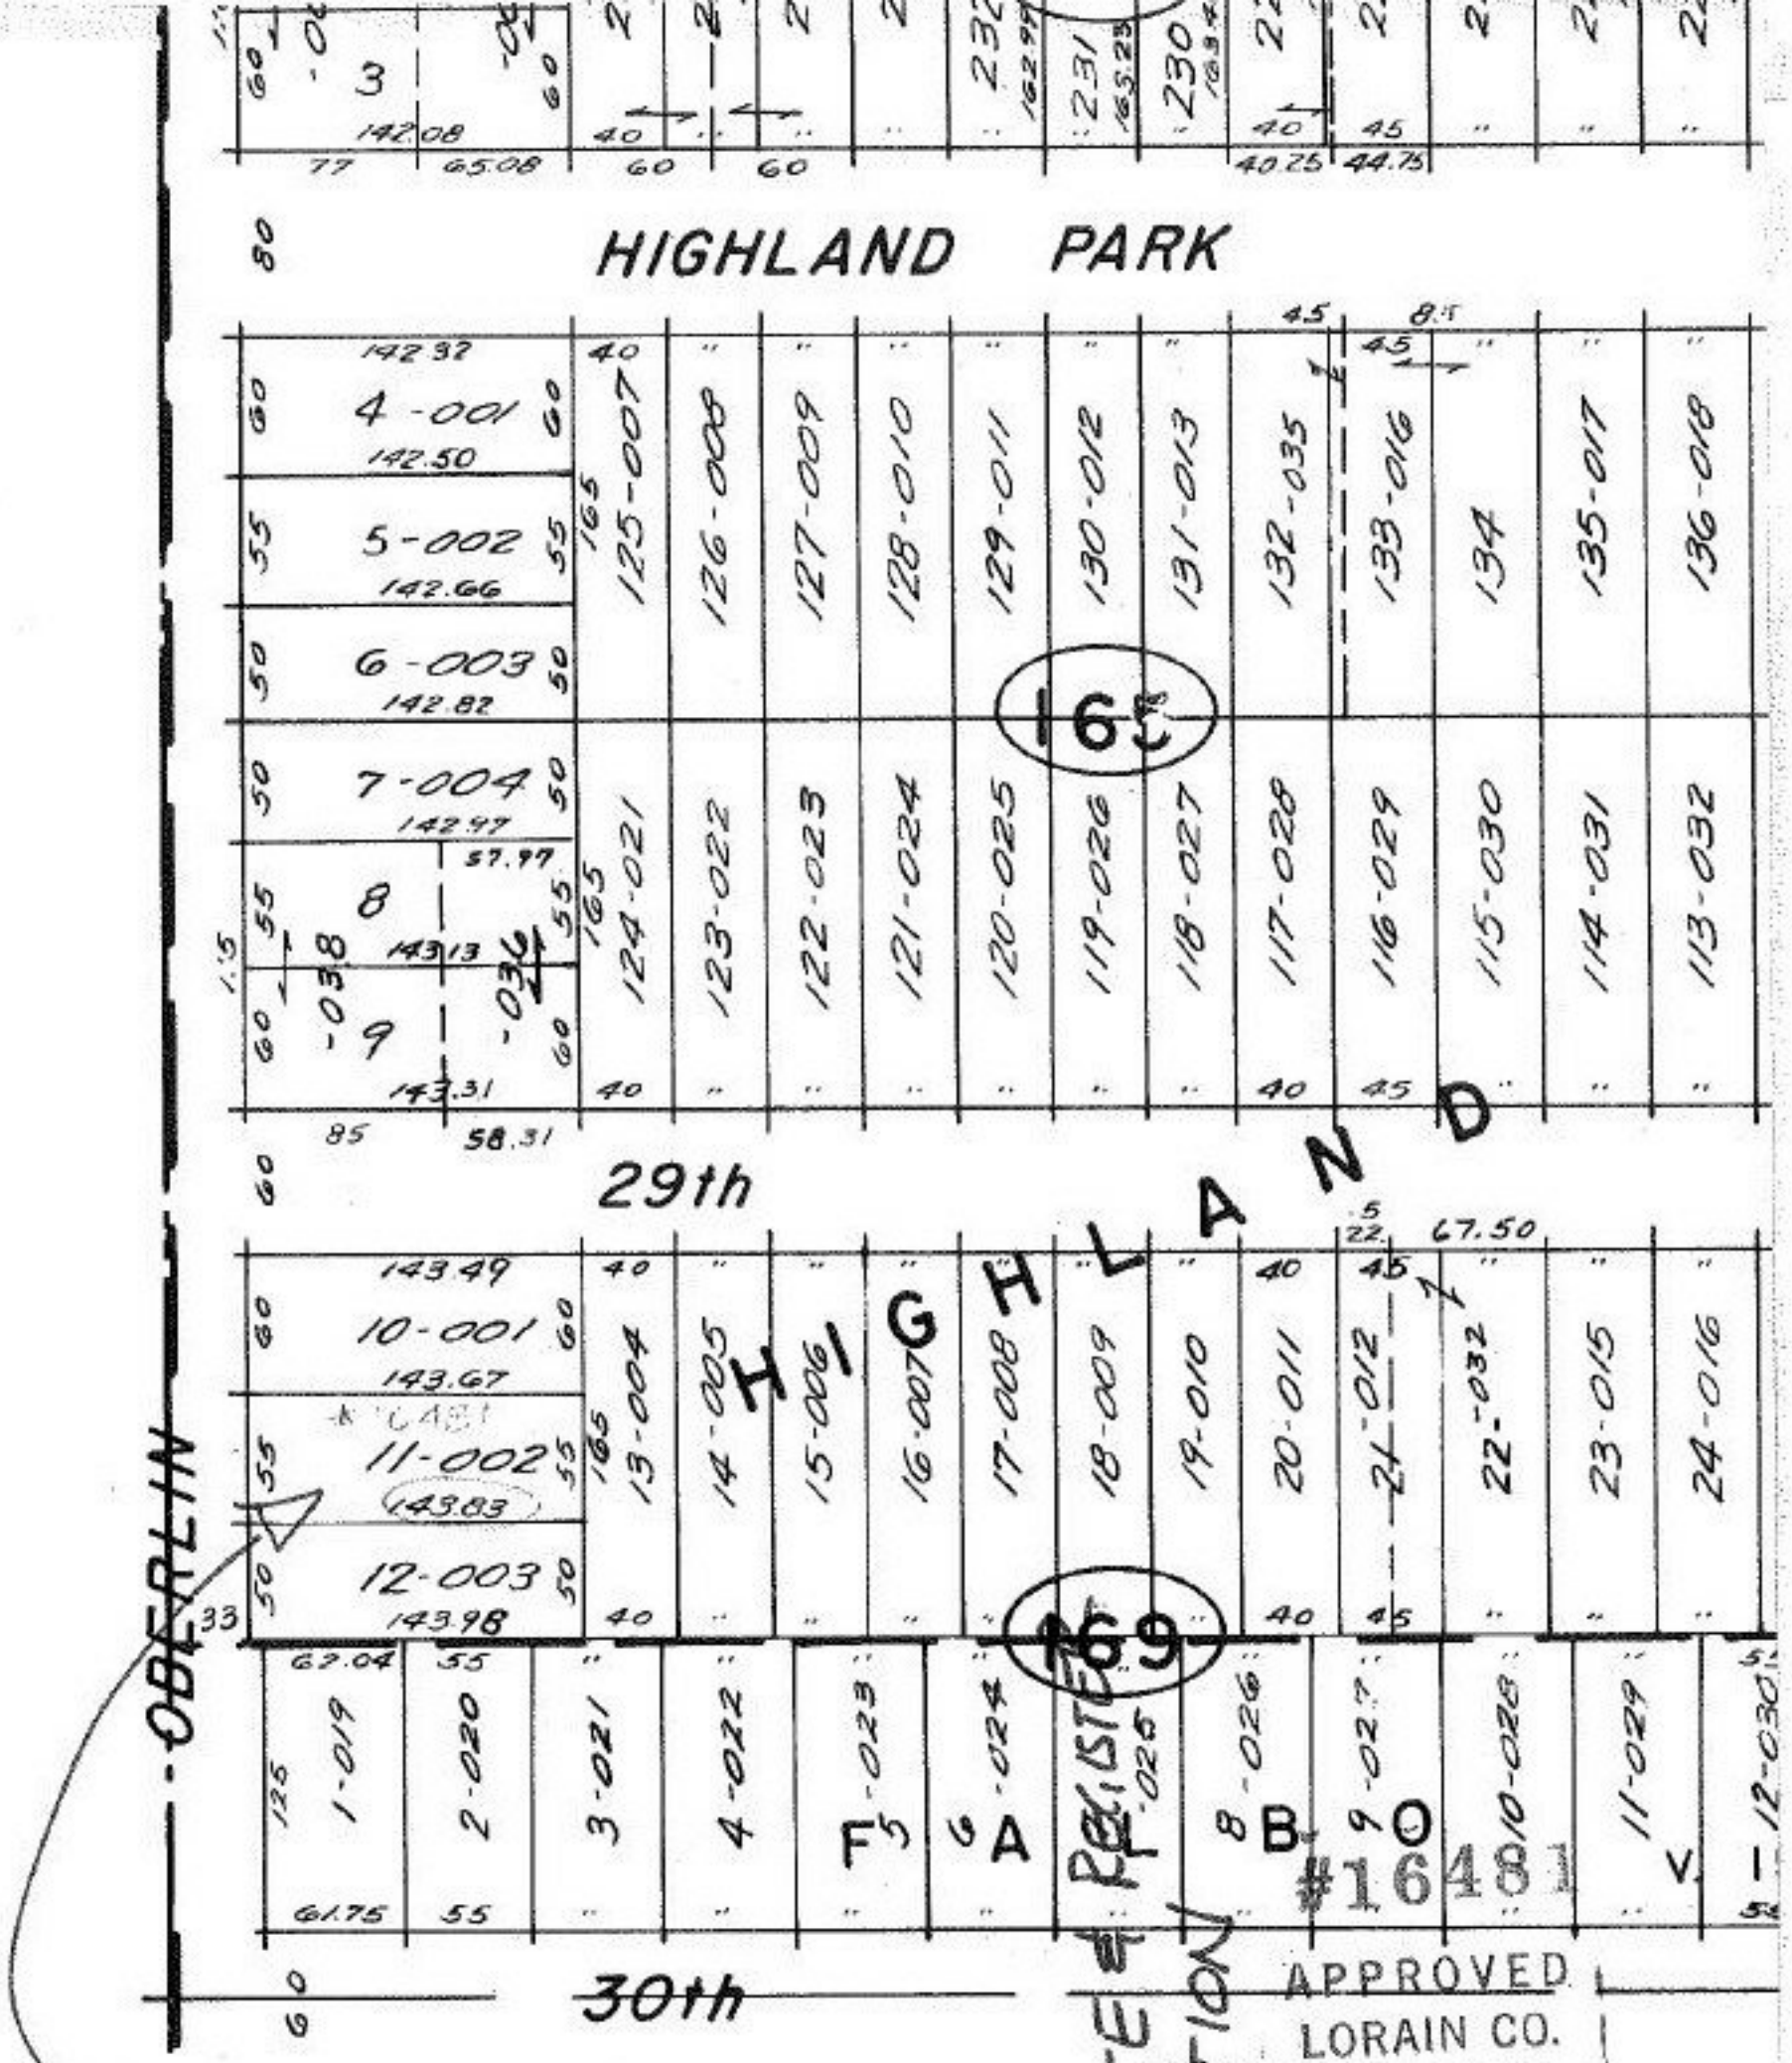

MAP AGREES w/ PLAT
- NO MAP CORRECTION NECESSARY

3/25/86

DUPLICATE & REGISTER CORRECTION

APPROVED
LORAIN CO.
MAP DEPT.
DATE 11·29·85
PAGE 2·01·006·E
BY T. McNair
VOID AFTER

TRACT I PT. LOT 6

006-E