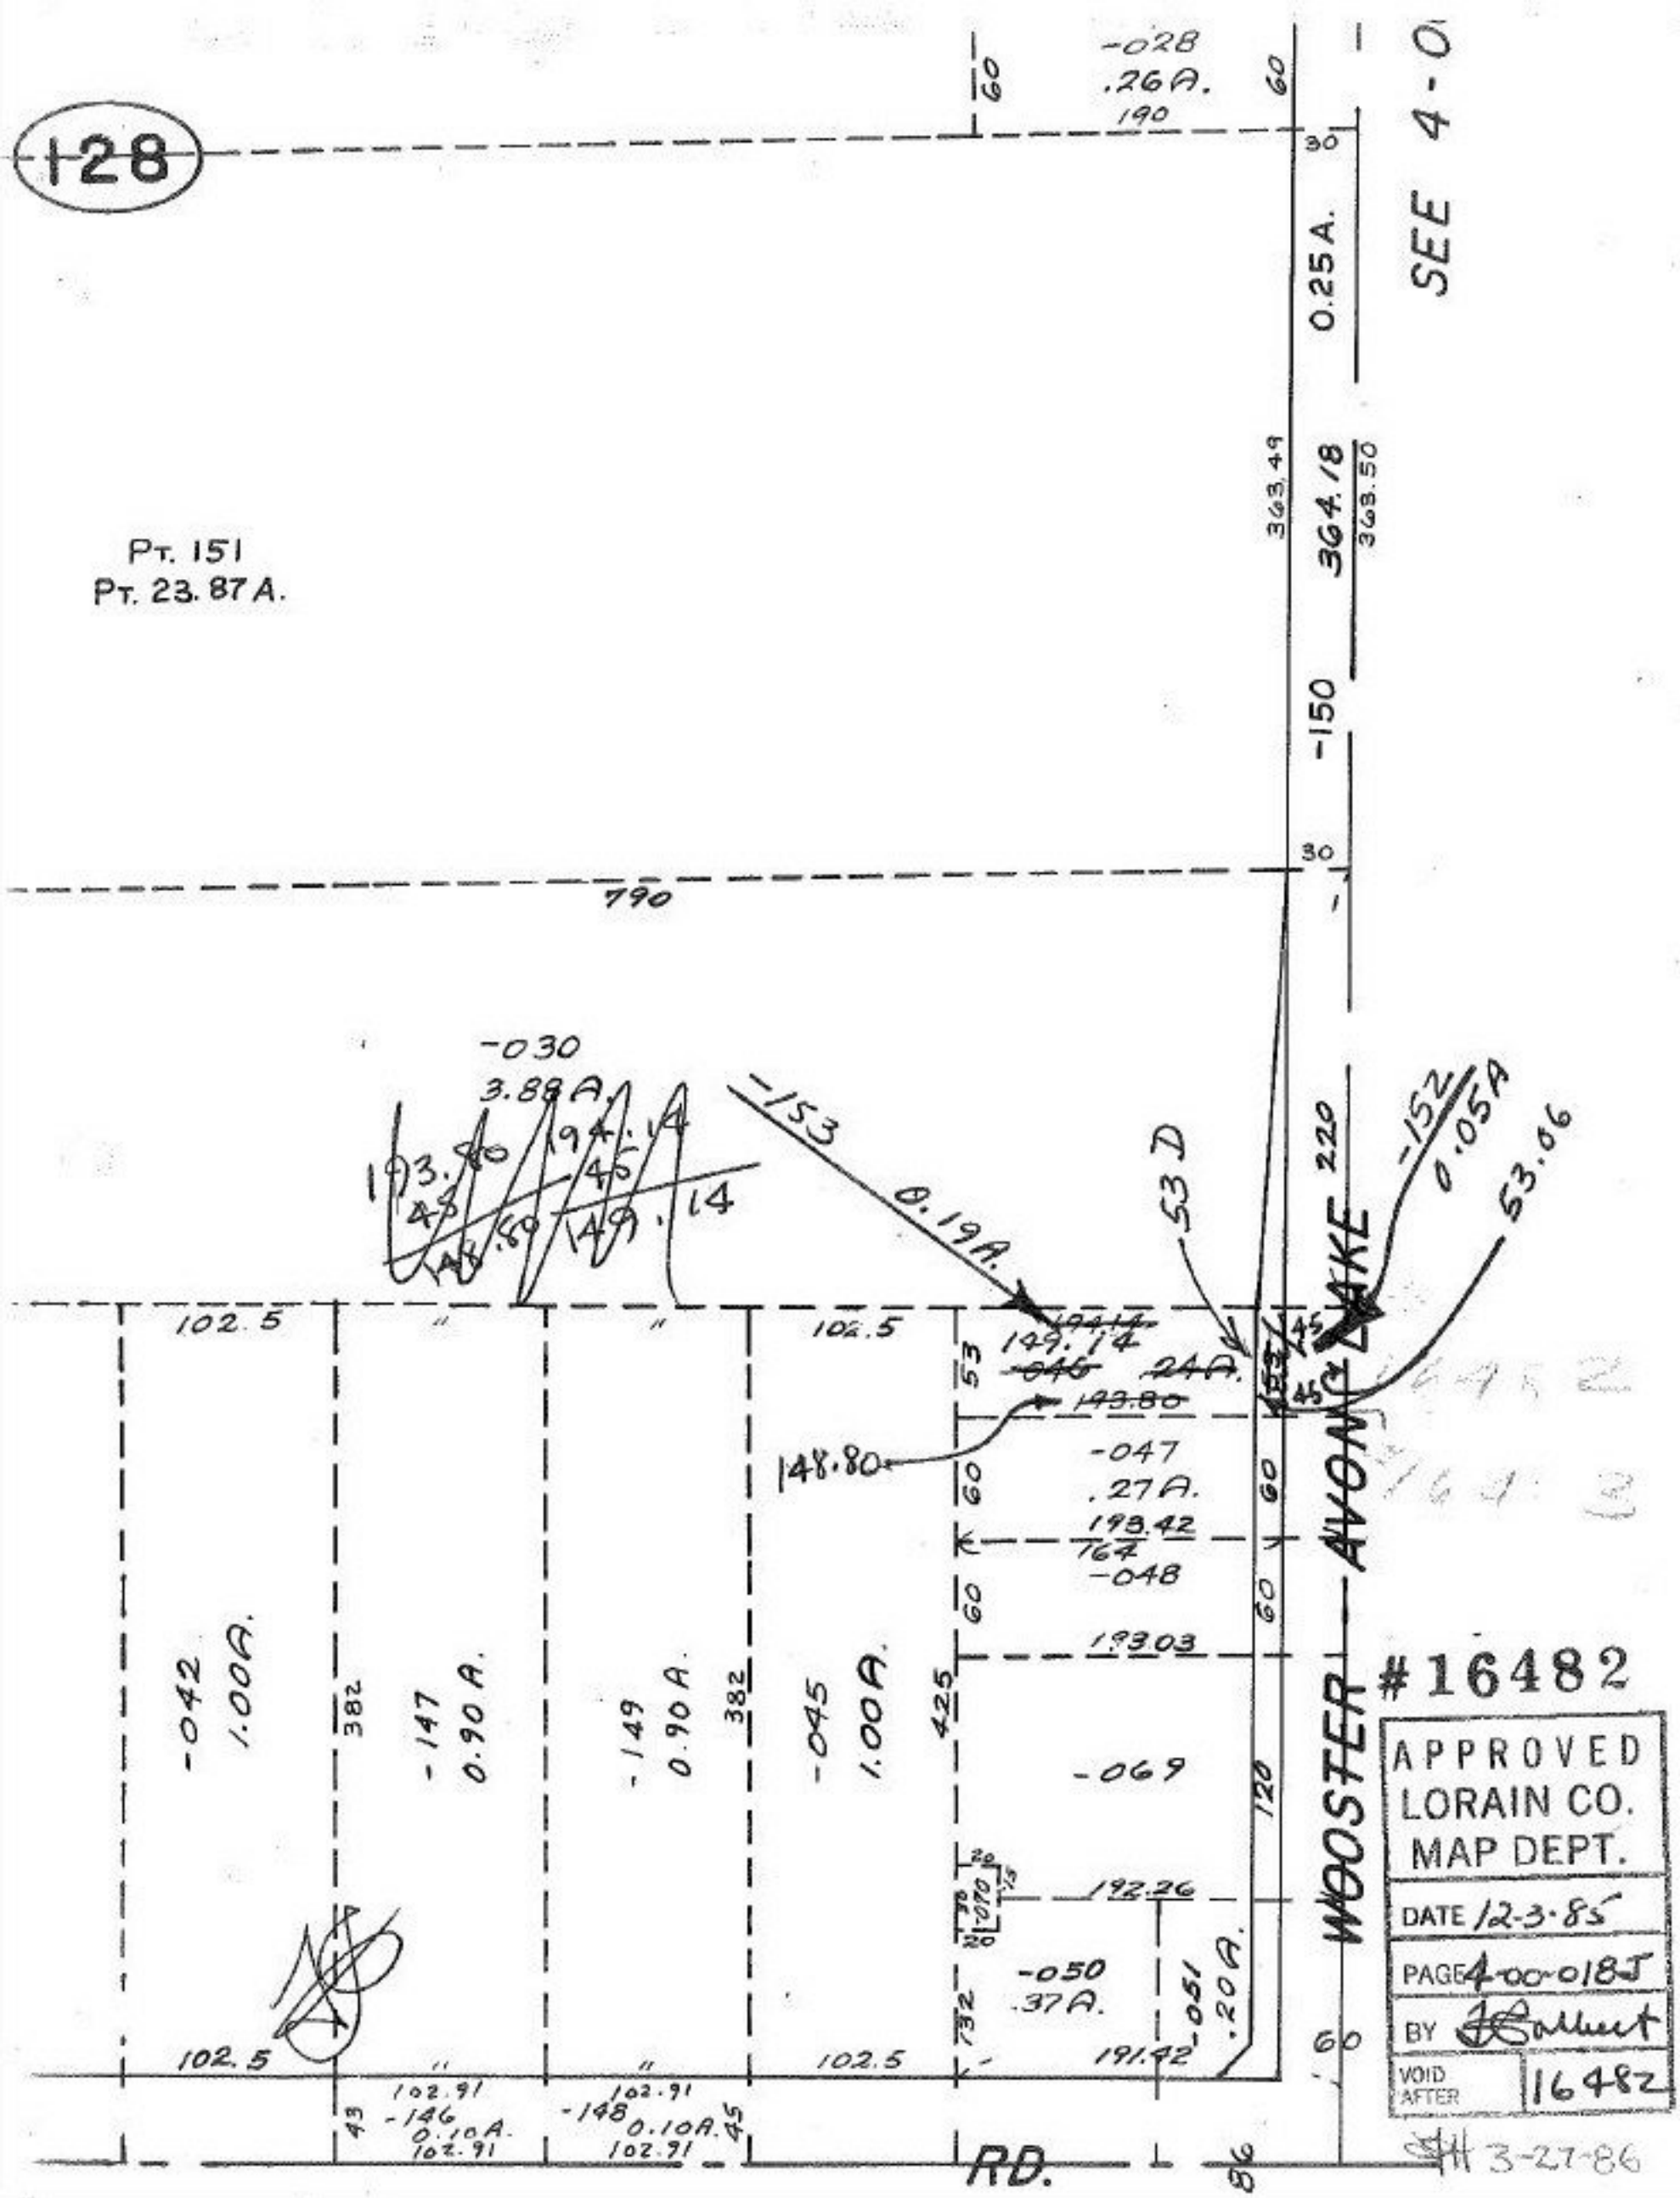
128
-028
.26A.
190
60
60
30
0.25 A.
SEE 4-0
363.49
364.18
363.50
PT. 151
PT. 23.87 A.
-150
30
790
-030
3.88 A.
193.80
194.14
45
148.80
149.14
-153
0.19A.
53 D
220
-152
0.05A
53.06
102.5
102.5
149.14
-046
.24A.
193.80
148.80
-047
.27A.
193.42
164
-048
193.03
-042
1.00A.
382
-147
0.90 A.
-149
0.90 A.
382
-045
1.00A.
425
-069
120
192.26
-050
.37A.
-051
.20A.
191.42
102.5
102.5
102.91
-146
0.10A.
102.91
102.91
-148
0.10A.
102.91
43
45
RD.
86
WOOSTER AVON LAKE
#16482
APPROVED
LORAIN CO.
MAP DEPT.
DATE 12-3-85
PAGE 4-00-018J
BY
VOID AFTER 16482
3-27-86