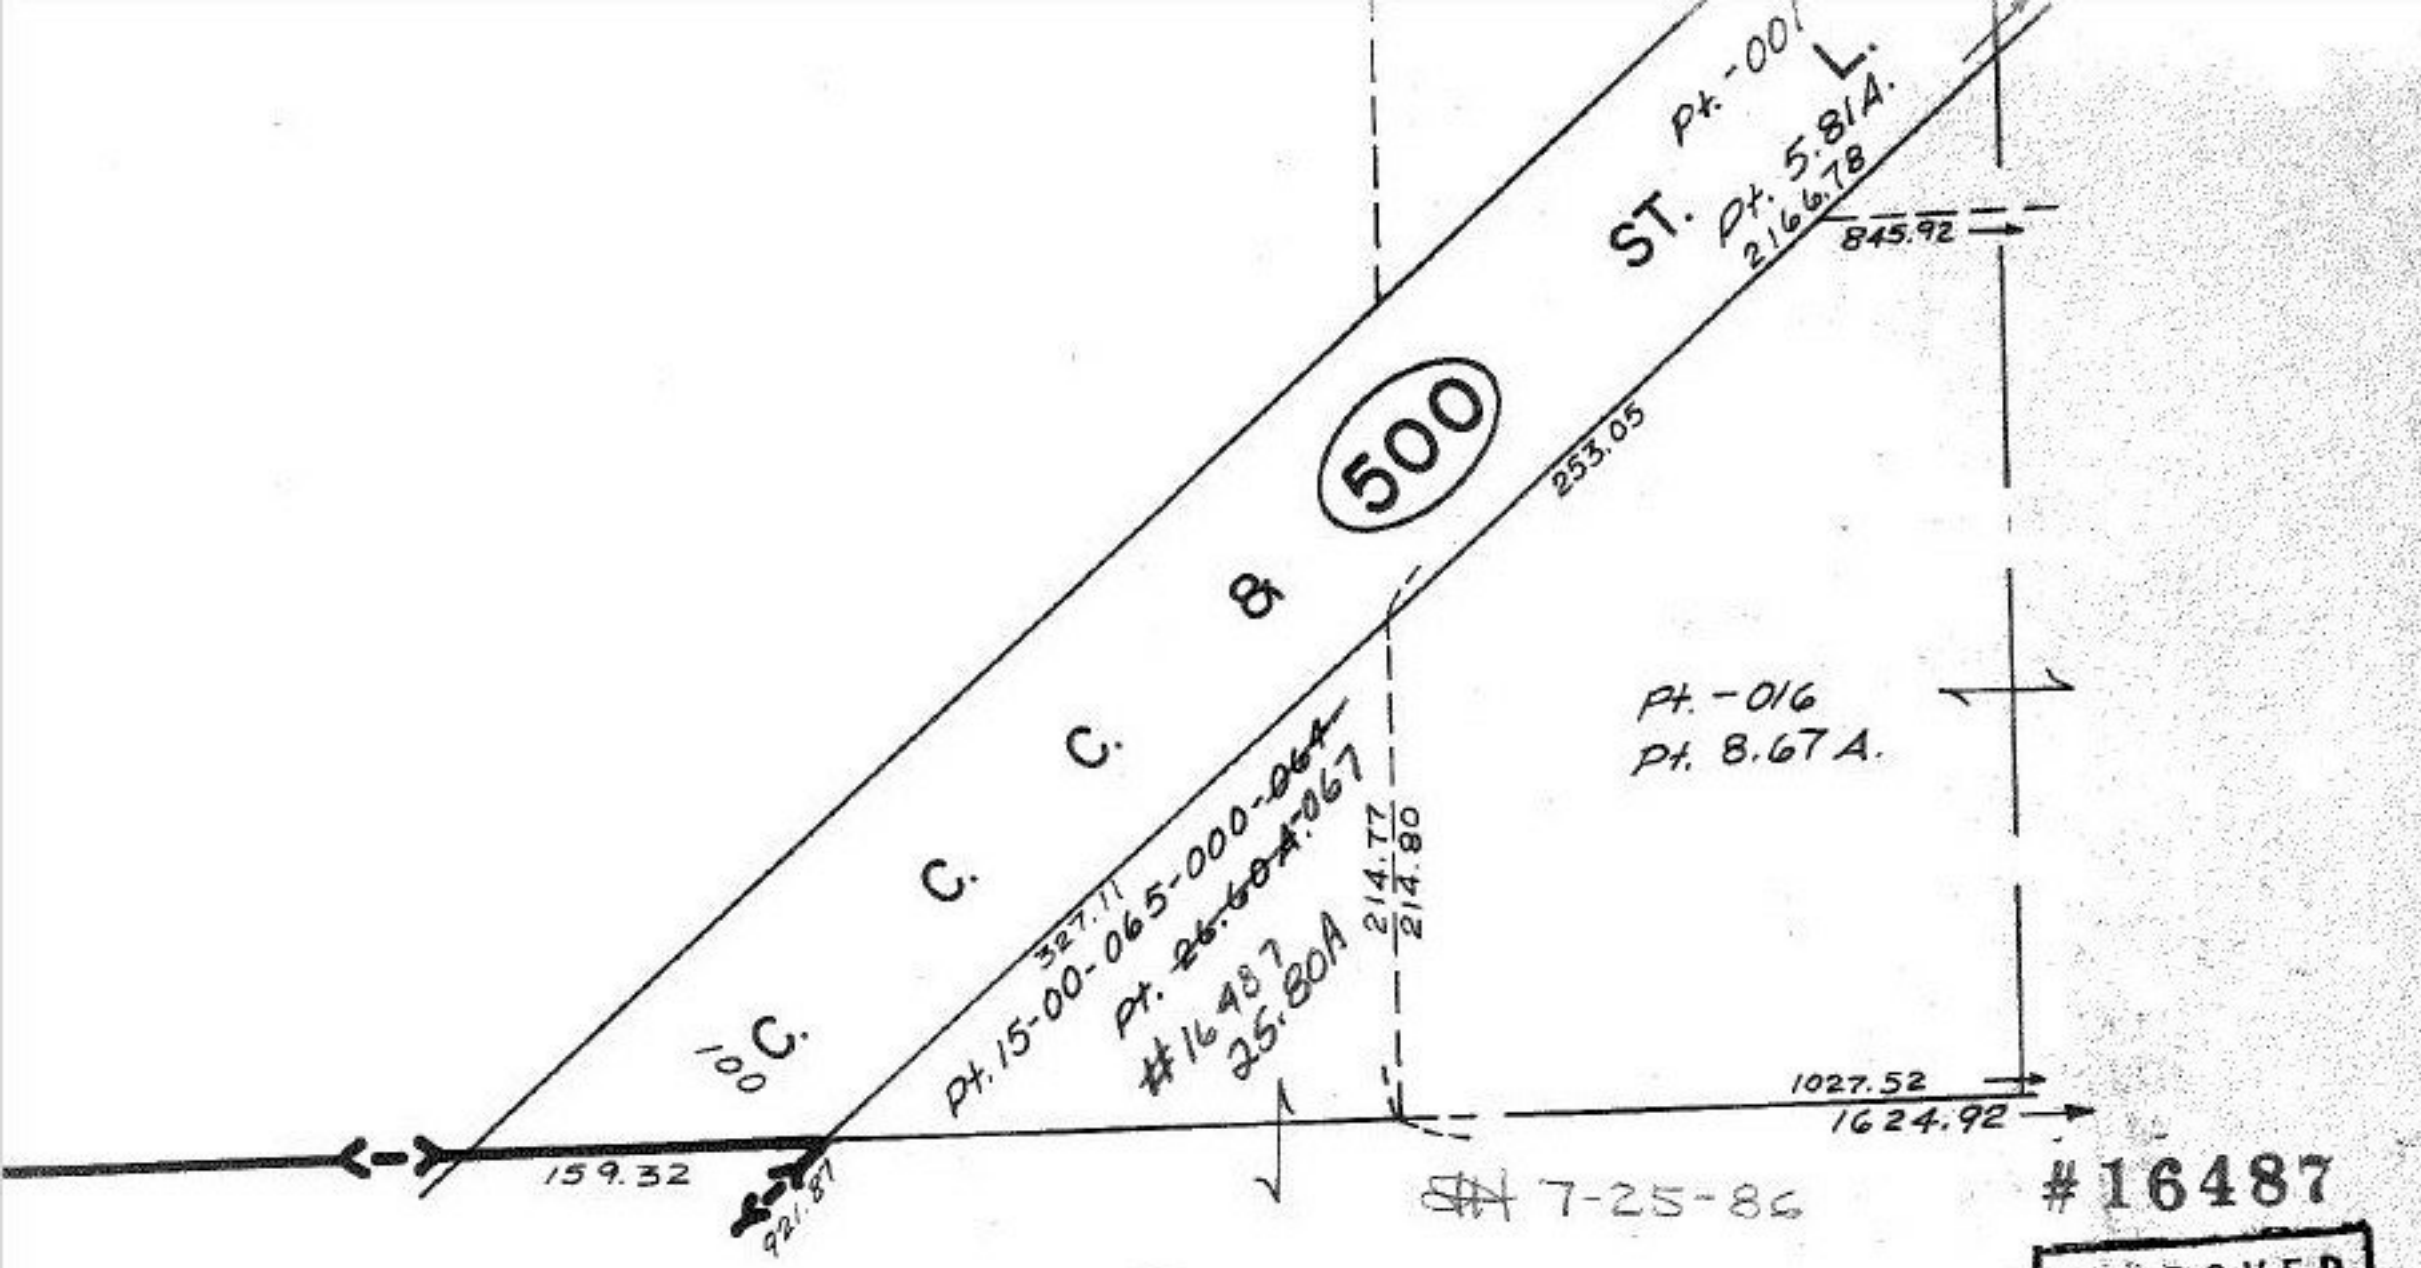

APPROVED
LORAIN CO.
MAP DEPT.
DATE 12-4-85
PAGE 15-00-056A
BY
VOID AFTER 16487

SEE 15-00-065-B

LAGRANGE TWP.

SCALE: 1" = 100'