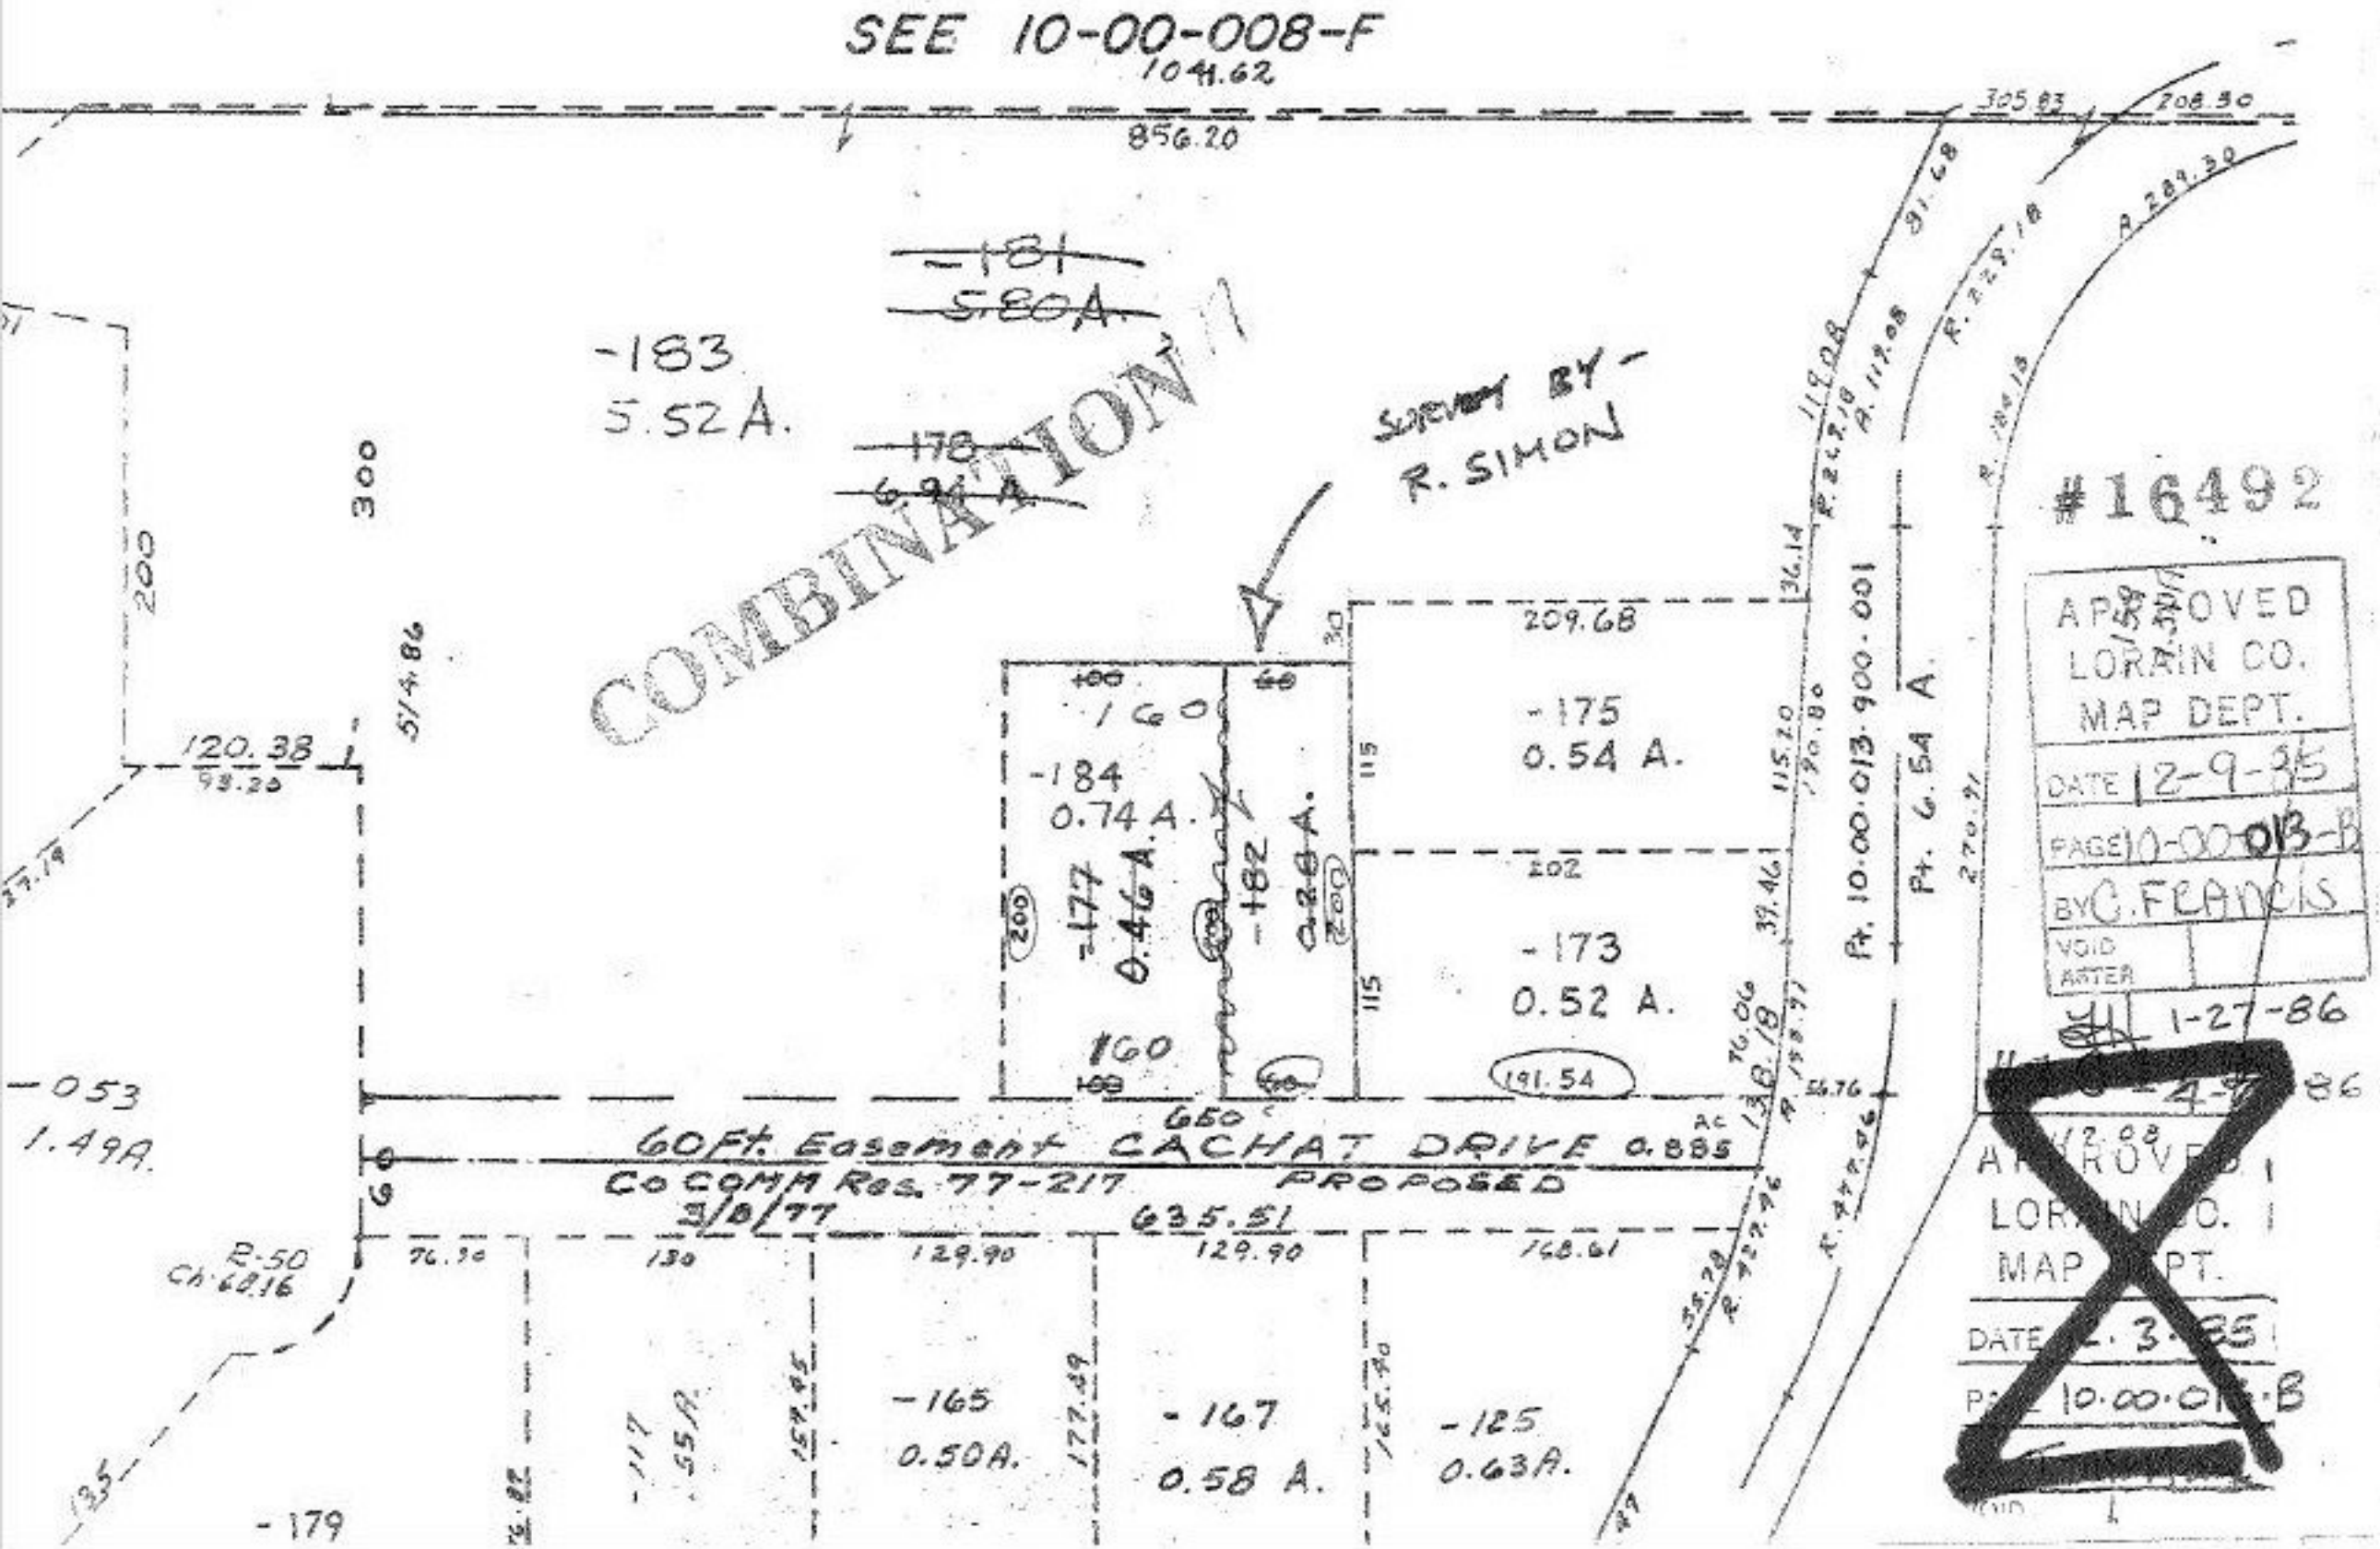
SEE 10-00-008-F
1041.62
856.20
305.83
208.30
-181
5.80A.
-183
5.52A.
-178
6.94 A.
COMBINATION
SURVEY BY -
R. SIMON
300
200
514.86
120.38
93.20
209.68
-175
0.54 A.
-184
0.74 A.
-177
0.46 A.
-182
0.28 A.
-173
0.52 A.
160
191.54
Pt. 10.00.013.900.001
Pt. 6.54 A.
-053
1.49A.
60Ft. Easement CACHAT DRIVE 0.885
CoCOMM Res. 77-217 PROPOSED
3/8/77
635.51
R-50
Ch. 68.16
-165
0.50A.
-167
0.58 A.
-125
0.63A.
-179
#16492
APPROVED
LORAIN CO.
MAP DEPT.
DATE 12-9-85
PAGE 10-00-013-B
BY C. FRANCIS
VOID
AFTER
1-27-86
APPROVED
LORAIN CO.
MAP DEPT.
DATE 2.3.85
PAGE 10.00.013-B