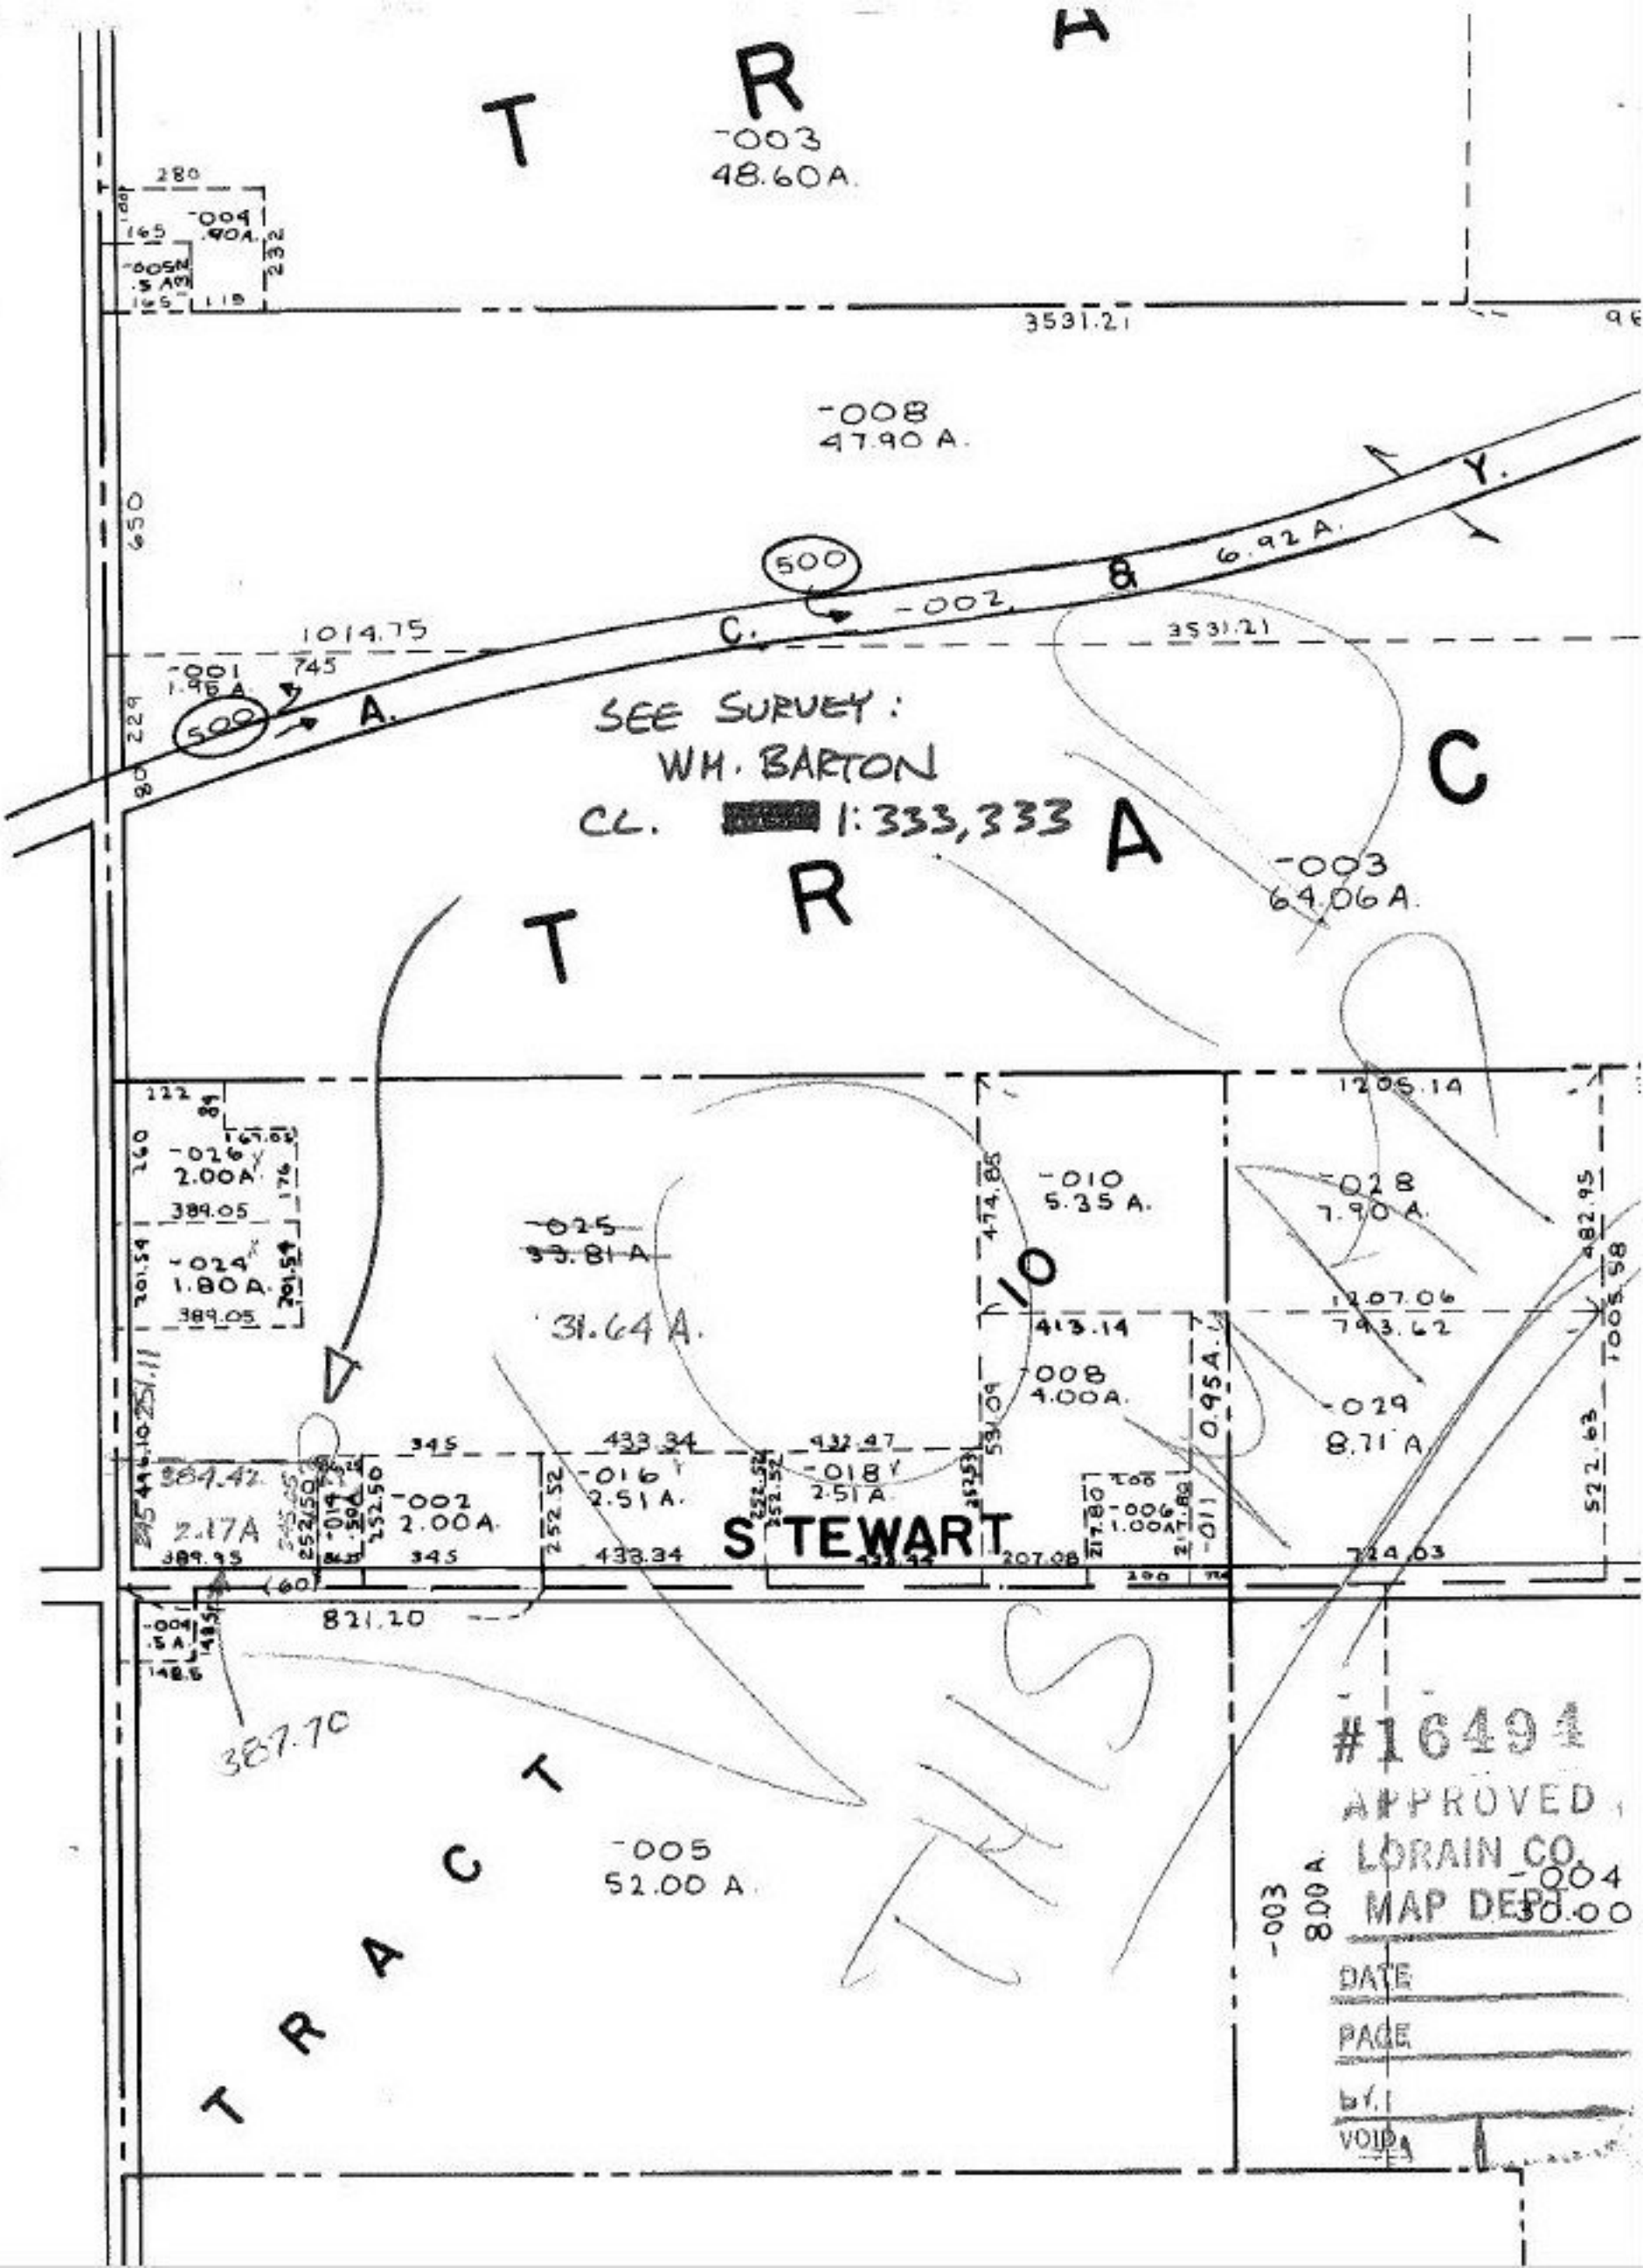

TRACT
-003
48.60A.
-008
47.90 A.
500
-002
6.92 A.
1014.75
3531.21
-001
1.95 A.
SEE SURVEY:
WM. BARTON
CL. [redacted] 1:333,333
-003
64.06 A.
-026
2.00A
-024
1.80 A.
-025
33.81 A.
31.64 A.
-010
5.35 A.
-028
7.90 A.
-008
4.00A.
-029
8.71 A.
-016
2.51 A.
-018
2.51 A.
-002
2.00A.
2.17A
STEWART
821.20
387.70
-005
52.00 A.
-003
8.00 A.
-004
30.00
#16494
APPROVED
LORAIN CO.
MAP DEPT.
DATE
PAGE
BY
VOID