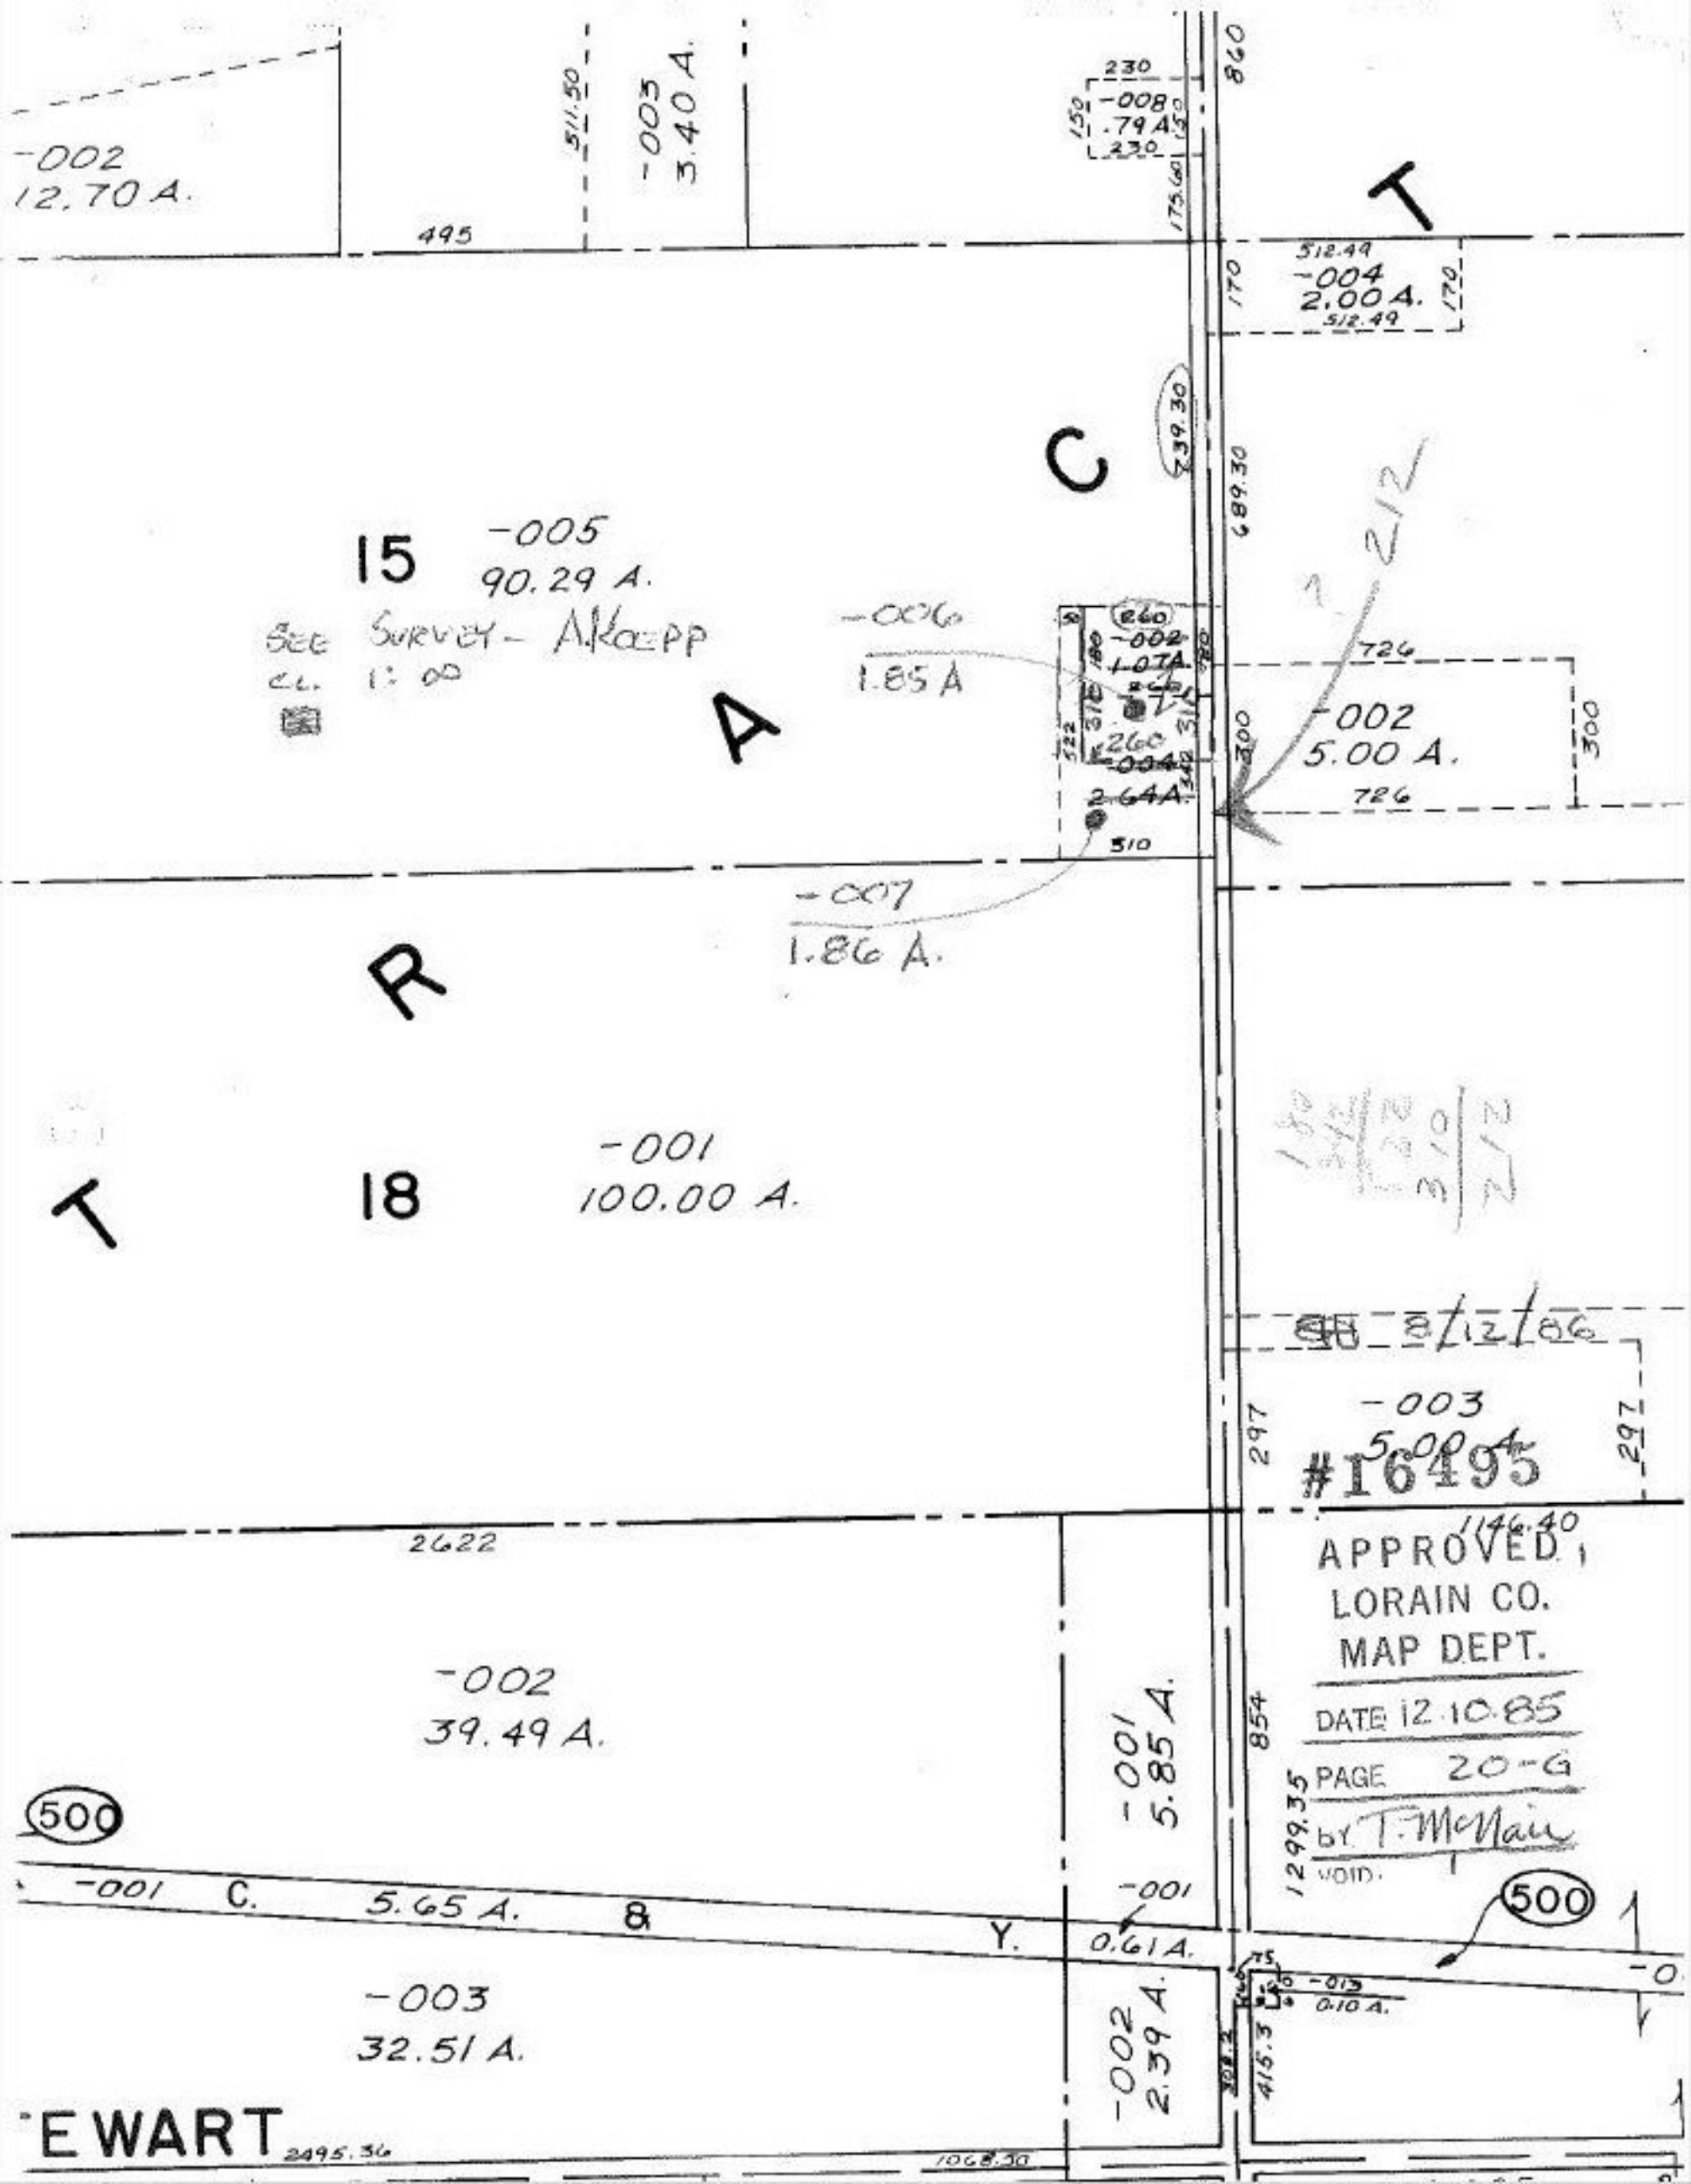

-002
12.70 A.
495
511.50
-003
3.40 A.
230
-008
.79 A
230
175.60
860
T
512.49
-004
2.00 A.
512.49
170
170
739.30
689.30
C
15
-005
90.29 A.
SEE SURVEY - AKOEPP
CL. 1:00
-006
1.85 A
260
-002
1.07 A.
260
-004
2.64 A.
510
726
-002
5.00 A.
726
300
300
212
A
-007
1.86 A.
R
T
18
-001
100.00 A.
8/12/86
-003
5.00 A.
297
297
#16495
1146.40
APPROVED
LORAIN CO.
MAP DEPT.
DATE 12.10.85
PAGE 20-G
BY T. McNair
VOID.
2622
-002
39.49 A.
-001
5.85 A.
854
1299.35
500
-001
C.
5.65 A.
&
Y.
-001
0.61 A.
500
-003
32.51 A.
-002
2.39 A.
-013
0.10 A.
415.3
EWART
2495.36
1068.30