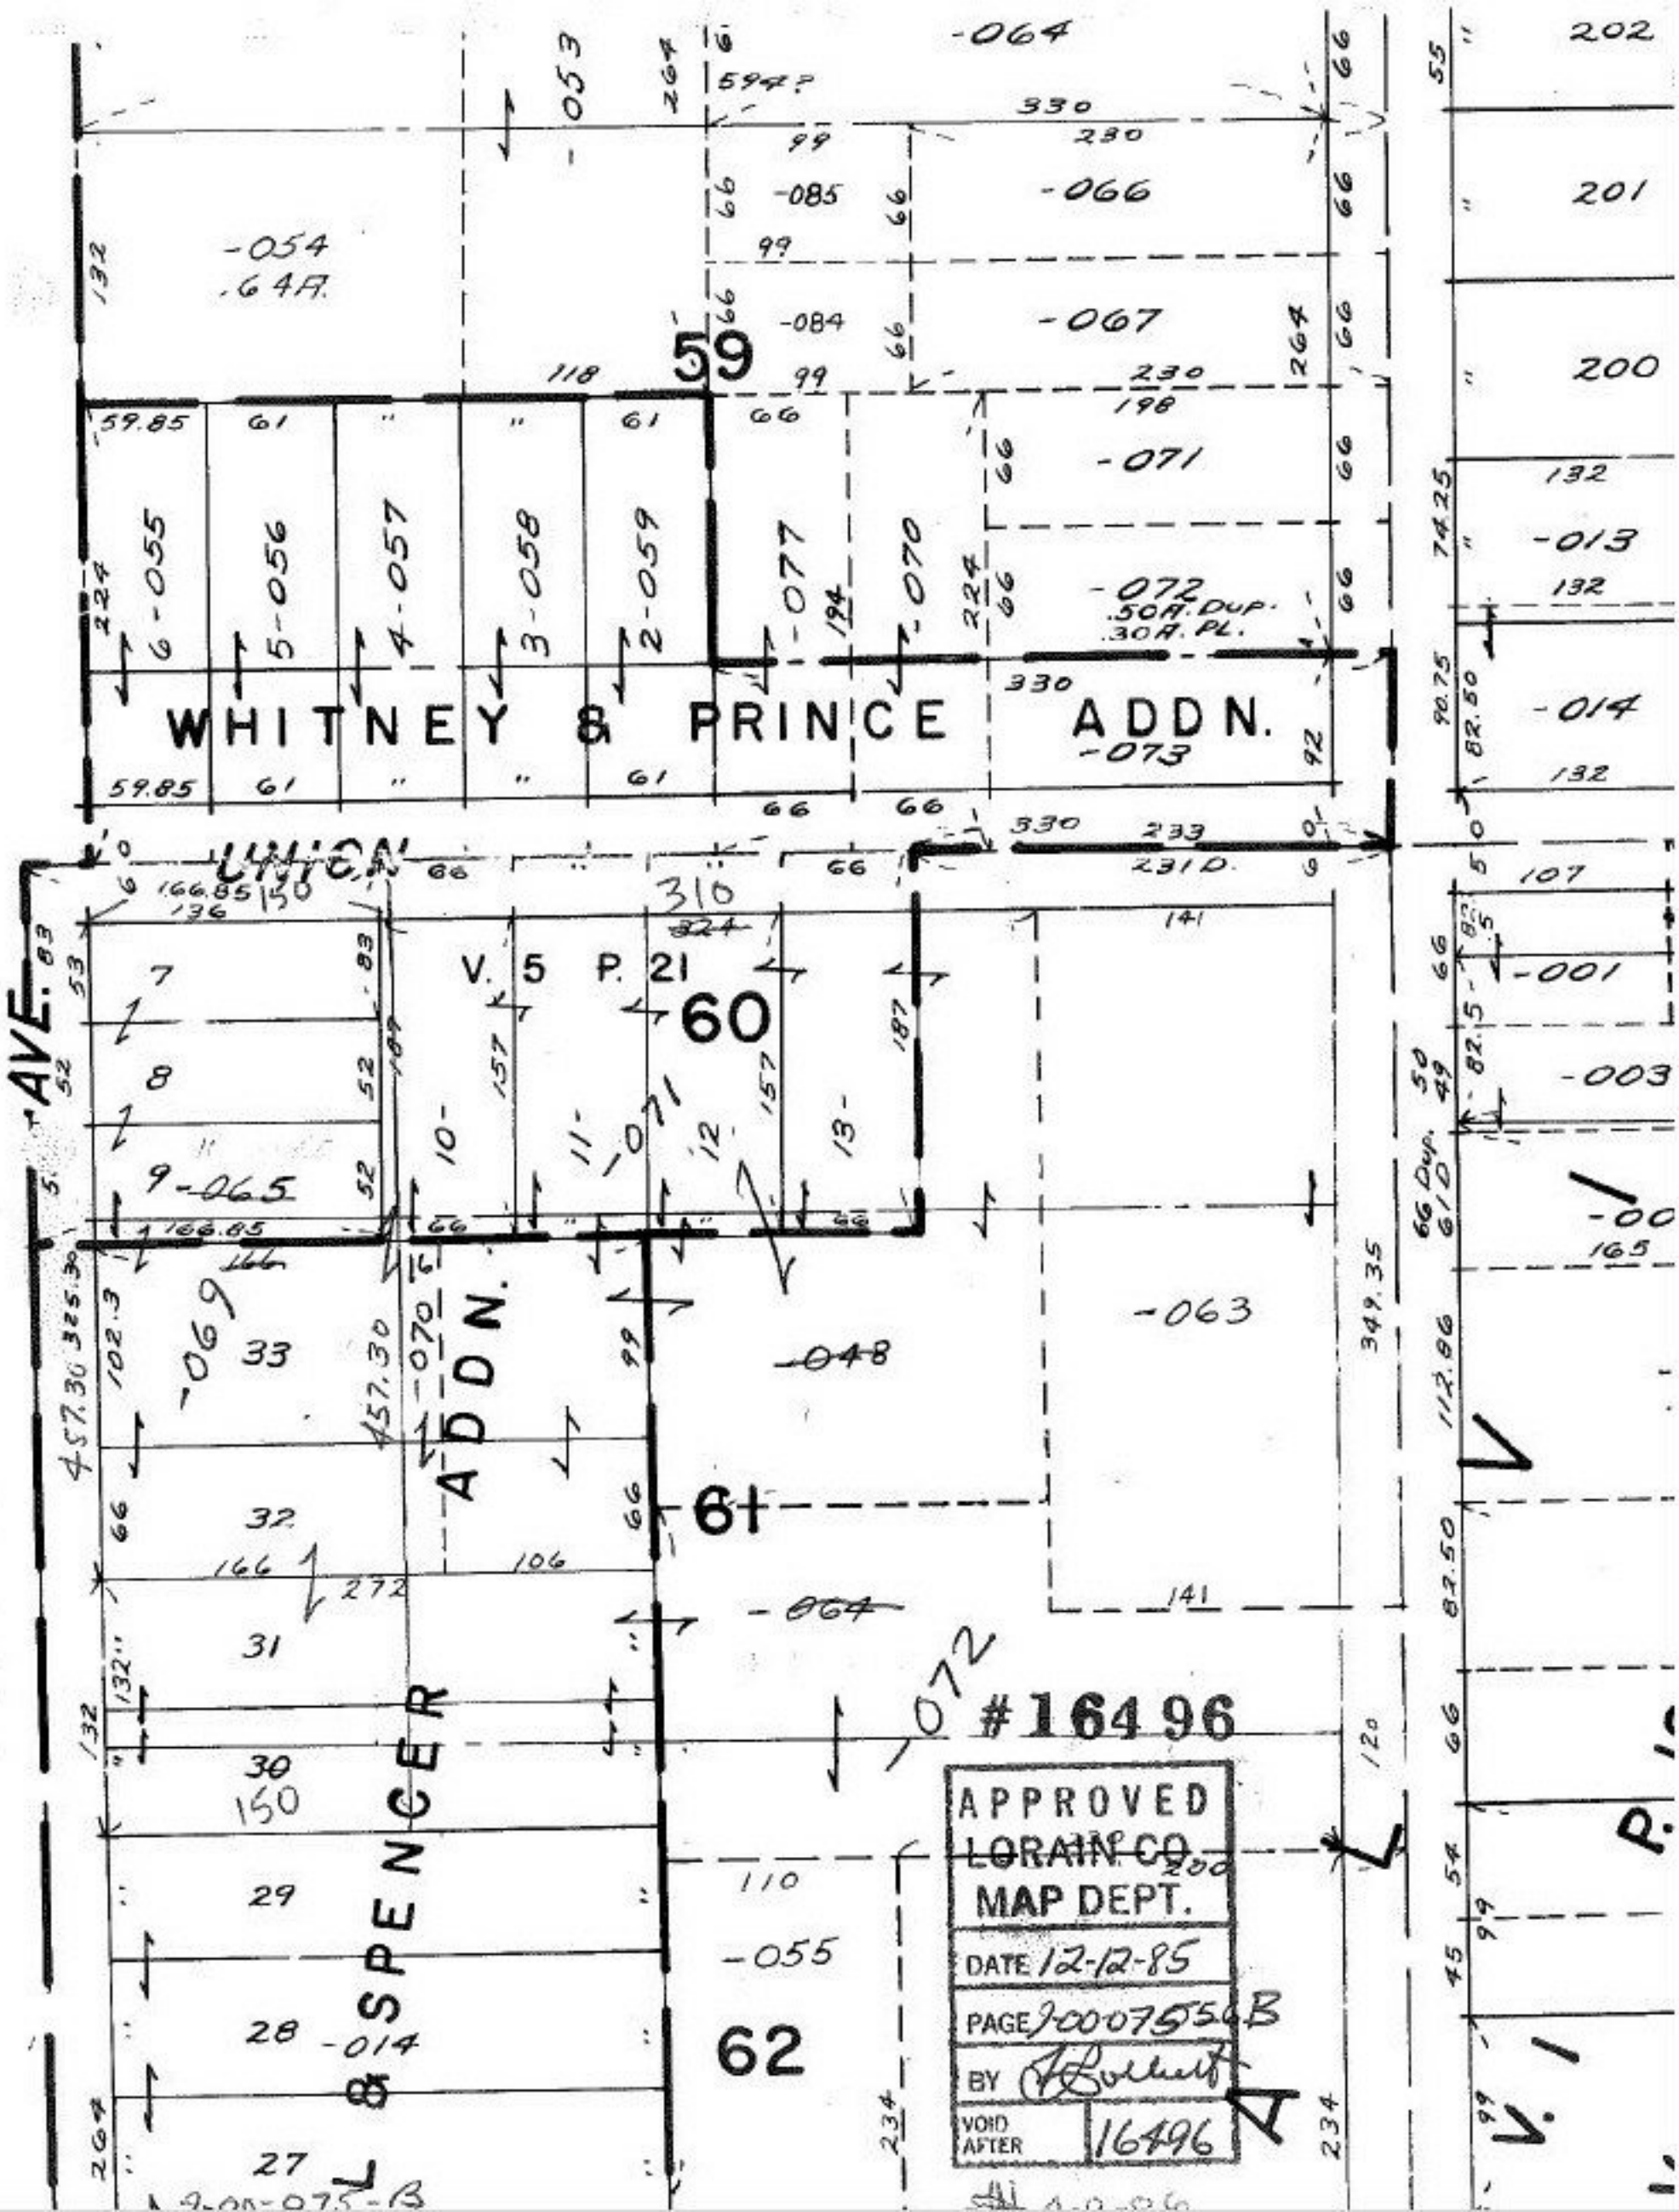

WHITNEY & PRINCE ADDN.
UNION AVE.
V. 5 P. 21
59
60
61
62
L & SPENCER ADDN.
#16496
APPROVED
LORAIN CO.
MAP DEPT.
DATE 12-12-85
PAGE 9-00075 56B
BY
VOID AFTER 16496