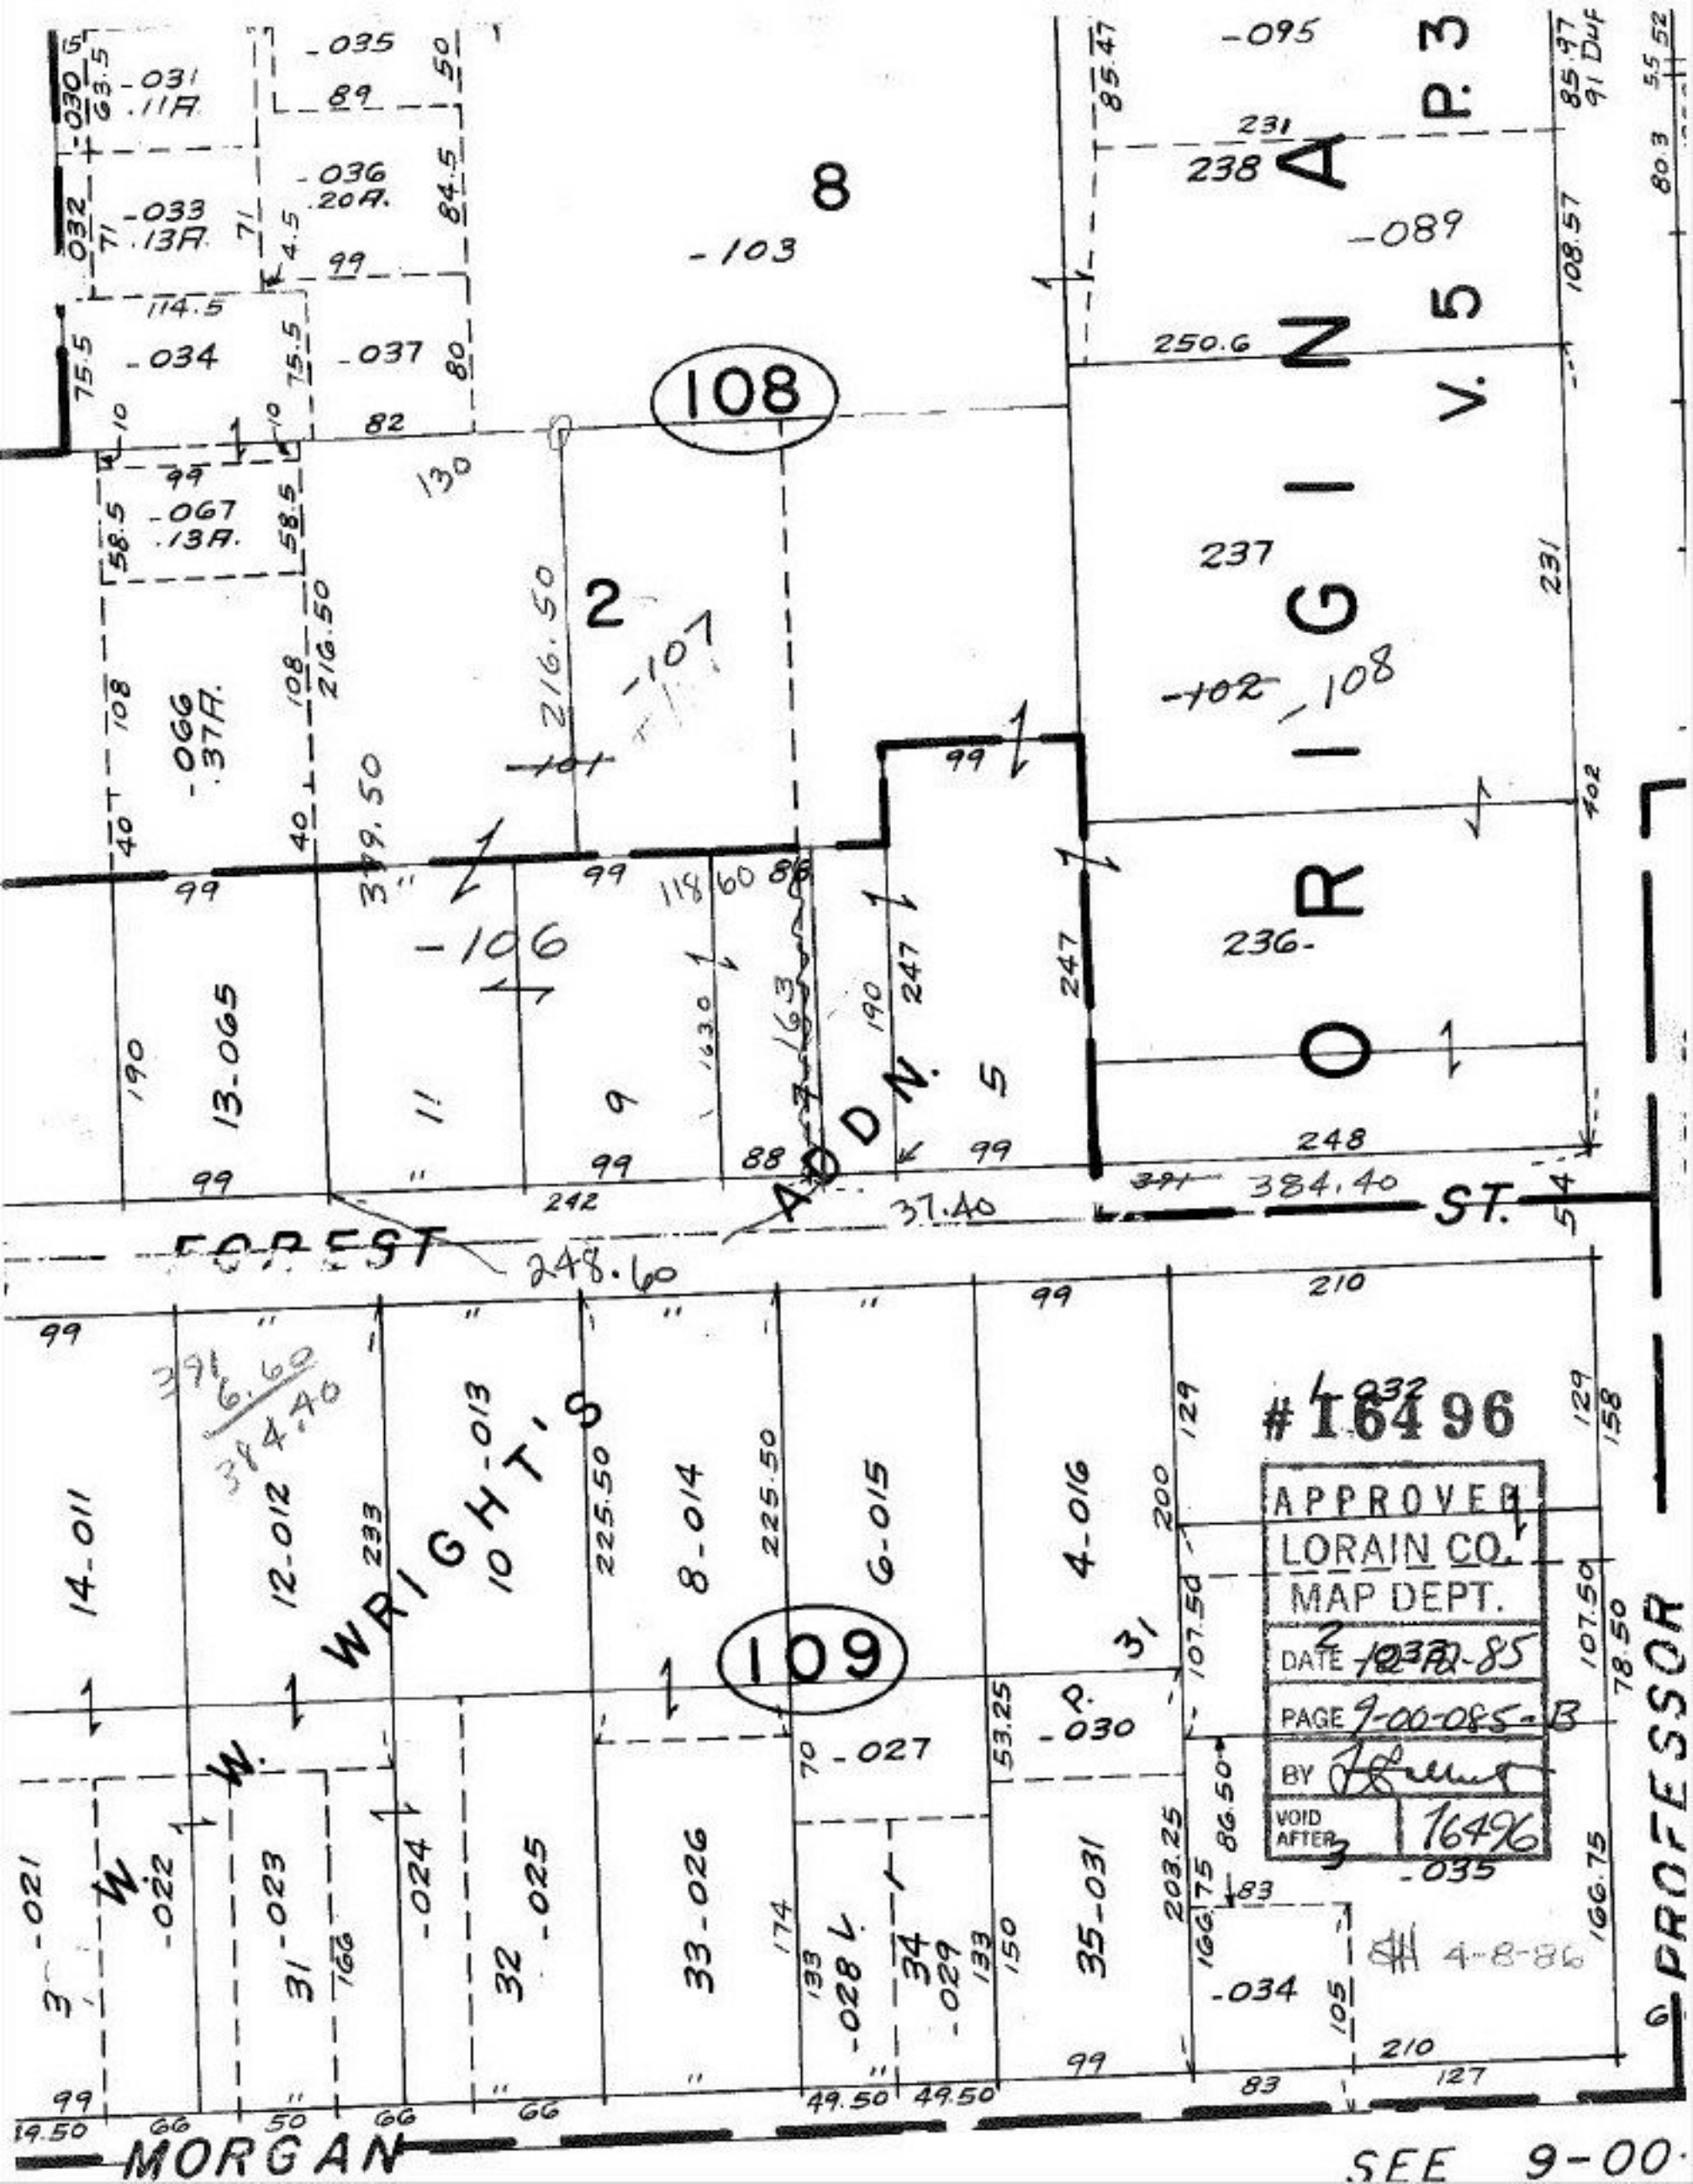
-035
89
50
-031
.11A.
-030
63.5
-036
.20A.
84.5
-033
.13A.
71
4.5
99
114.5
-034
-037
75.5
80
82
10
130
8
-103
108
-095
85.47
231
238
-089
108.57
250.6
A
P.
3
N
I
G
I
R
O
V.
5
-067
.13A.
58.5
2
216.50
-101
237
-102
-108
231
-066
.37A.
108
40
99
399.50
-106
99
118
60
86
247
236-
O
13-065
190
11
9
5
ADD'N.
99
242
37.40
88
248
384.40
ST.
FOREST
248.60
210
#16496
APPROVED
LORAIN CO.
MAP DEPT.
DATE 12-12-85
PAGE 9-00-085-B
BY
VOID AFTER 1649G
-035
-034
105
83
127
4-8-86
14-011
12-012
WRIGHT'S
10
-013
233
225.50
8-014
G-015
4-016
200
129
158
107.50
78.50
109
31
-030
53.25
70
-027
107.50
86.50
203.25
166.75
-021
-022
-023
-024
-025
33-026
-028 L.
34
-029
35-031
174
133
150
99
49.50
66
50
MORGAN
PROFESSOR
SEE 9-00