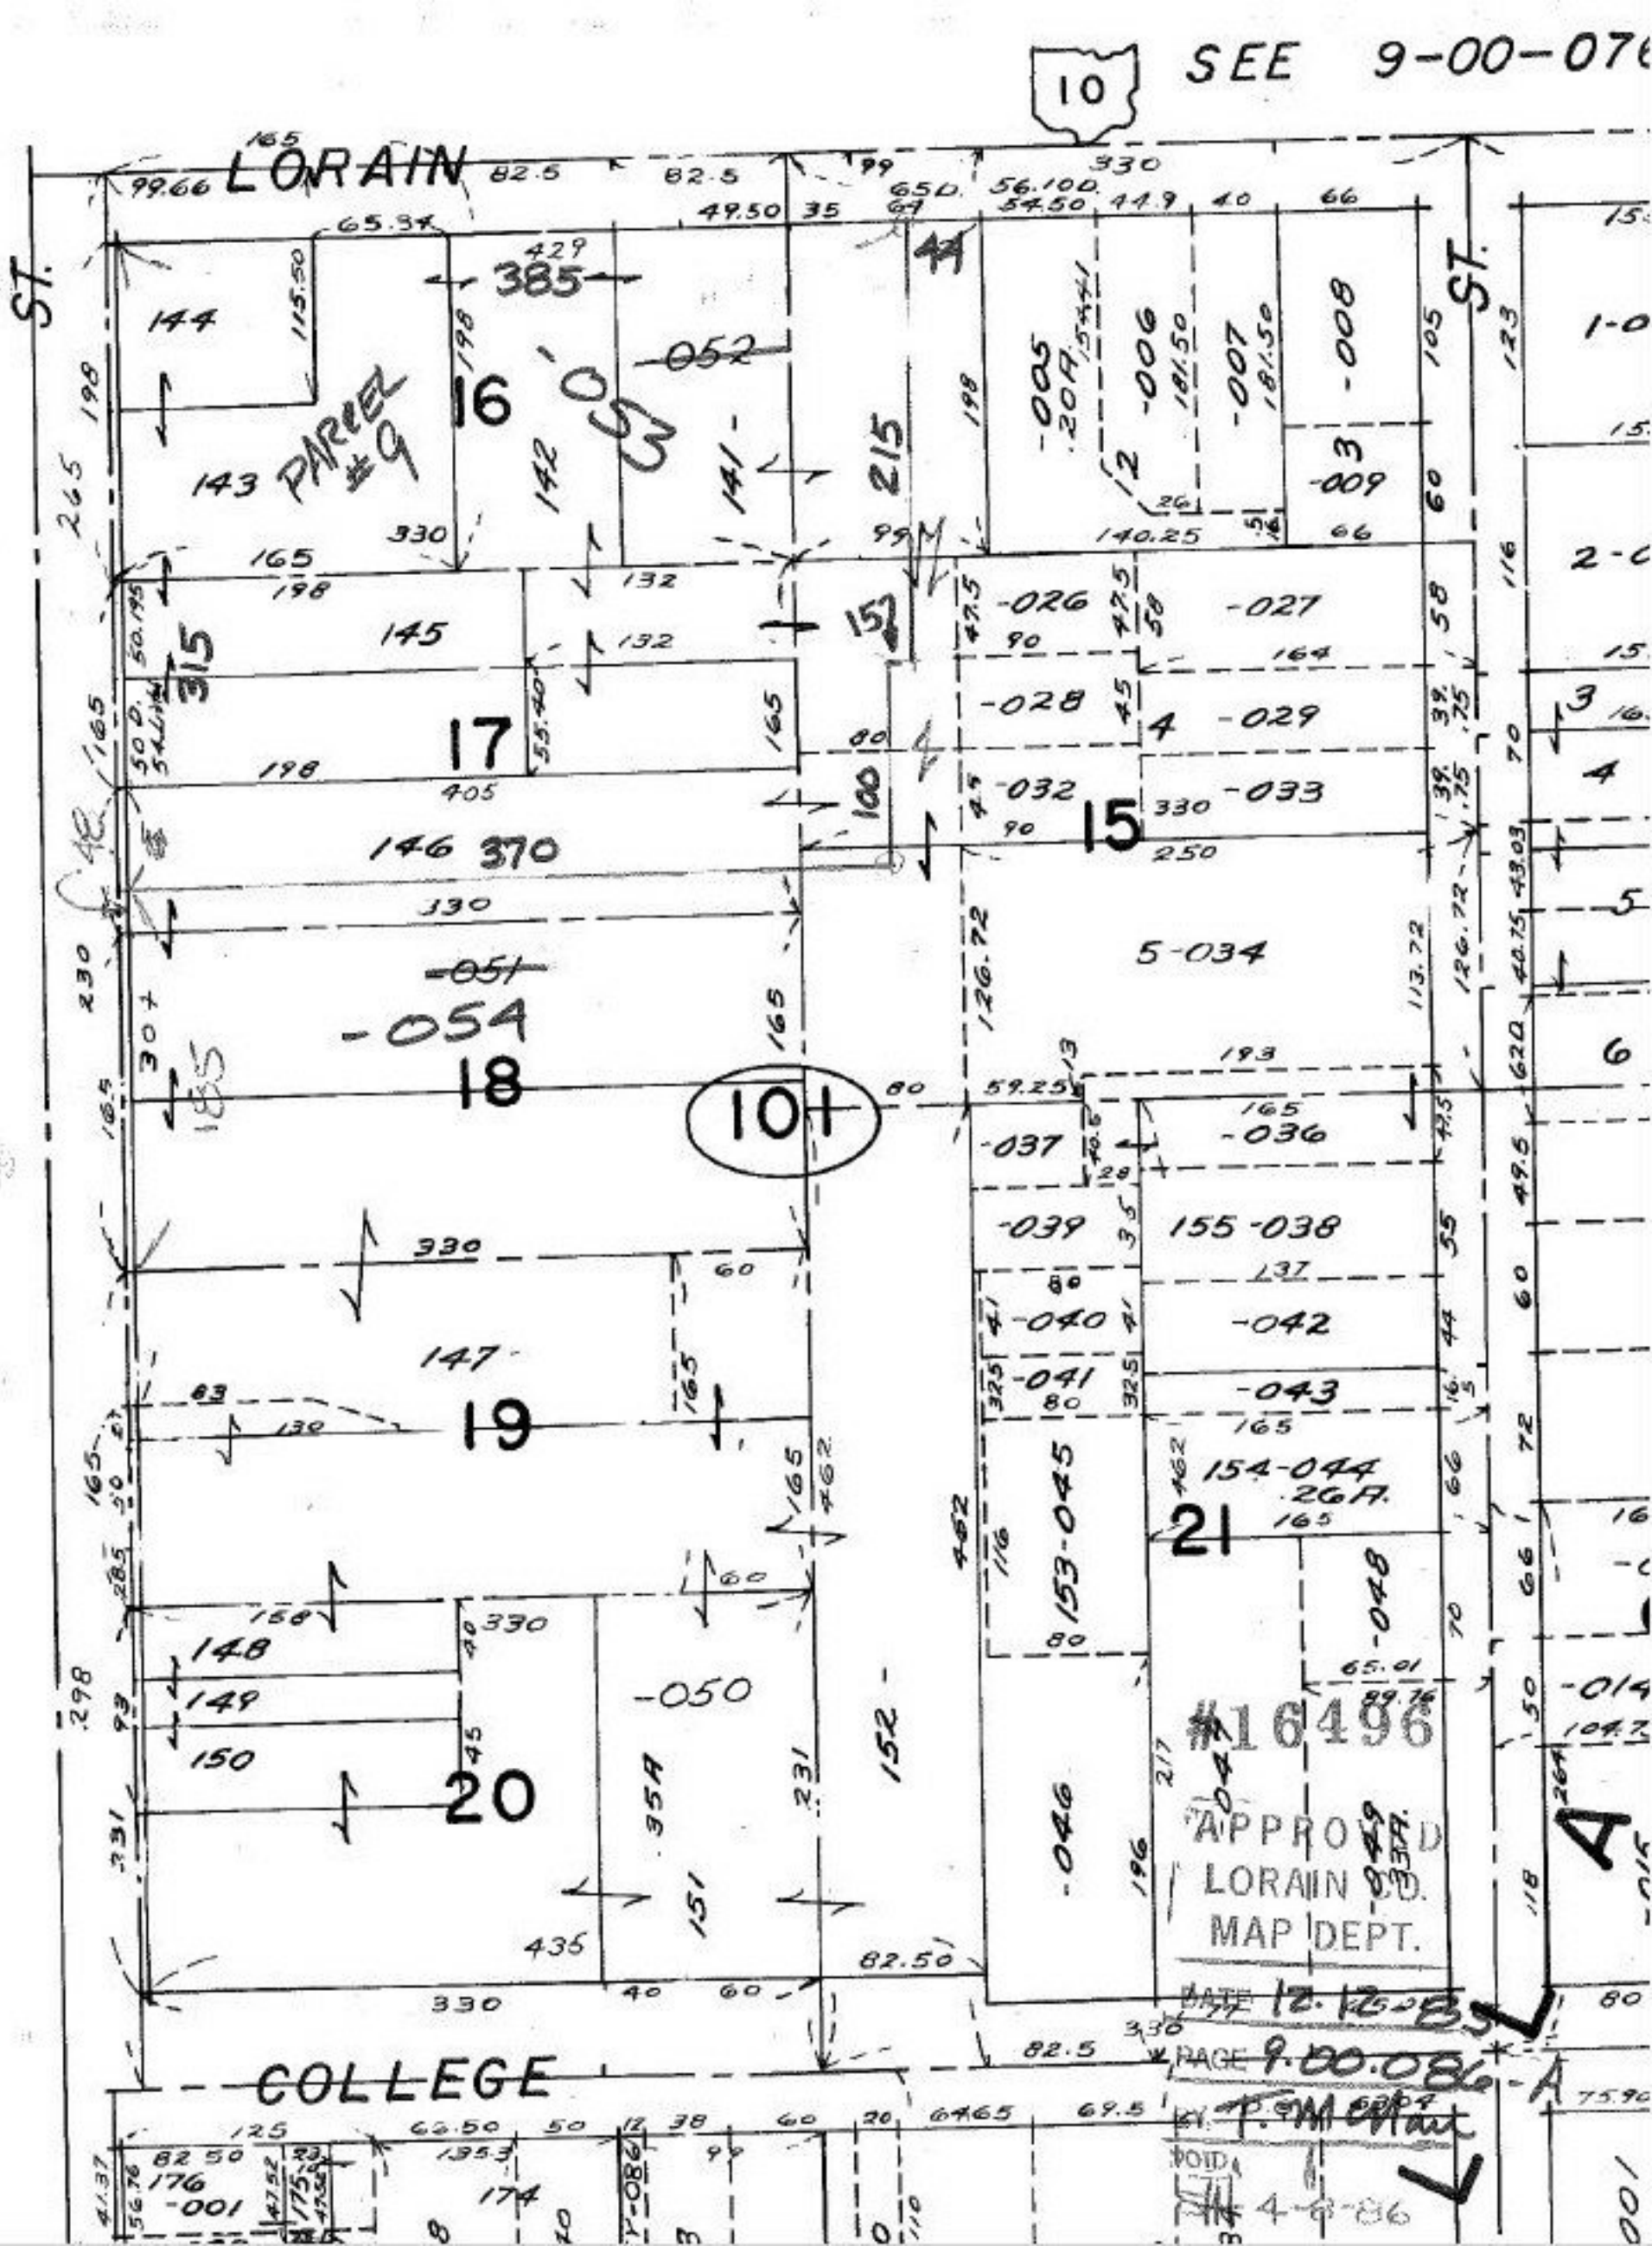

10
SEE 9-00-076
LORAIN
ST.
COLLEGE
PARCEL #9
16
17
18
19
20
21
15
101
385
-052
-053
-054
-051
-050
-005
-006
-007
-008
-009
-026
-027
-028
-029
-032
-033
5-034
-037
-036
-039
155-038
-040
-042
-041
-043
154-044
153-045
-046
-048
-049
-001
#16496
APPROVED
LORAIN CO.
MAP DEPT.
DATE 12-12-85
PAGE 9.00.086-A
BY
VOID
4-8-86