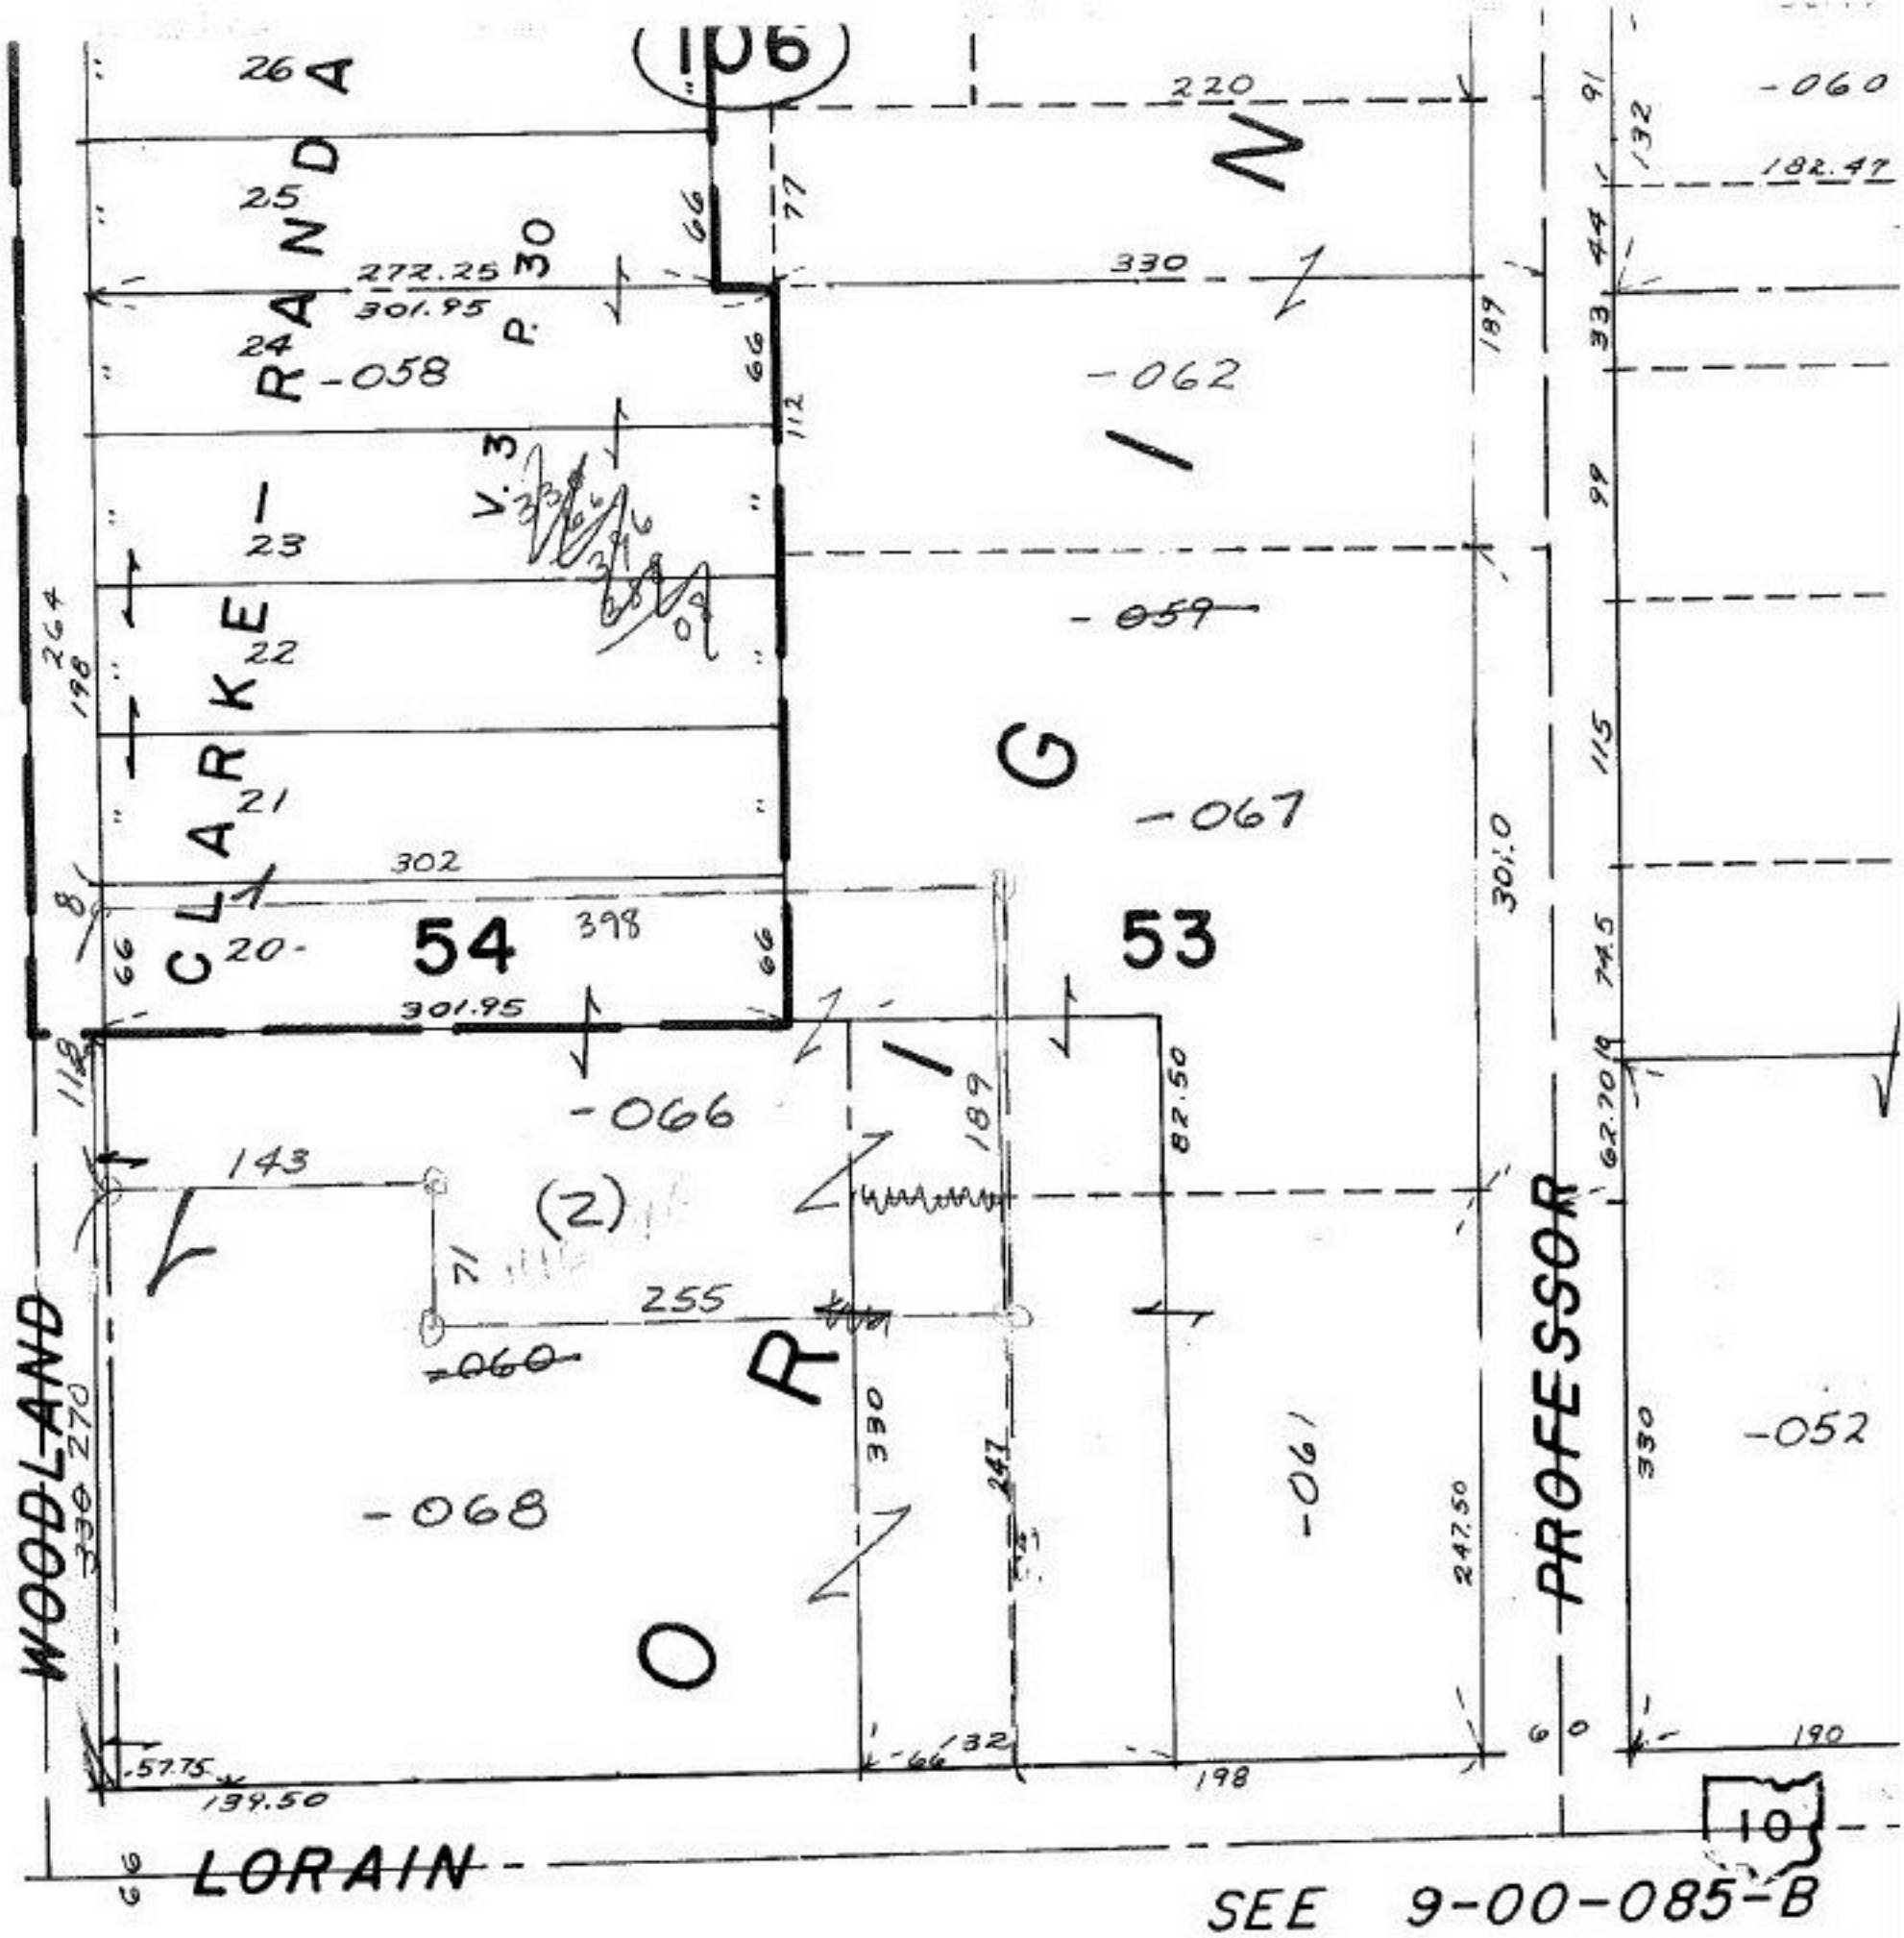

16496

APPROVED
LORAIN CO.
MAP DEPT.
DATE 12-12-85
PAGE 9-00-085-B
BY
VOID AFTER 16496

4-9-86

RUSSIA TWP.

SCALE: 1" = 100'