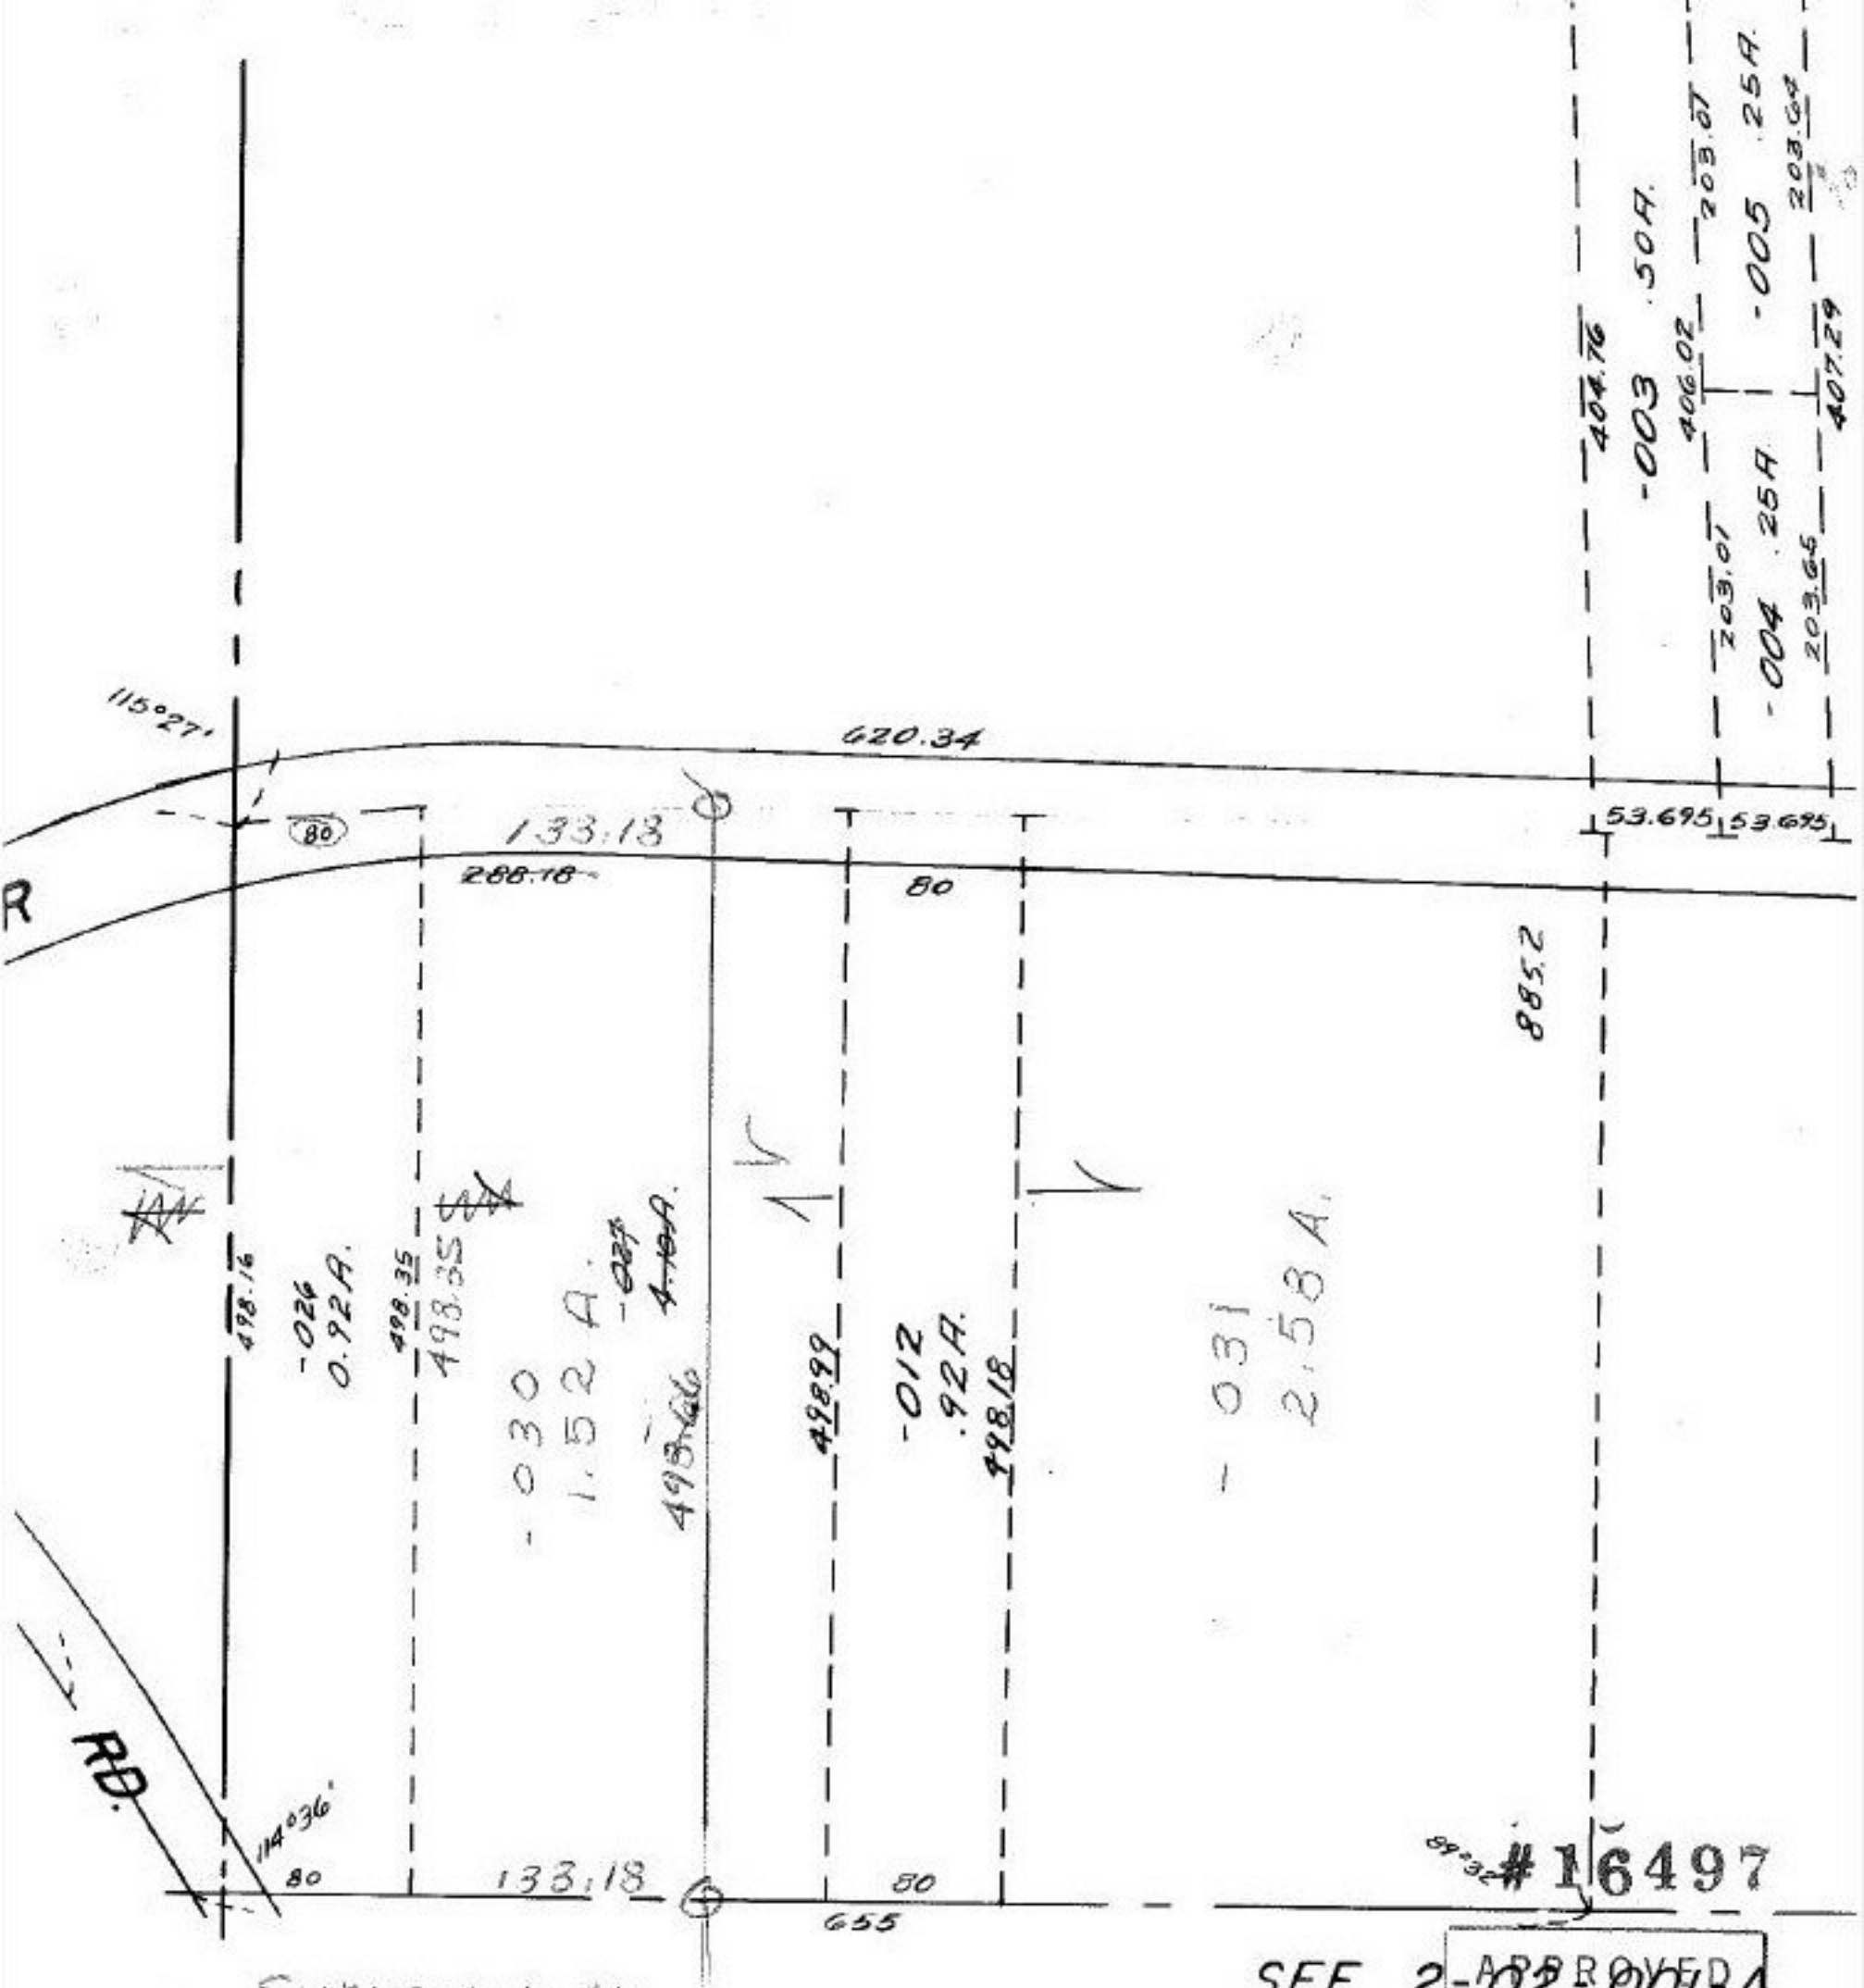

#16497

SEE 2-02-001-A

Surveyed by
William B. Barton
Reg. Surveyor 4438 11/7/85
C=1:INF.
P.D. R.1135/934

APPROVED
LORAIN CO.
MAP DEPT.
DATE 12-11-85
PAGE 2-02-010-A
BY C. Francis
VOID AFTER