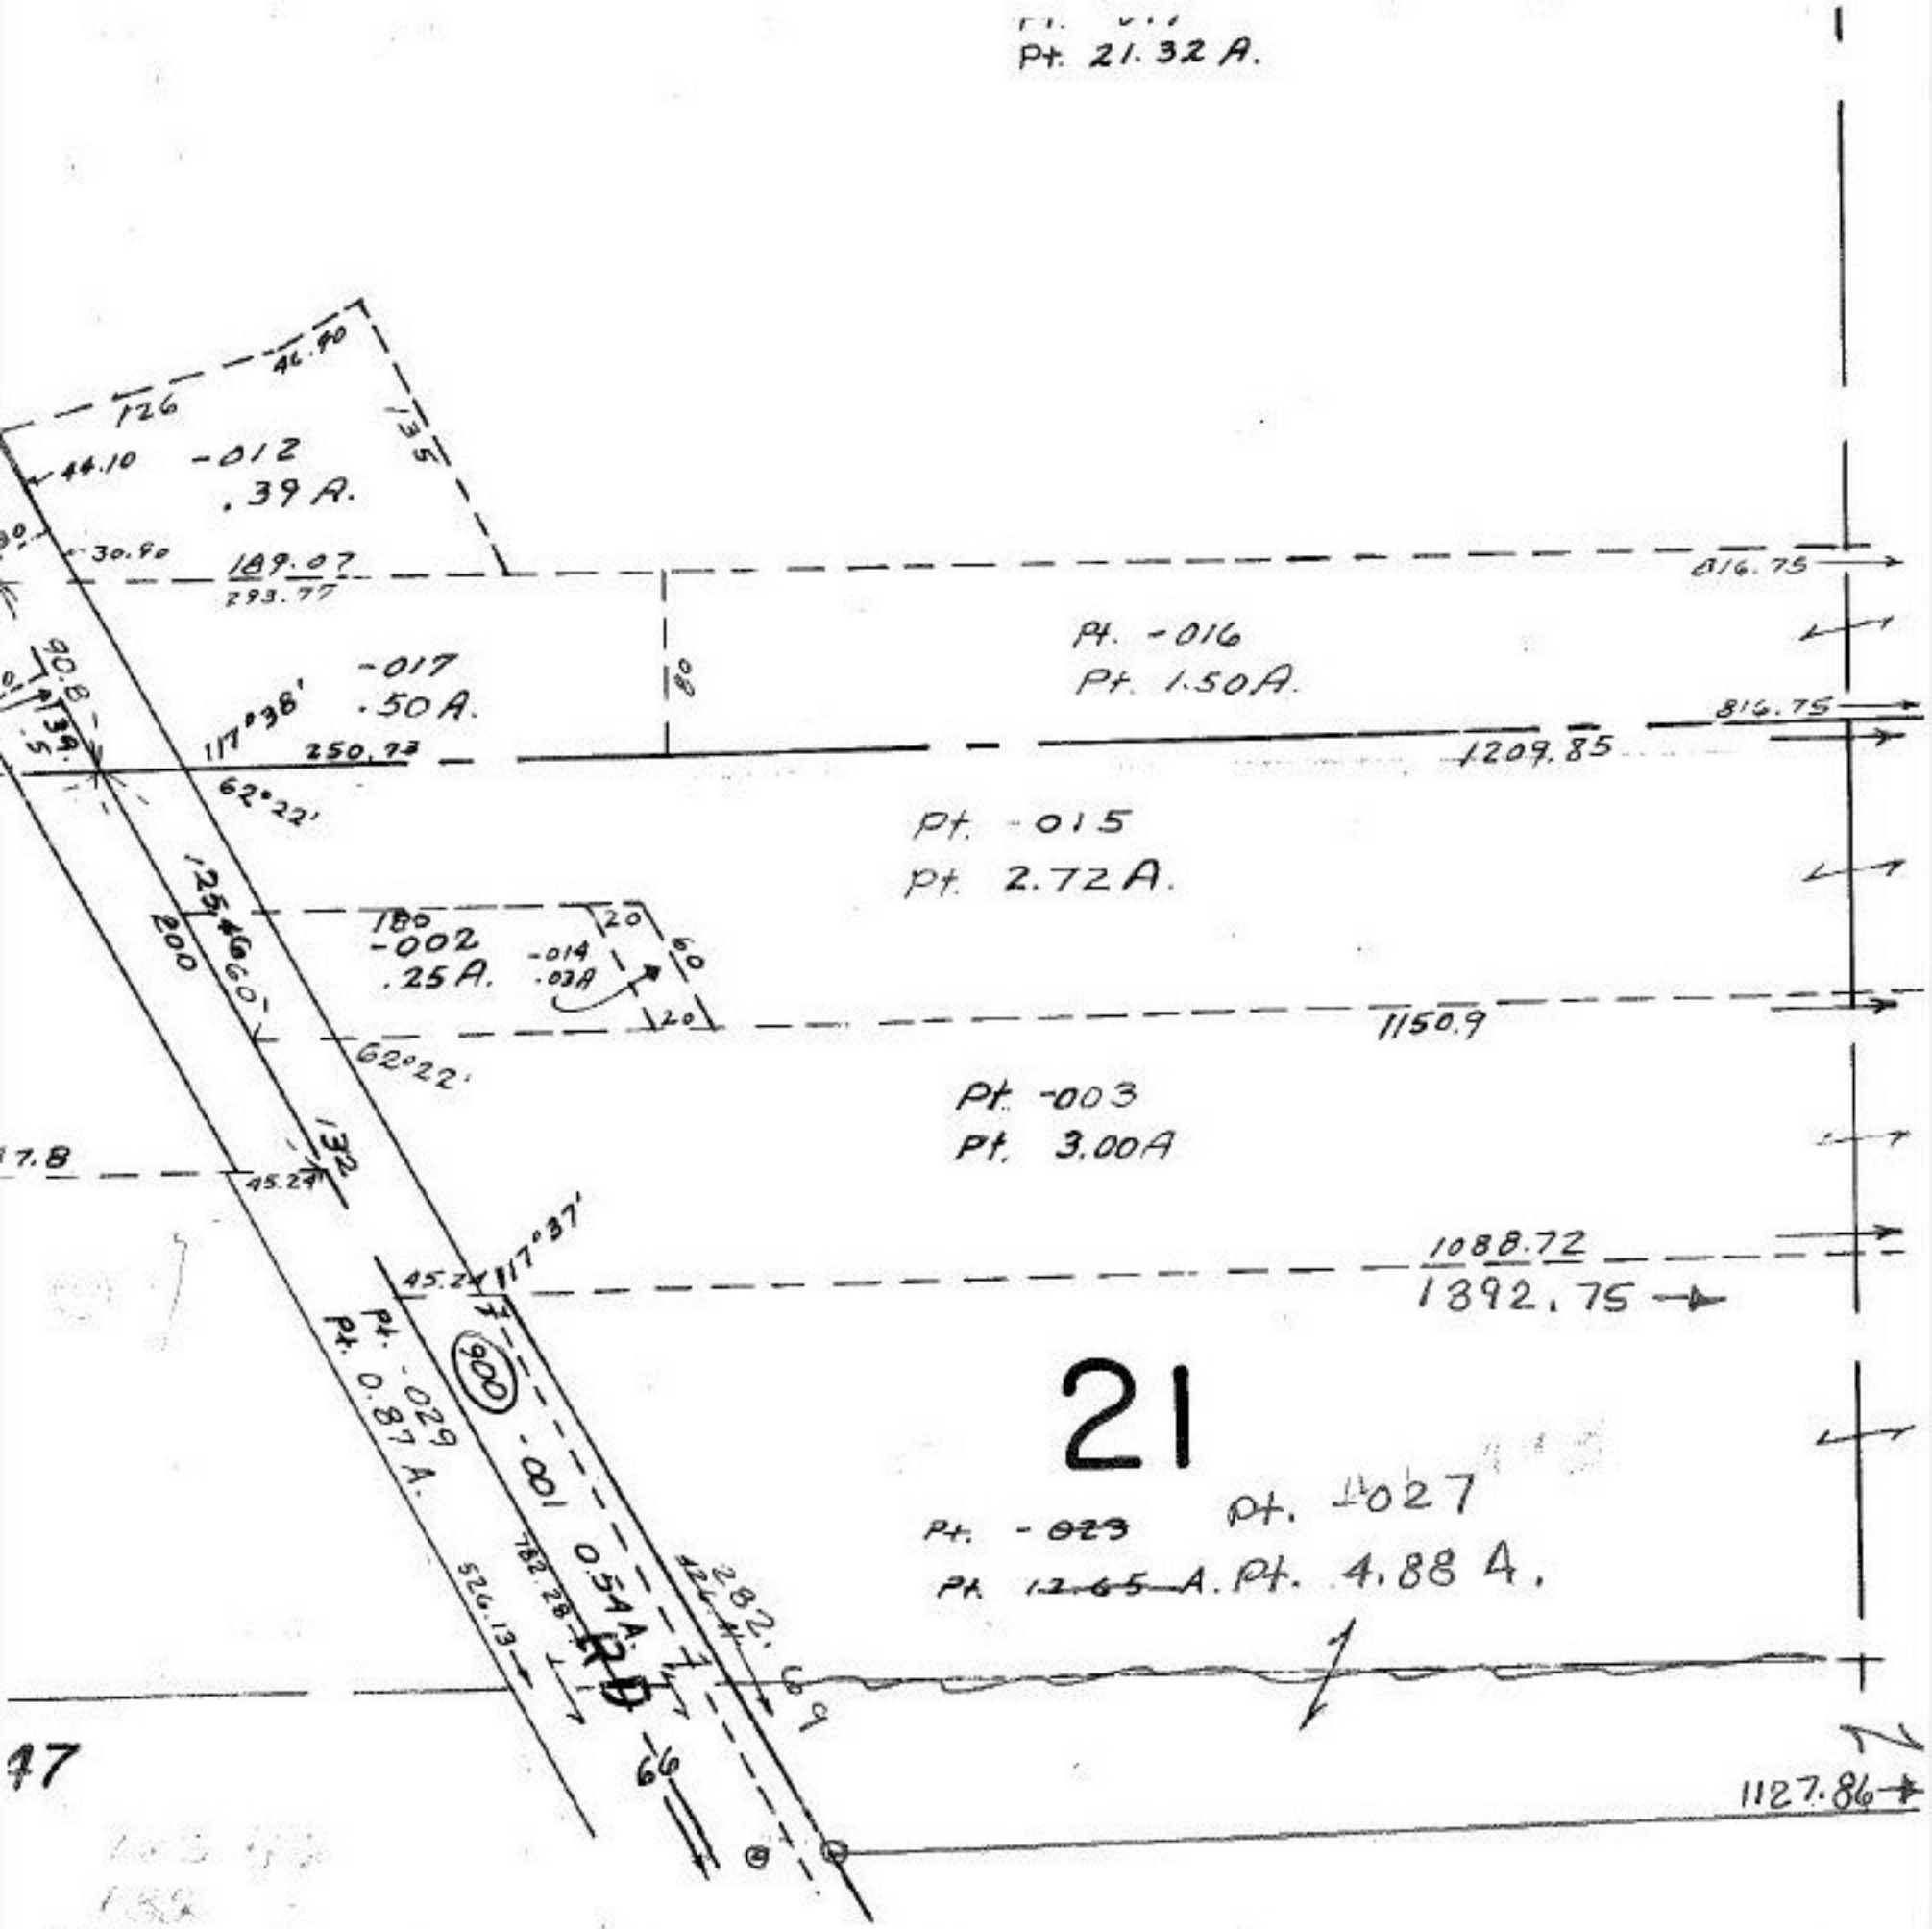

ELYRIA

SCALE 1" = 100'

#16498
APPROVED
LORAIN CO.
MAP DEPT.
DATE 12-11-85
PAGE 6-29
BY C. FRANCIS
VOID AFTER