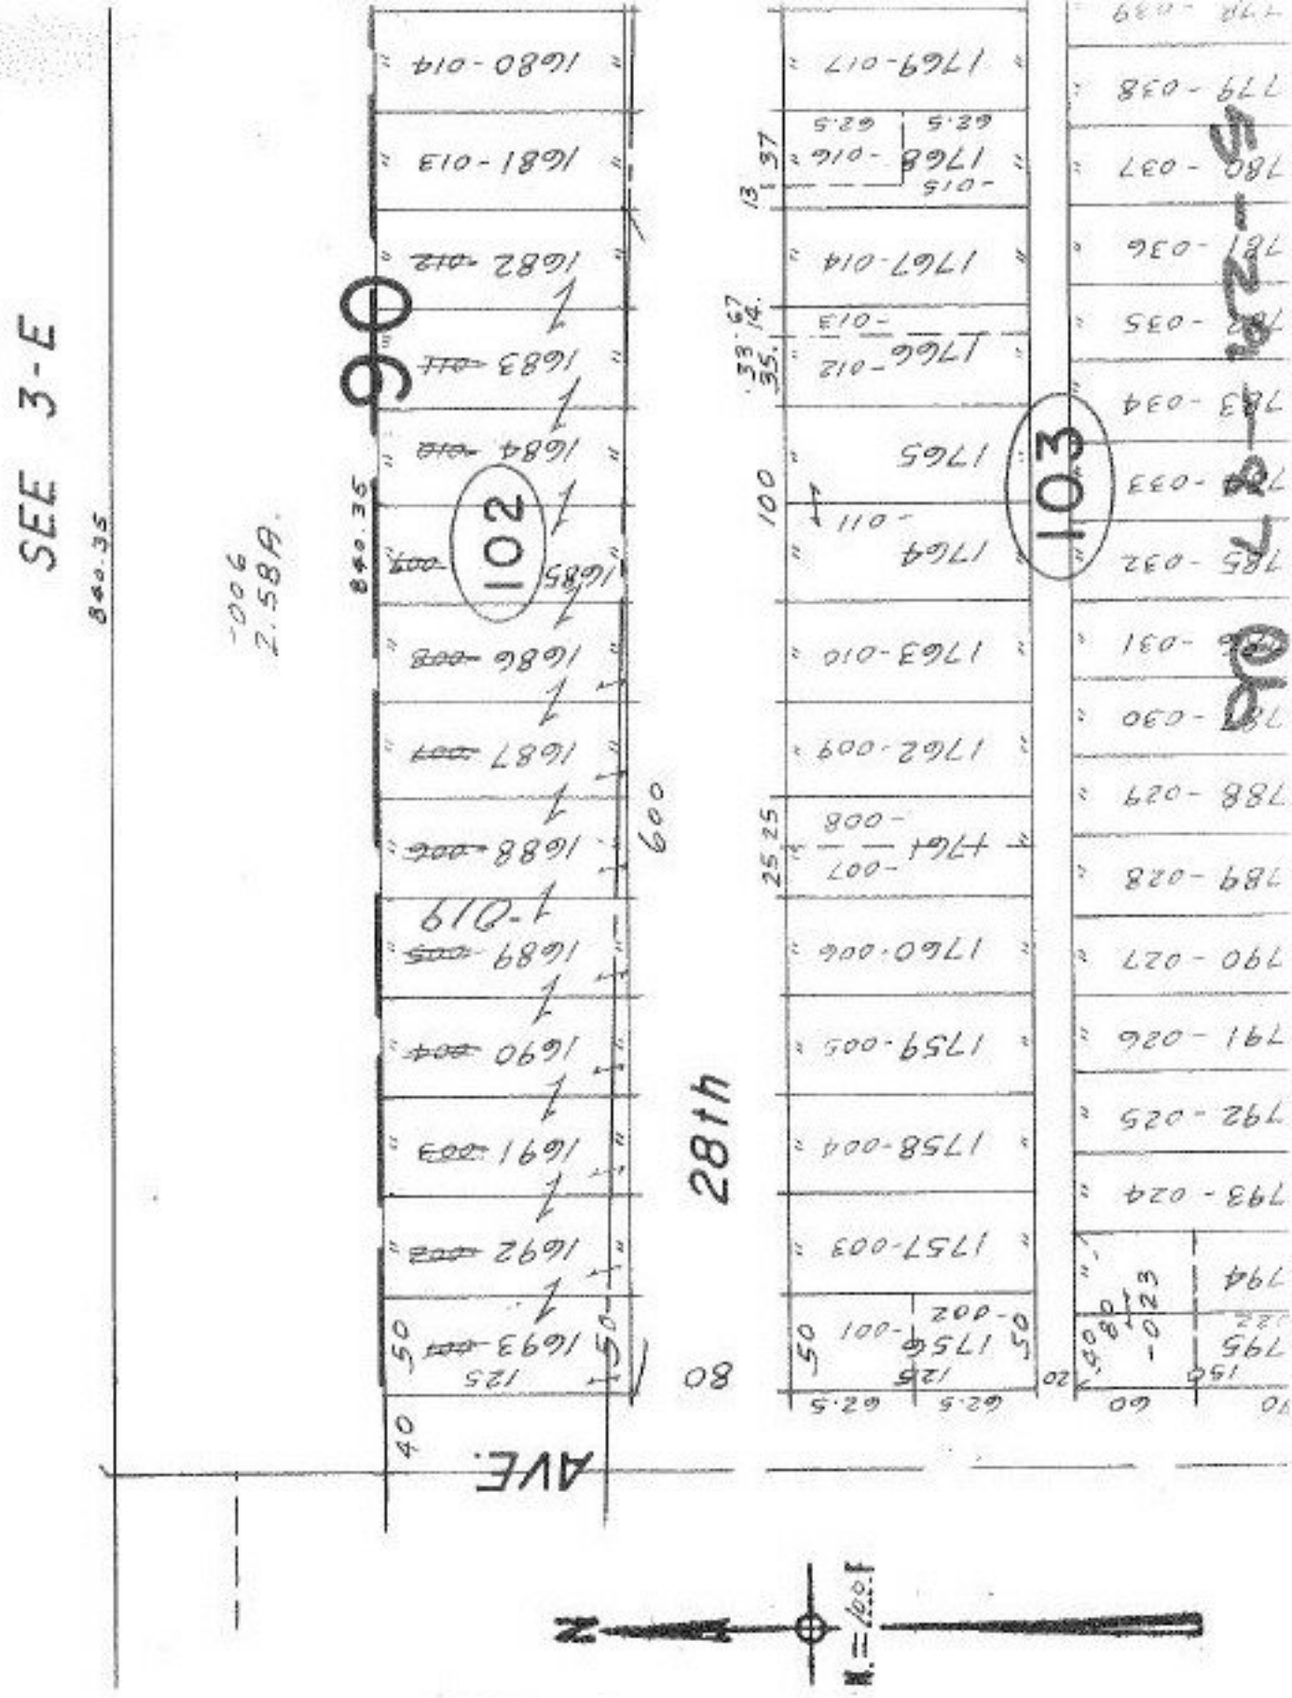

Done 5-4-68 LW Hall