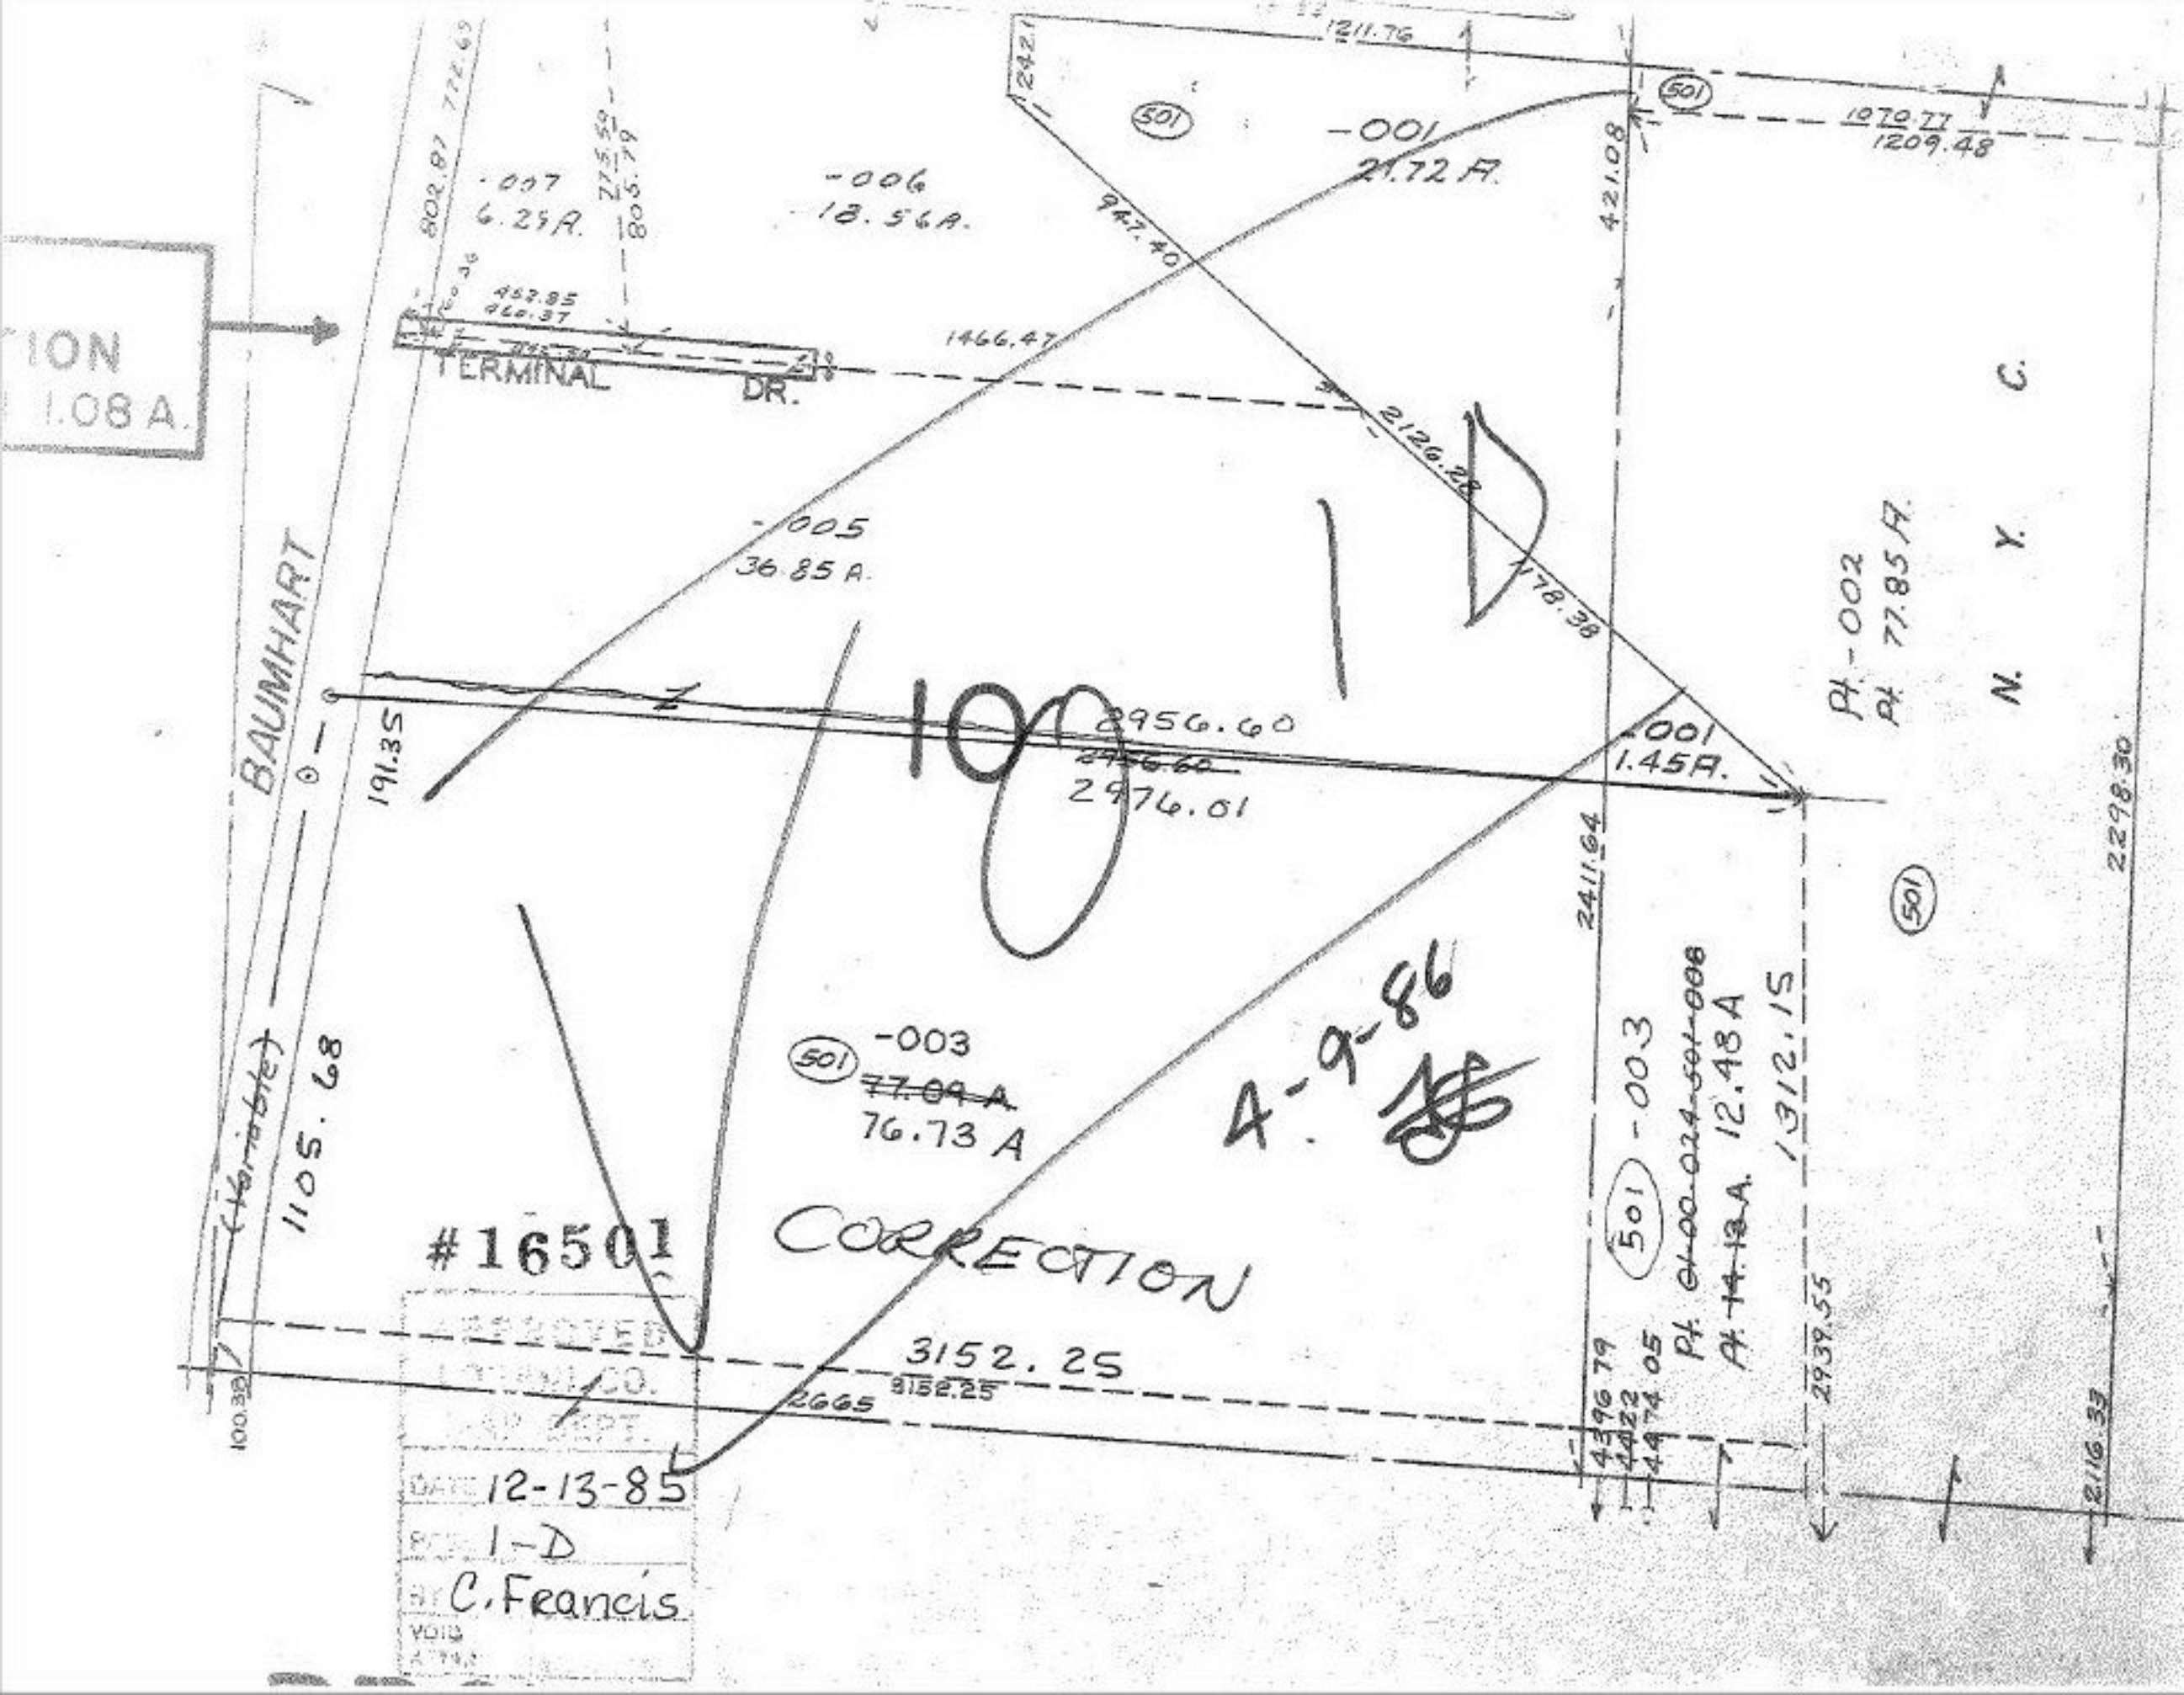

TION
1.08 A.
TERMINAL DR.
BAUMHART
-007
6.29 A.
-006
18.56 A.
-001
21.72 A.
-005
36.85 A.
-001
1.45 A.
-003
~~77.09 A.~~
76.73 A
-003
12.48 A
1312.15
1105.68
3152.25
2665
2956.60
2976.01
1466.47
947.40
2126.28
1178.38
1211.76
1070.77
1209.48
421.08
2411.64
2298.30
2939.55
2116.33
191.35
100.38
N. Y. C.
Pt. -002
Pt. 77.85 A.
4-9-86
CORRECTION
#16501
APPROVED
DATE 12-13-85
1-D
BY C. Francis
VOID