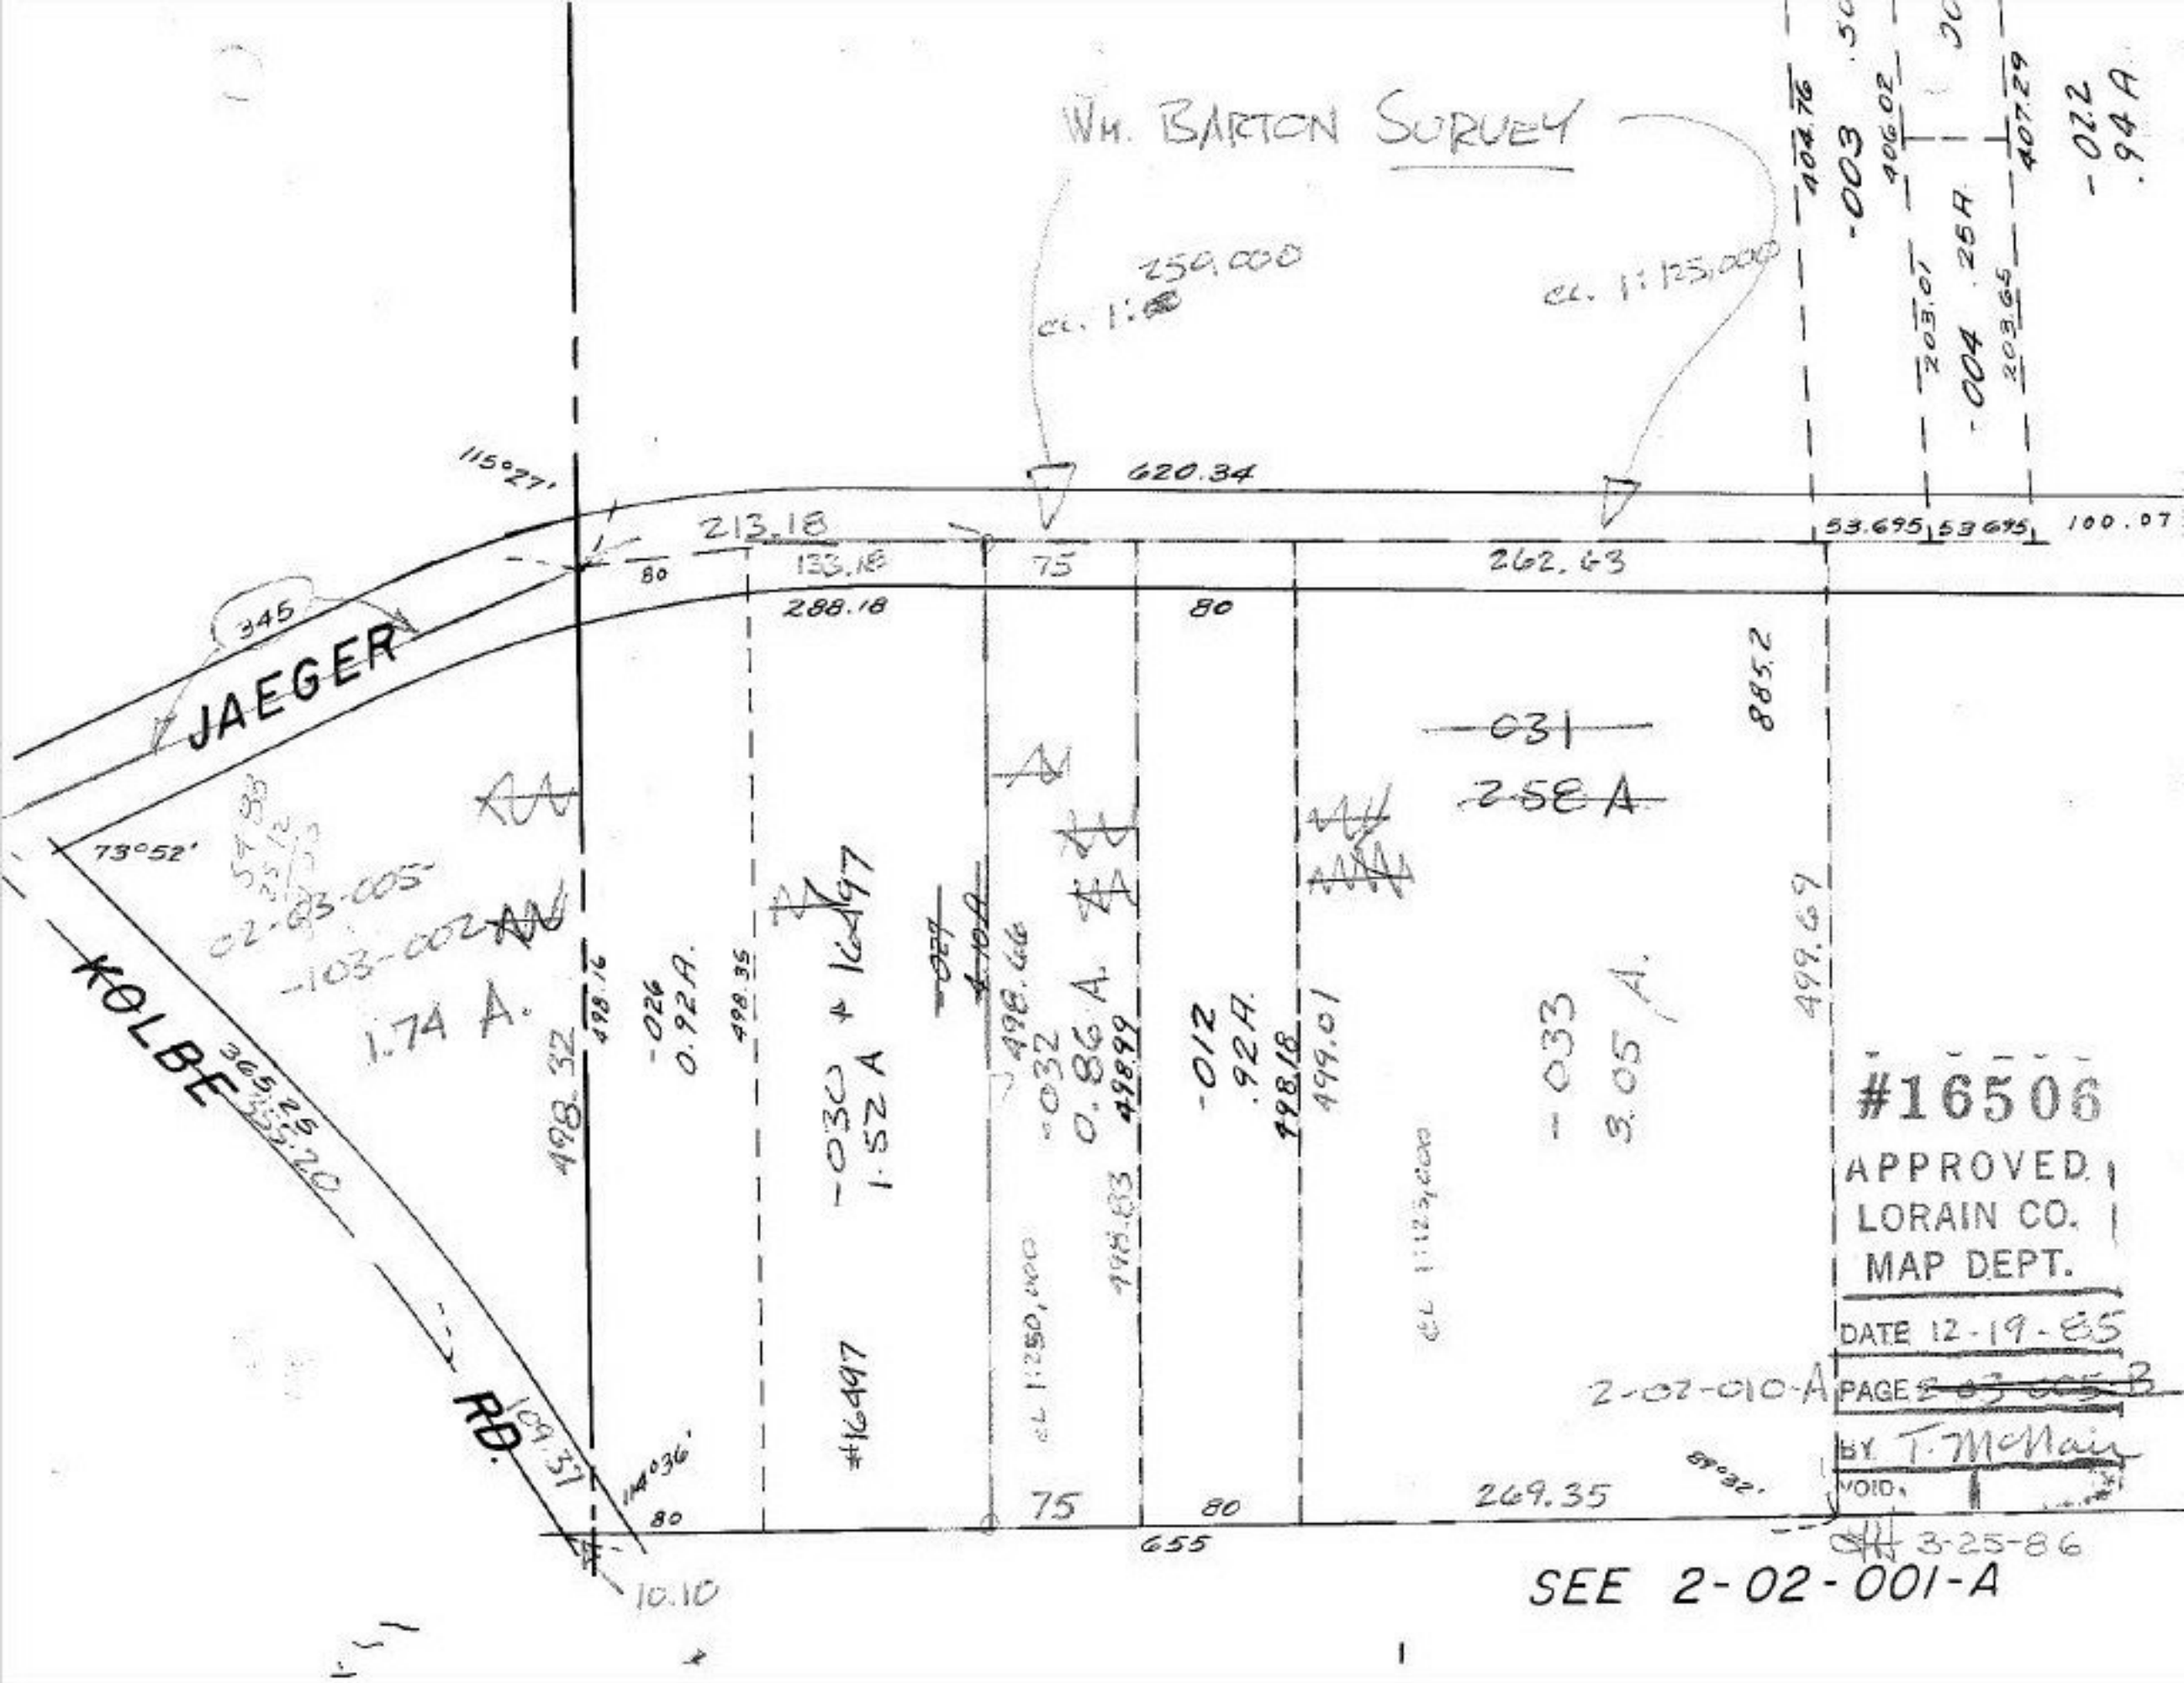

WM. BARTON SURVEY
JAEGER
KOLBE
RD.
345
73°52'
115°27'
114°36'
89°32'
620.34
213.18
133.18
288.18
262.63
53.695
53.695
100.07
885.2
499.69
498.32
498.16
498.35
498.66
498.99
498.83
499.01
498.18
269.35
655
80
75
-026
0.92A.
-030
1.52 A
16497
#16497
-032
0.86 A.
-012
.92A.
-033
3.05 A.
-031
2.58 A
-003
-004
-02.2
.94 A
-02-03-005
-103-002
1.74 A.
2-02-010-A
10.10
#16506
APPROVED
LORAIN CO.
MAP DEPT.
DATE 12-19-85
PAGE
BY T. McNair
VOID
3-25-86
SEE 2-02-001-A