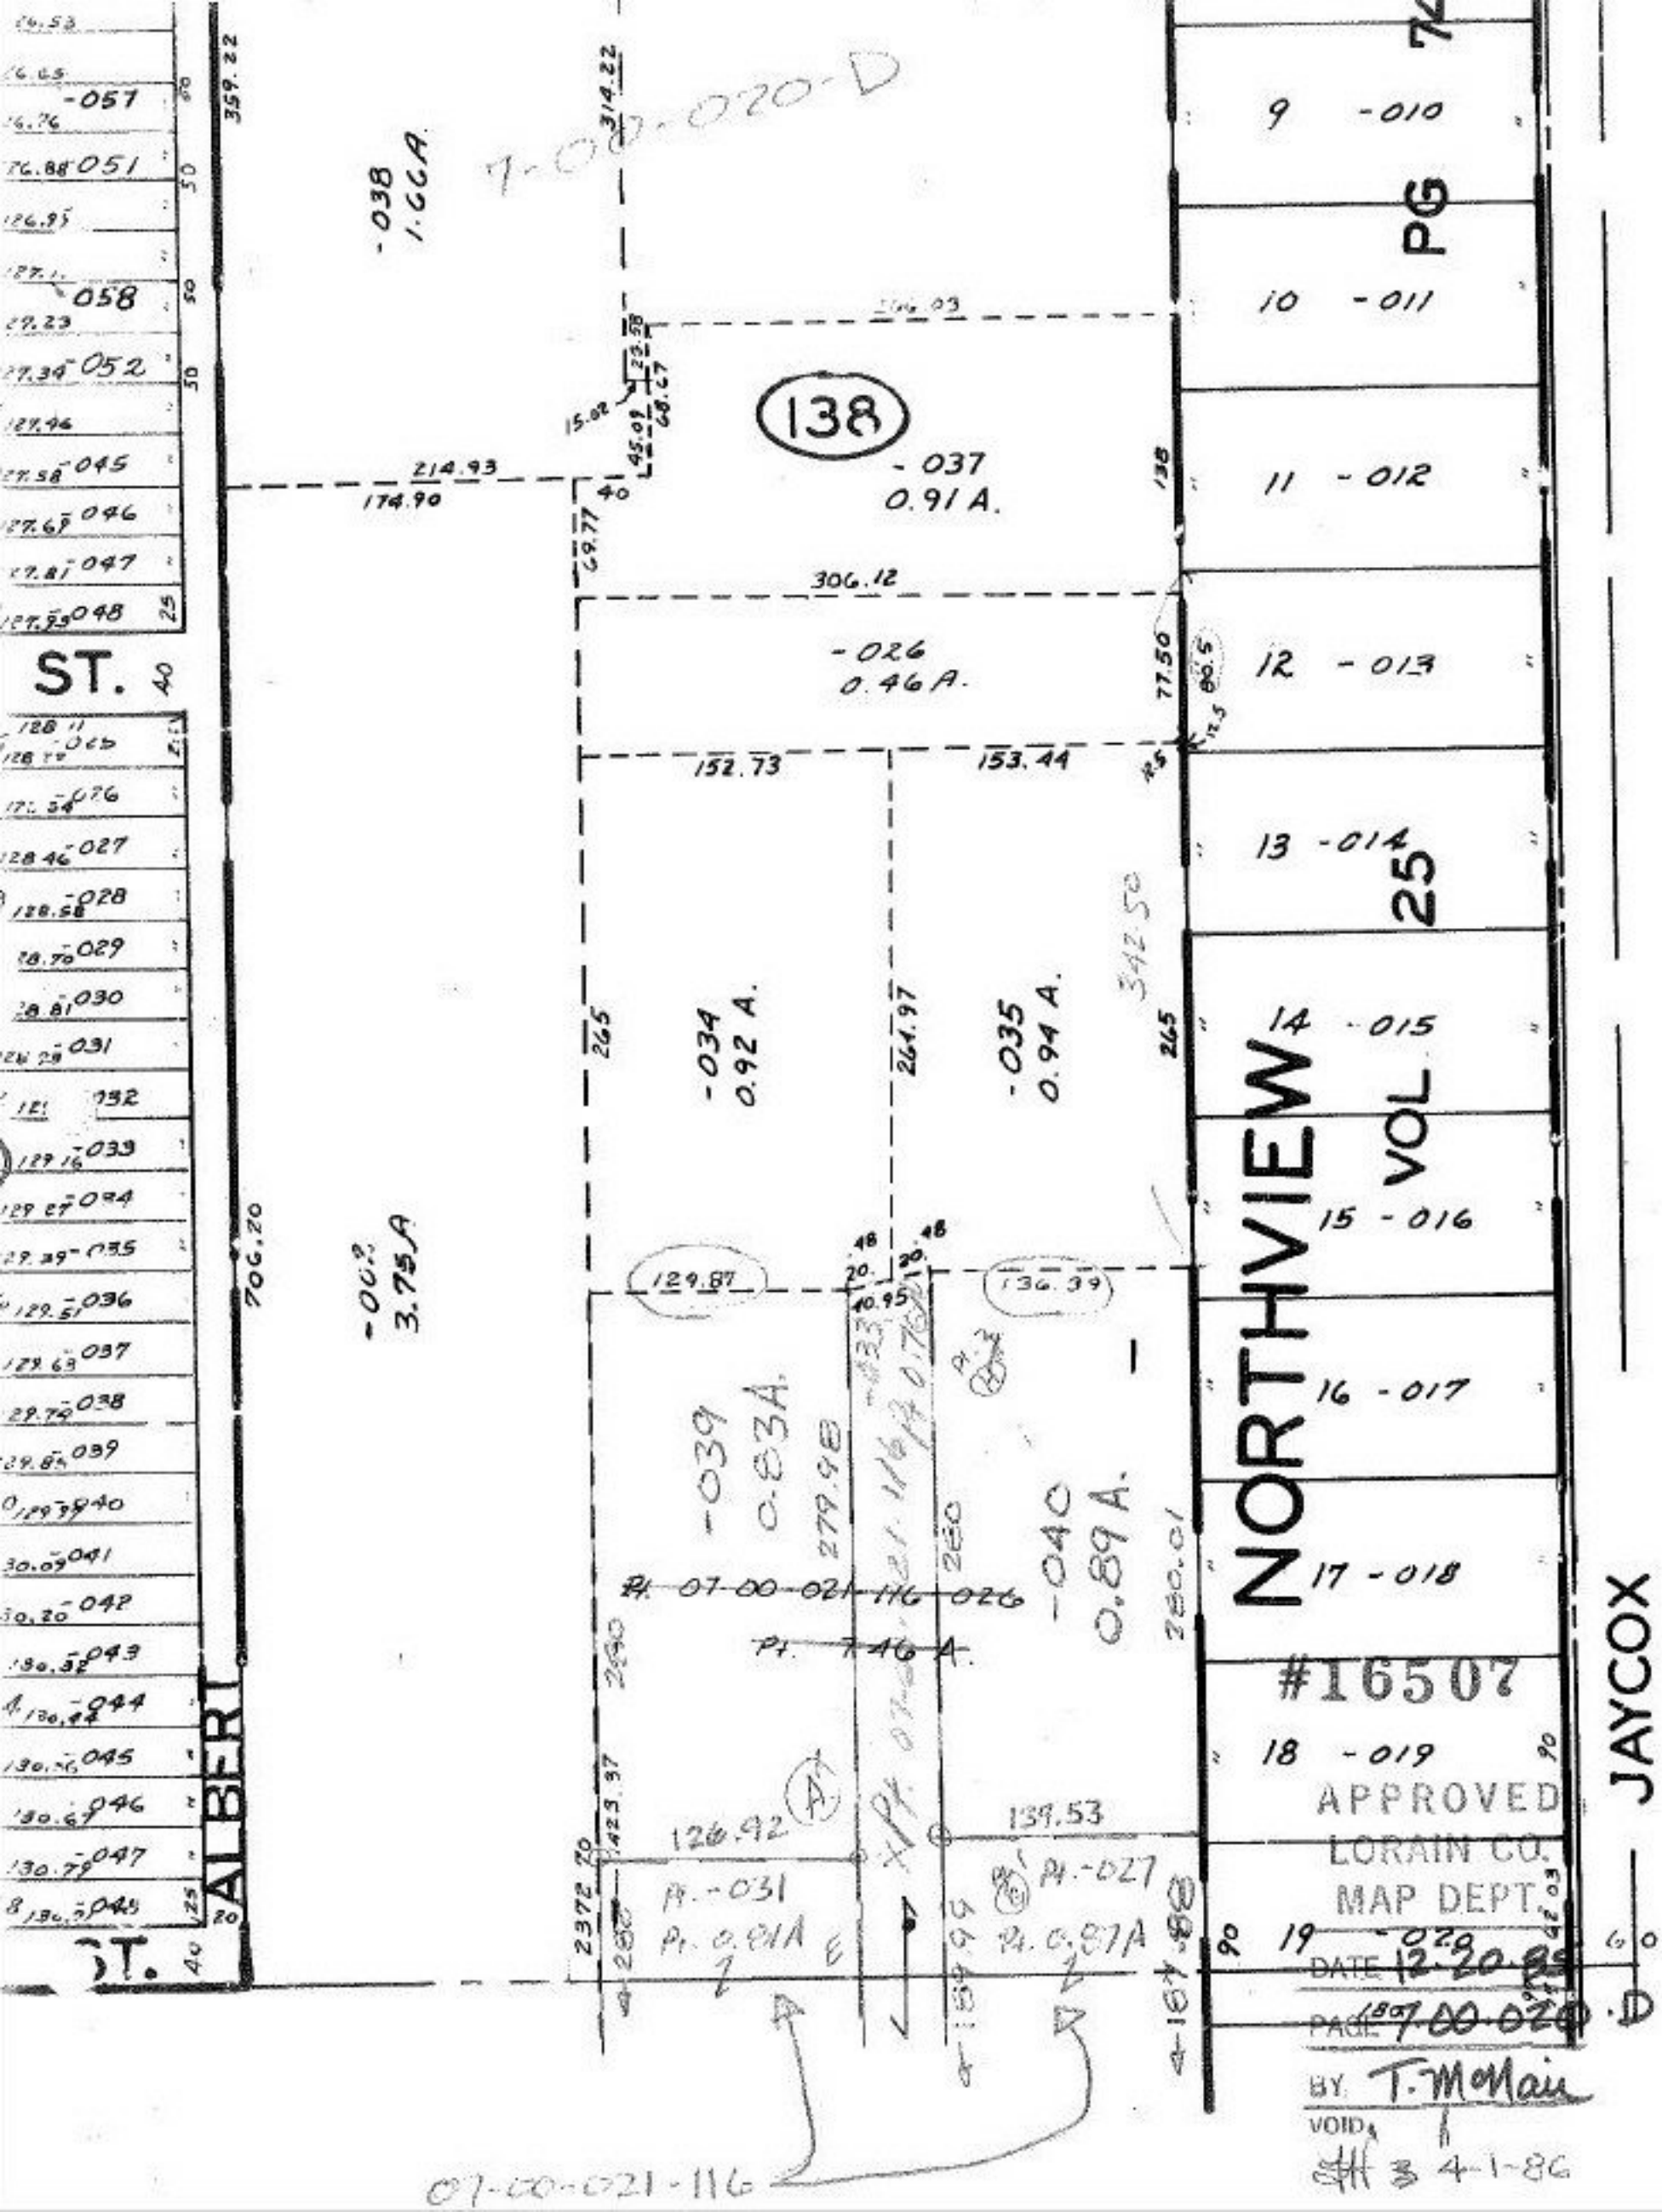

#16507

APPROVED
LORAIN CO.
MAP DEPT.
DATE 12-20-85
PAGE 7-00-020-D
BY T. McNair
VOID
4-1-86