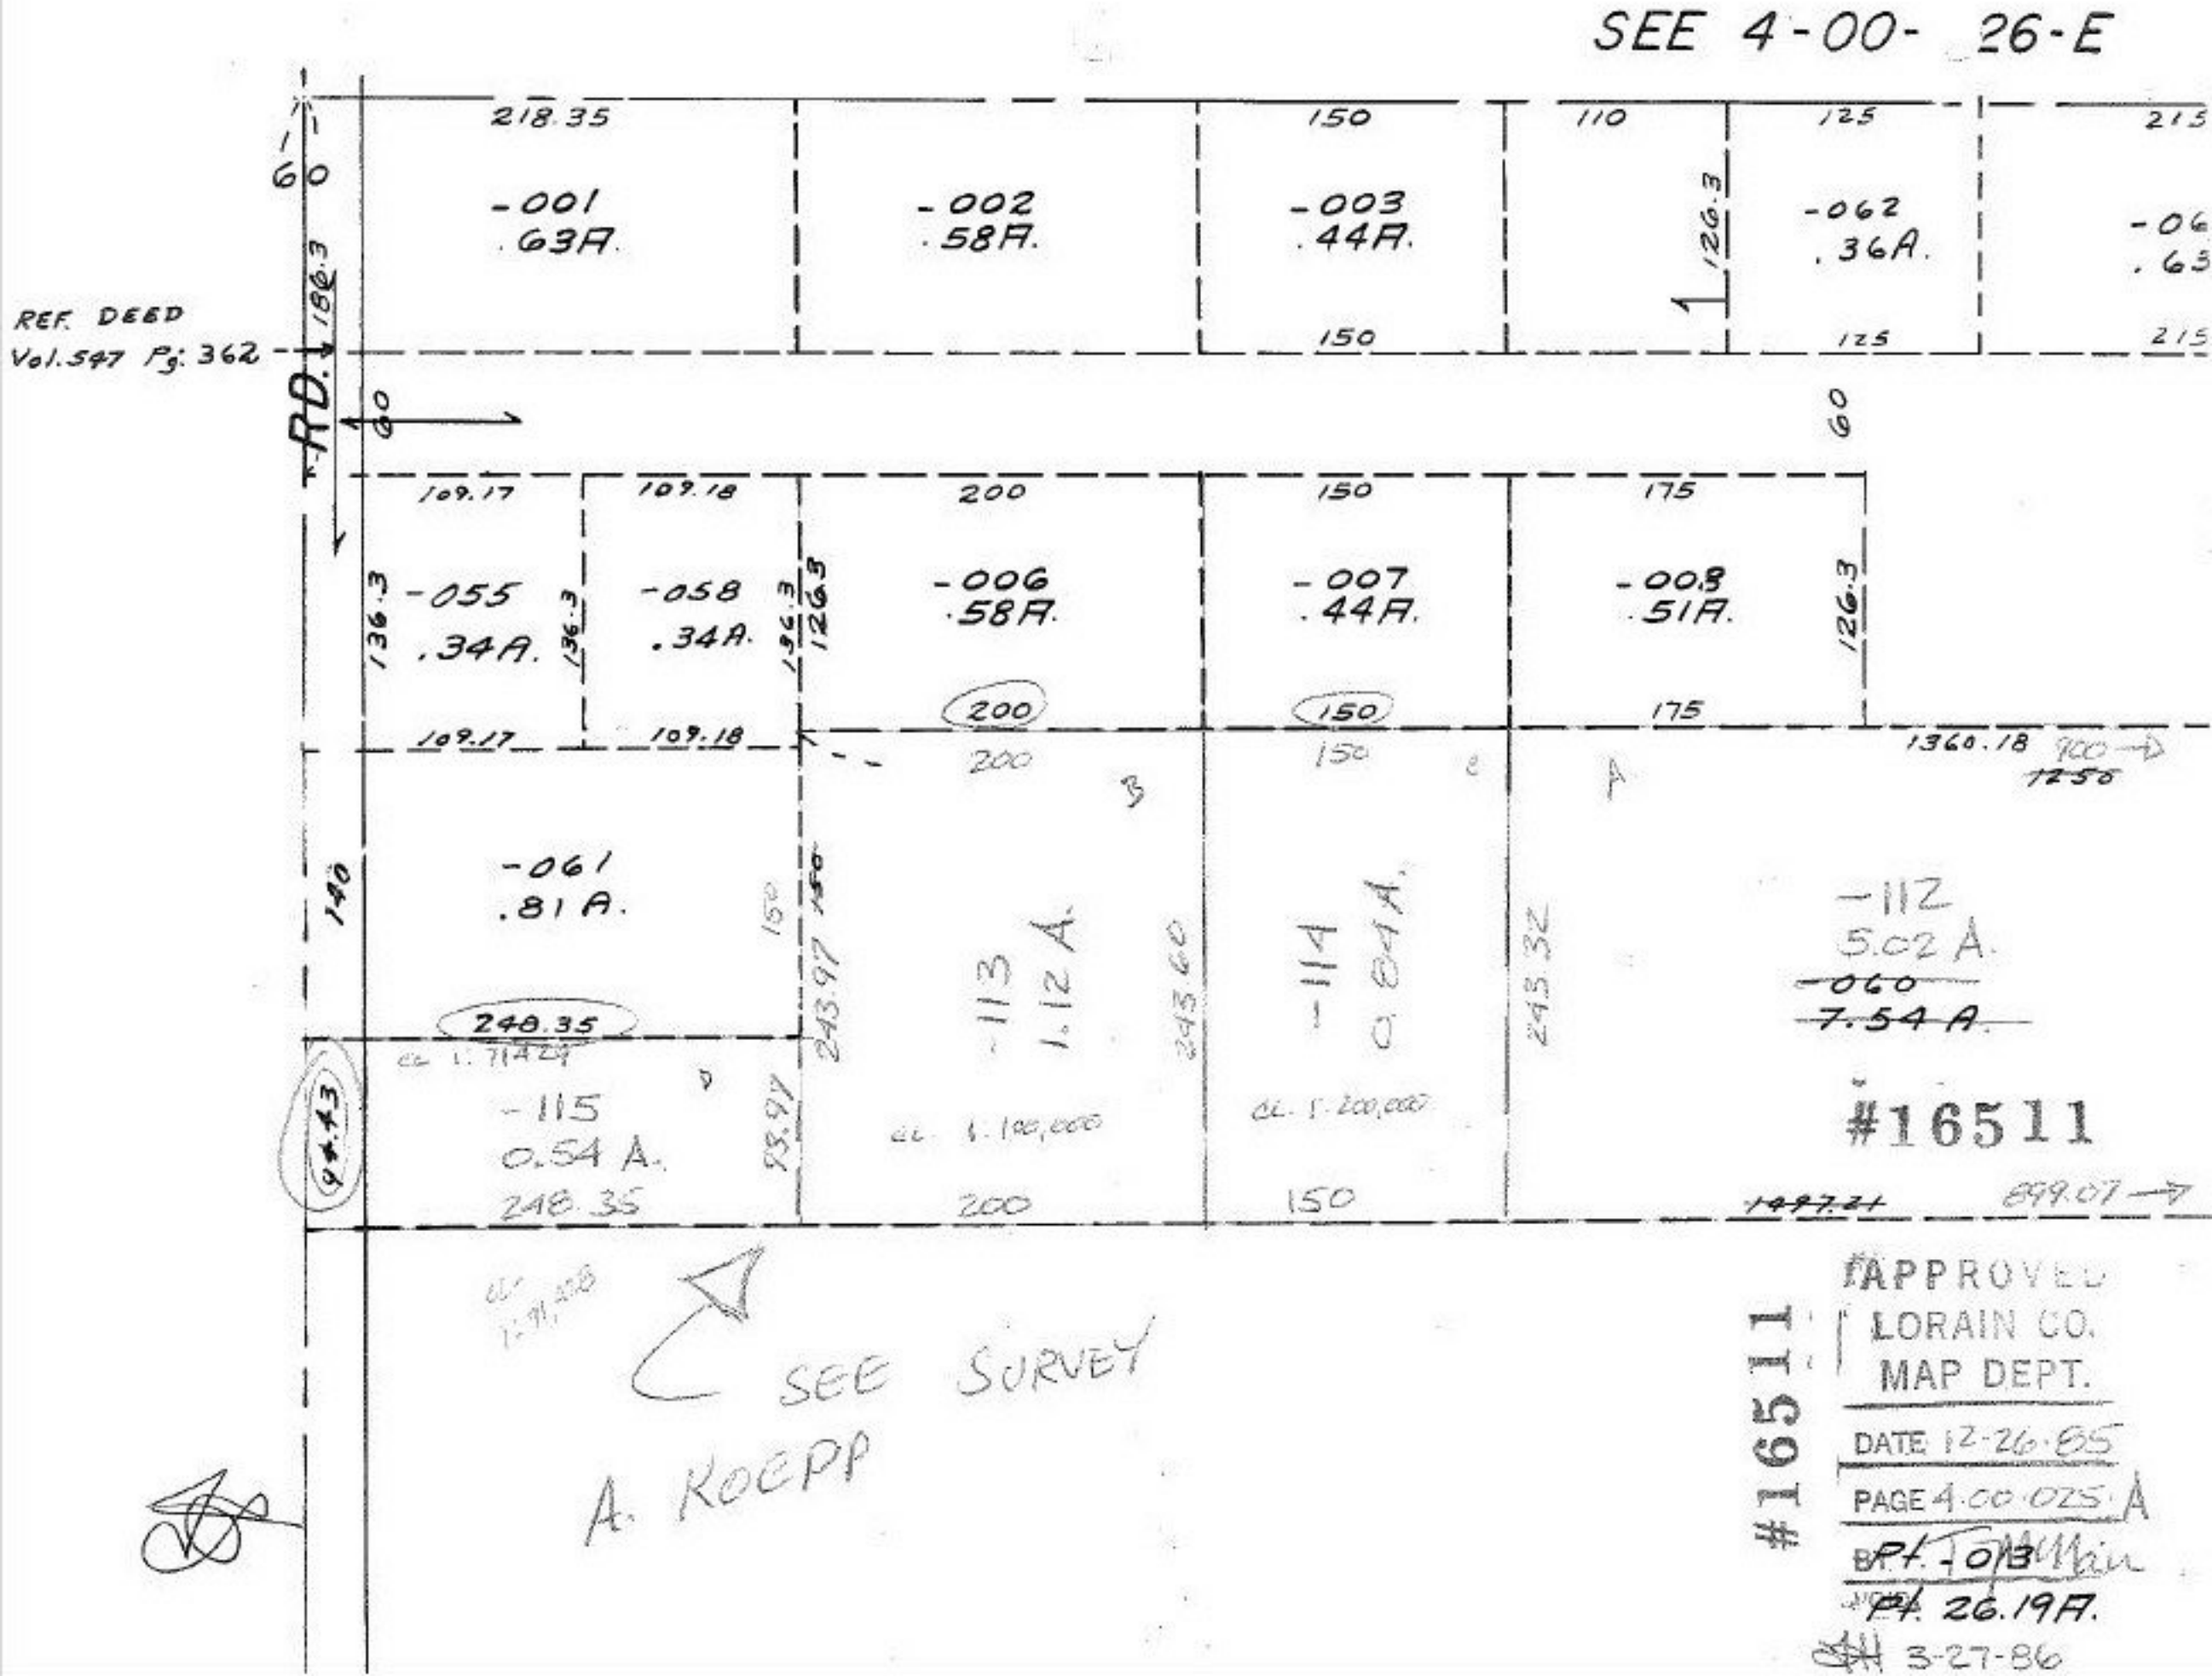
SEE 4-00- 26-E
REF. DEED
Vol. 547 Pg. 362
RD.
60
186.3
218.35
-001
.63A.
-002
.58A.
150
-003
.44A.
110
126.3
125
-062
.36A.
215
109.17
109.18
200
150
175
-055
.34A.
-058
.34A.
-006
.58A.
-007
.44A.
-008
.51A.
136.3
126.3
1360.18
900
1250
140
-061
.81 A.
248.35
243.97
-113
1.12 A.
243.60
-114
0.84 A.
243.32
-112
5.02 A.
-060
7.54 A.
94.43
-115
0.54 A.
248.35
93.97
cl. 1:100,000
cl. 1:200,000
#16511
1497.21
899.07
SEE SURVEY
A. KOEPP
APPROVED
LORAIN CO.
MAP DEPT.
DATE 12-26-85
PAGE 4-00-025 A
Pt. -013
Pt. 26.19A.
3-27-86