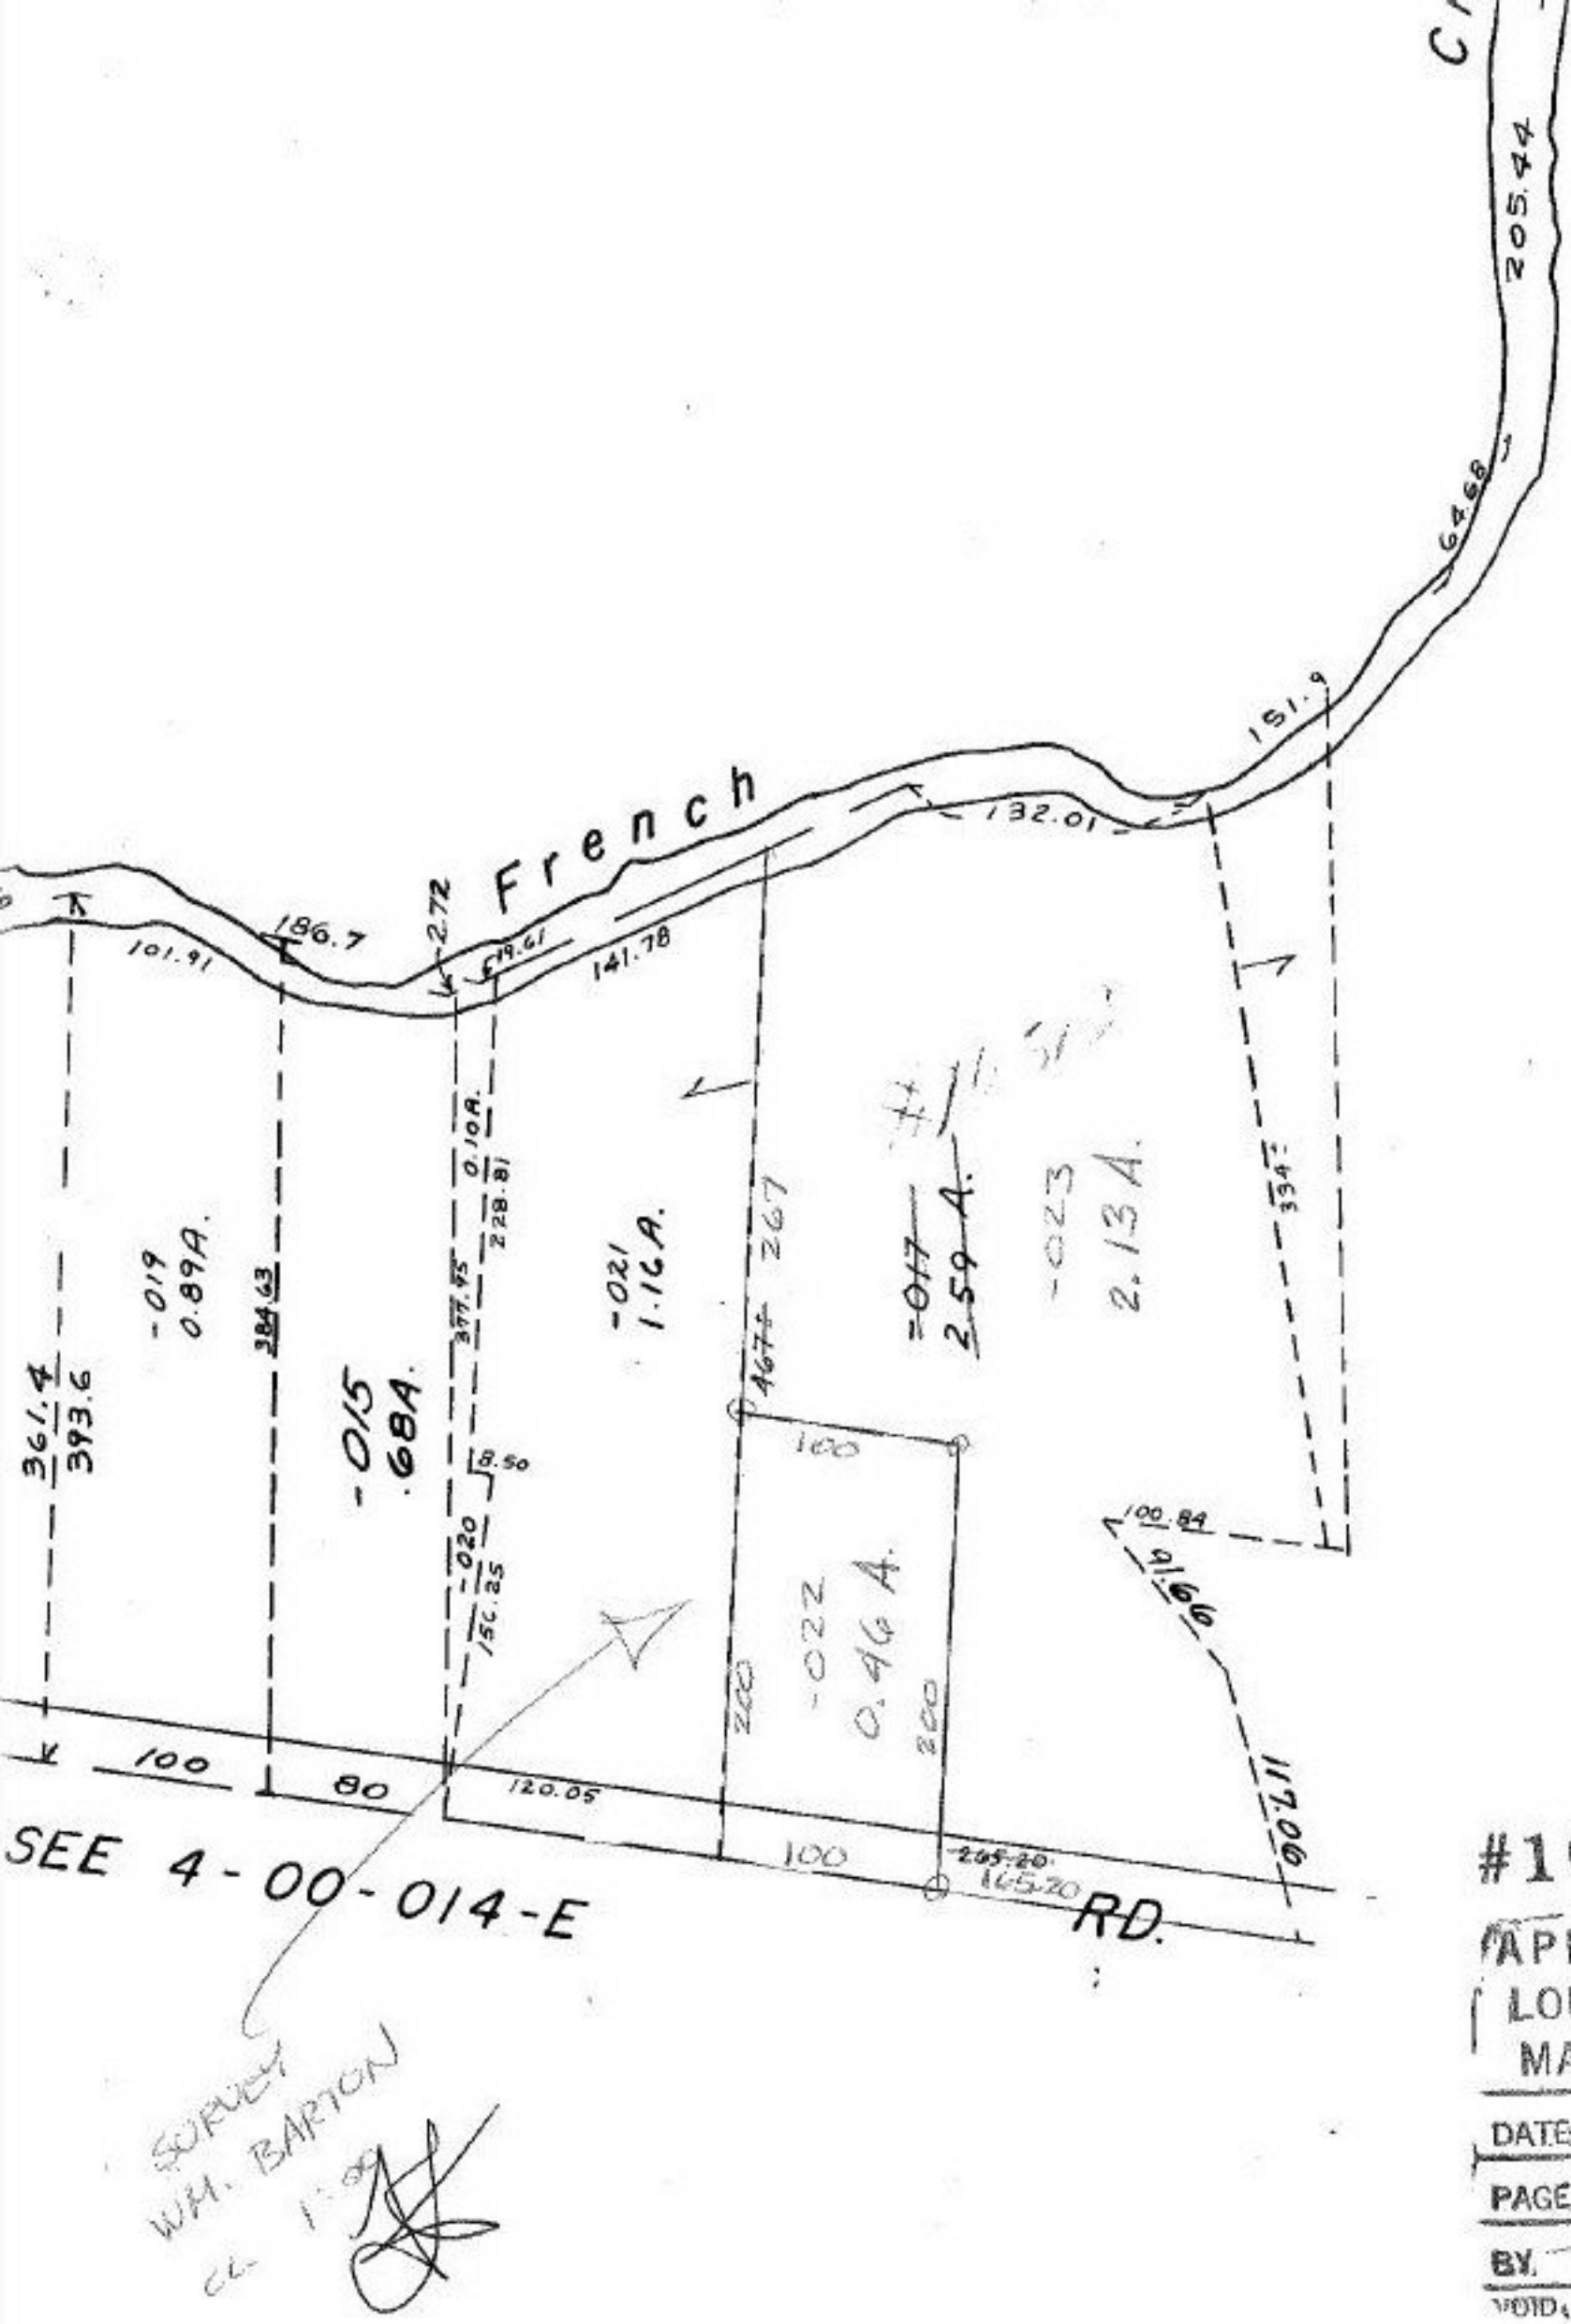

#16513

APPROVED
LORAIN CO.
MAP DEPT.

DATE 12/27/85

PAGE 4.00-014-A

BY T. McMain

VOID

3-27-86