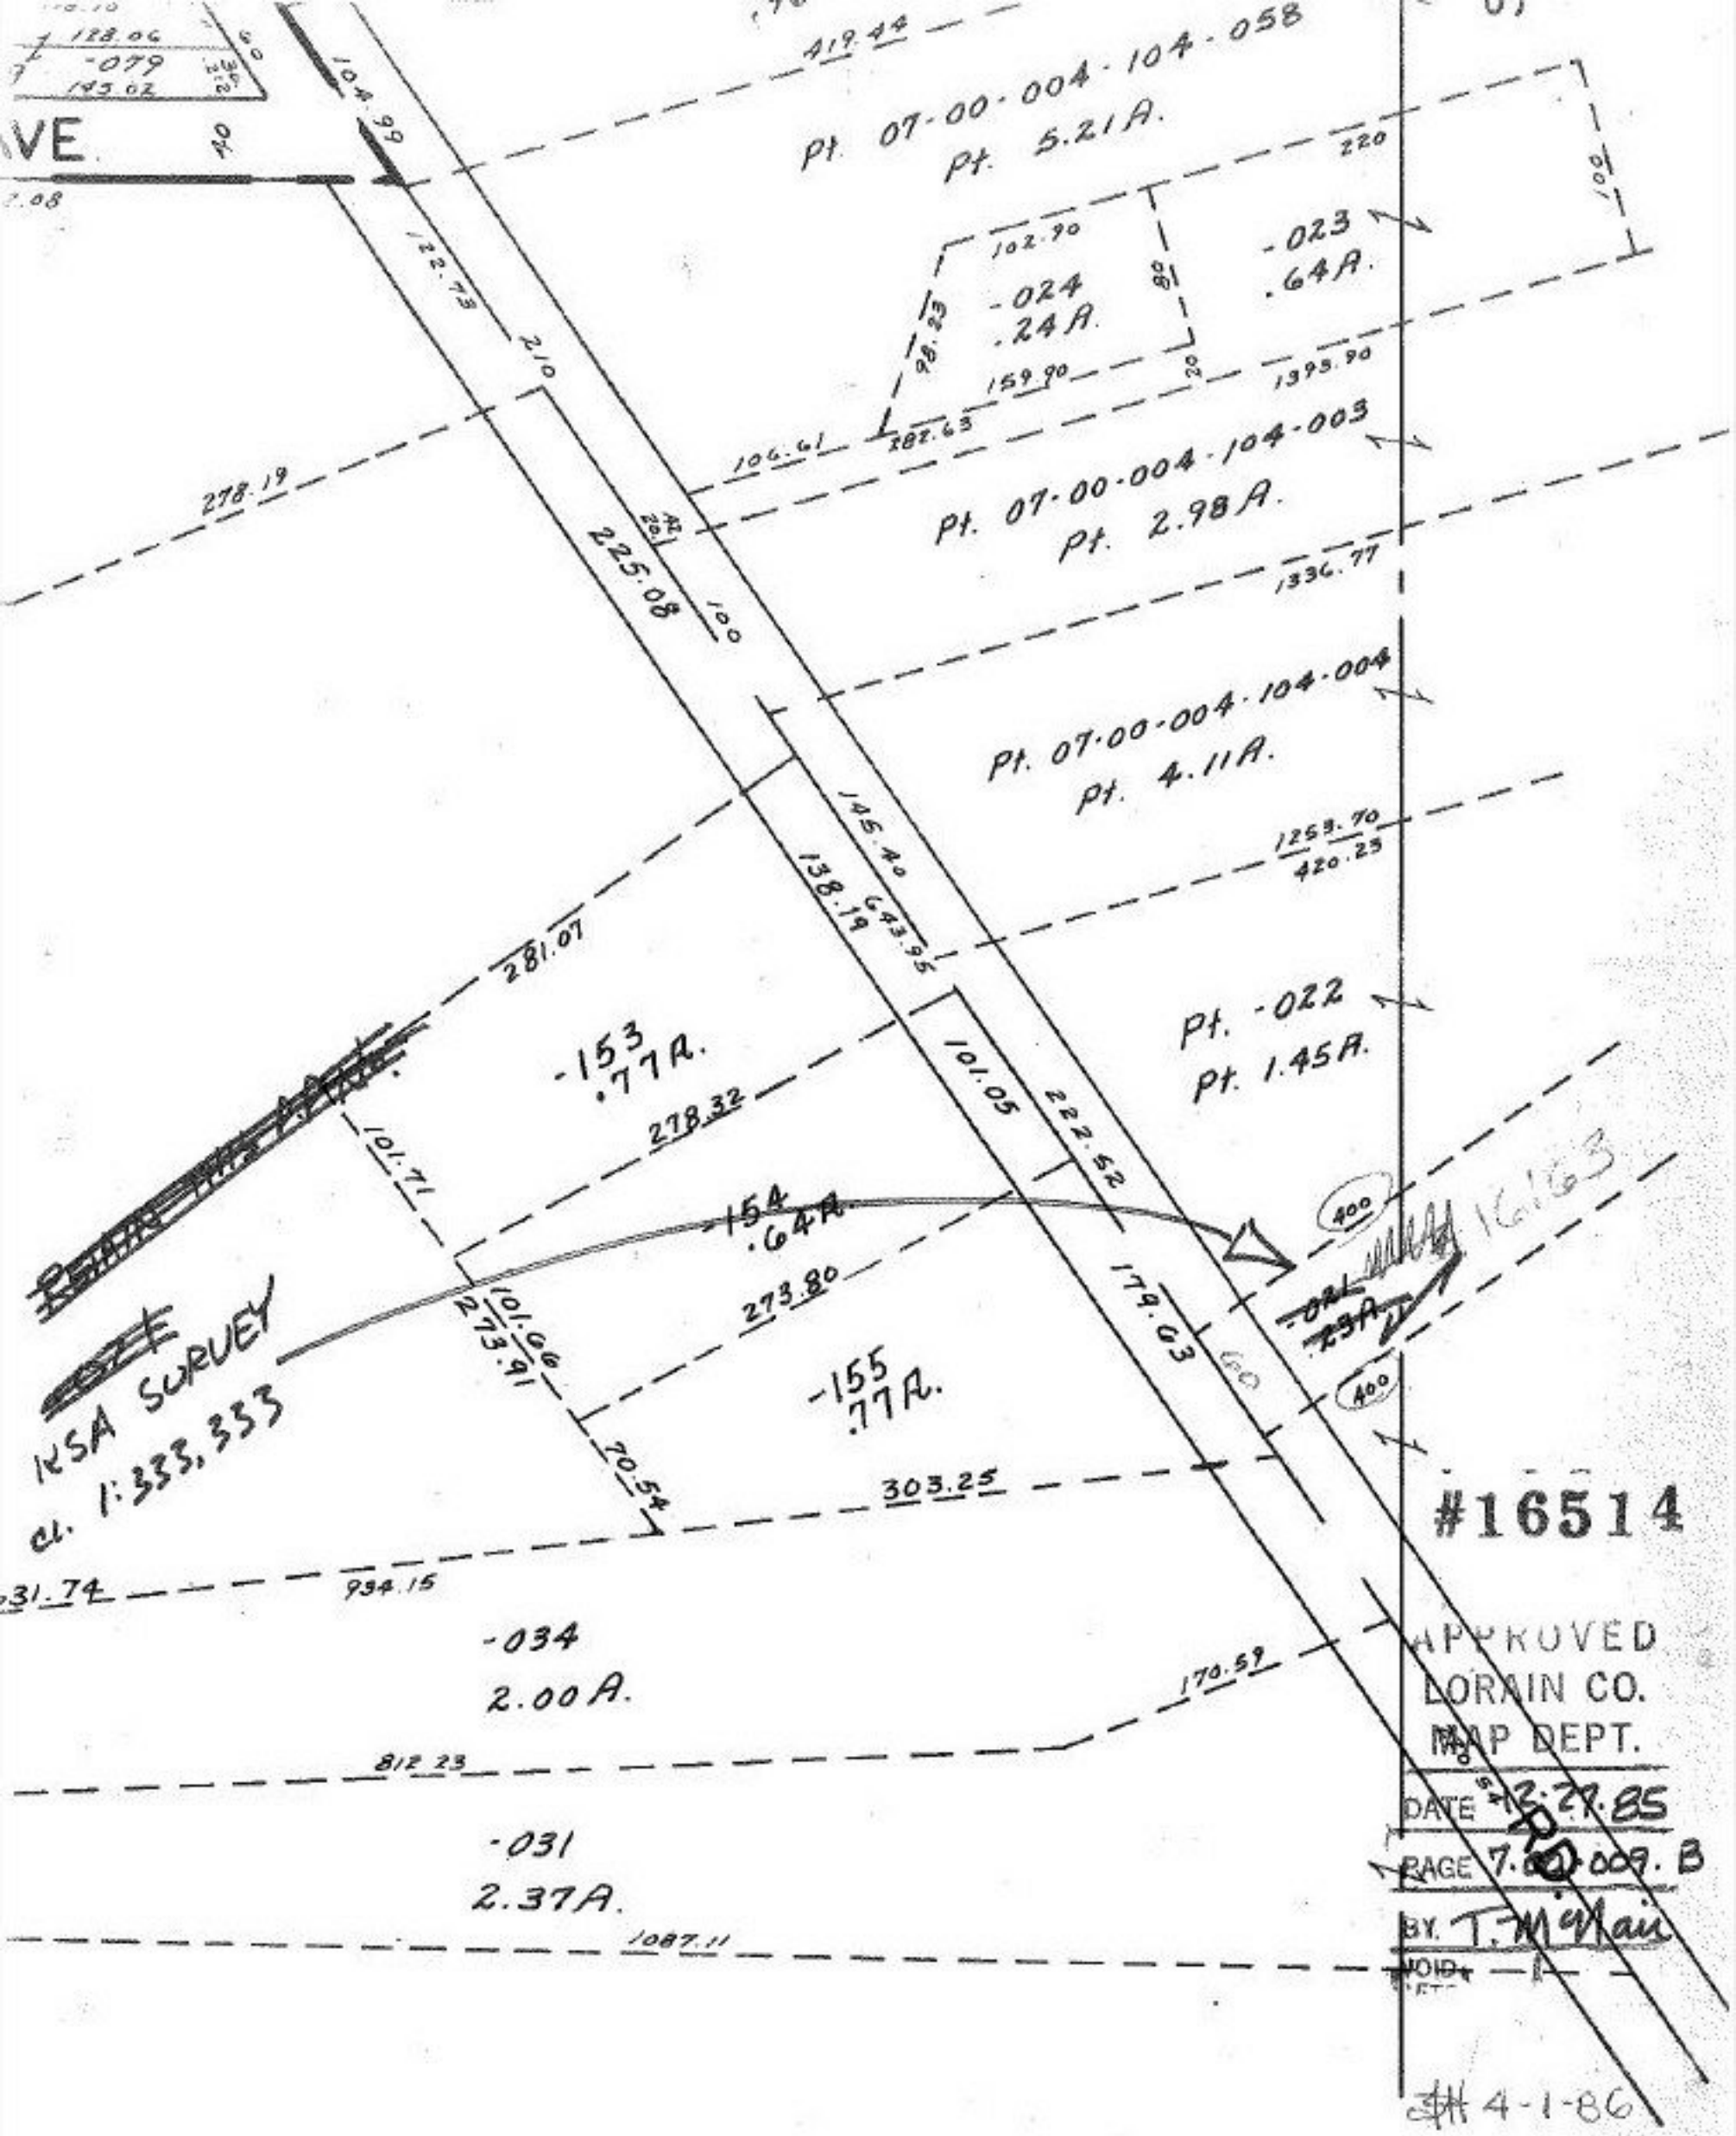

Pt. 07-00-004-104-058
Pt. 5.21A.
-024
.24A.
-023
.64A.
Pt. 07-00-004-104-003
Pt. 2.98A.
Pt. 07-00-004-104-004
Pt. 4.11A.
Pt. -022
Pt. 1.45A.
-153
.77A.
-154
.64A.
-155
.77A.
-034
2.00A.
-031
2.37A.
KSA SURVEY
cl. 1:333,333
#16514
APPROVED
LORAIN CO.
MAP DEPT.
DATE 12.27.85
PAGE 7.00-009.B
BY T. McNair
VOID
4-1-86