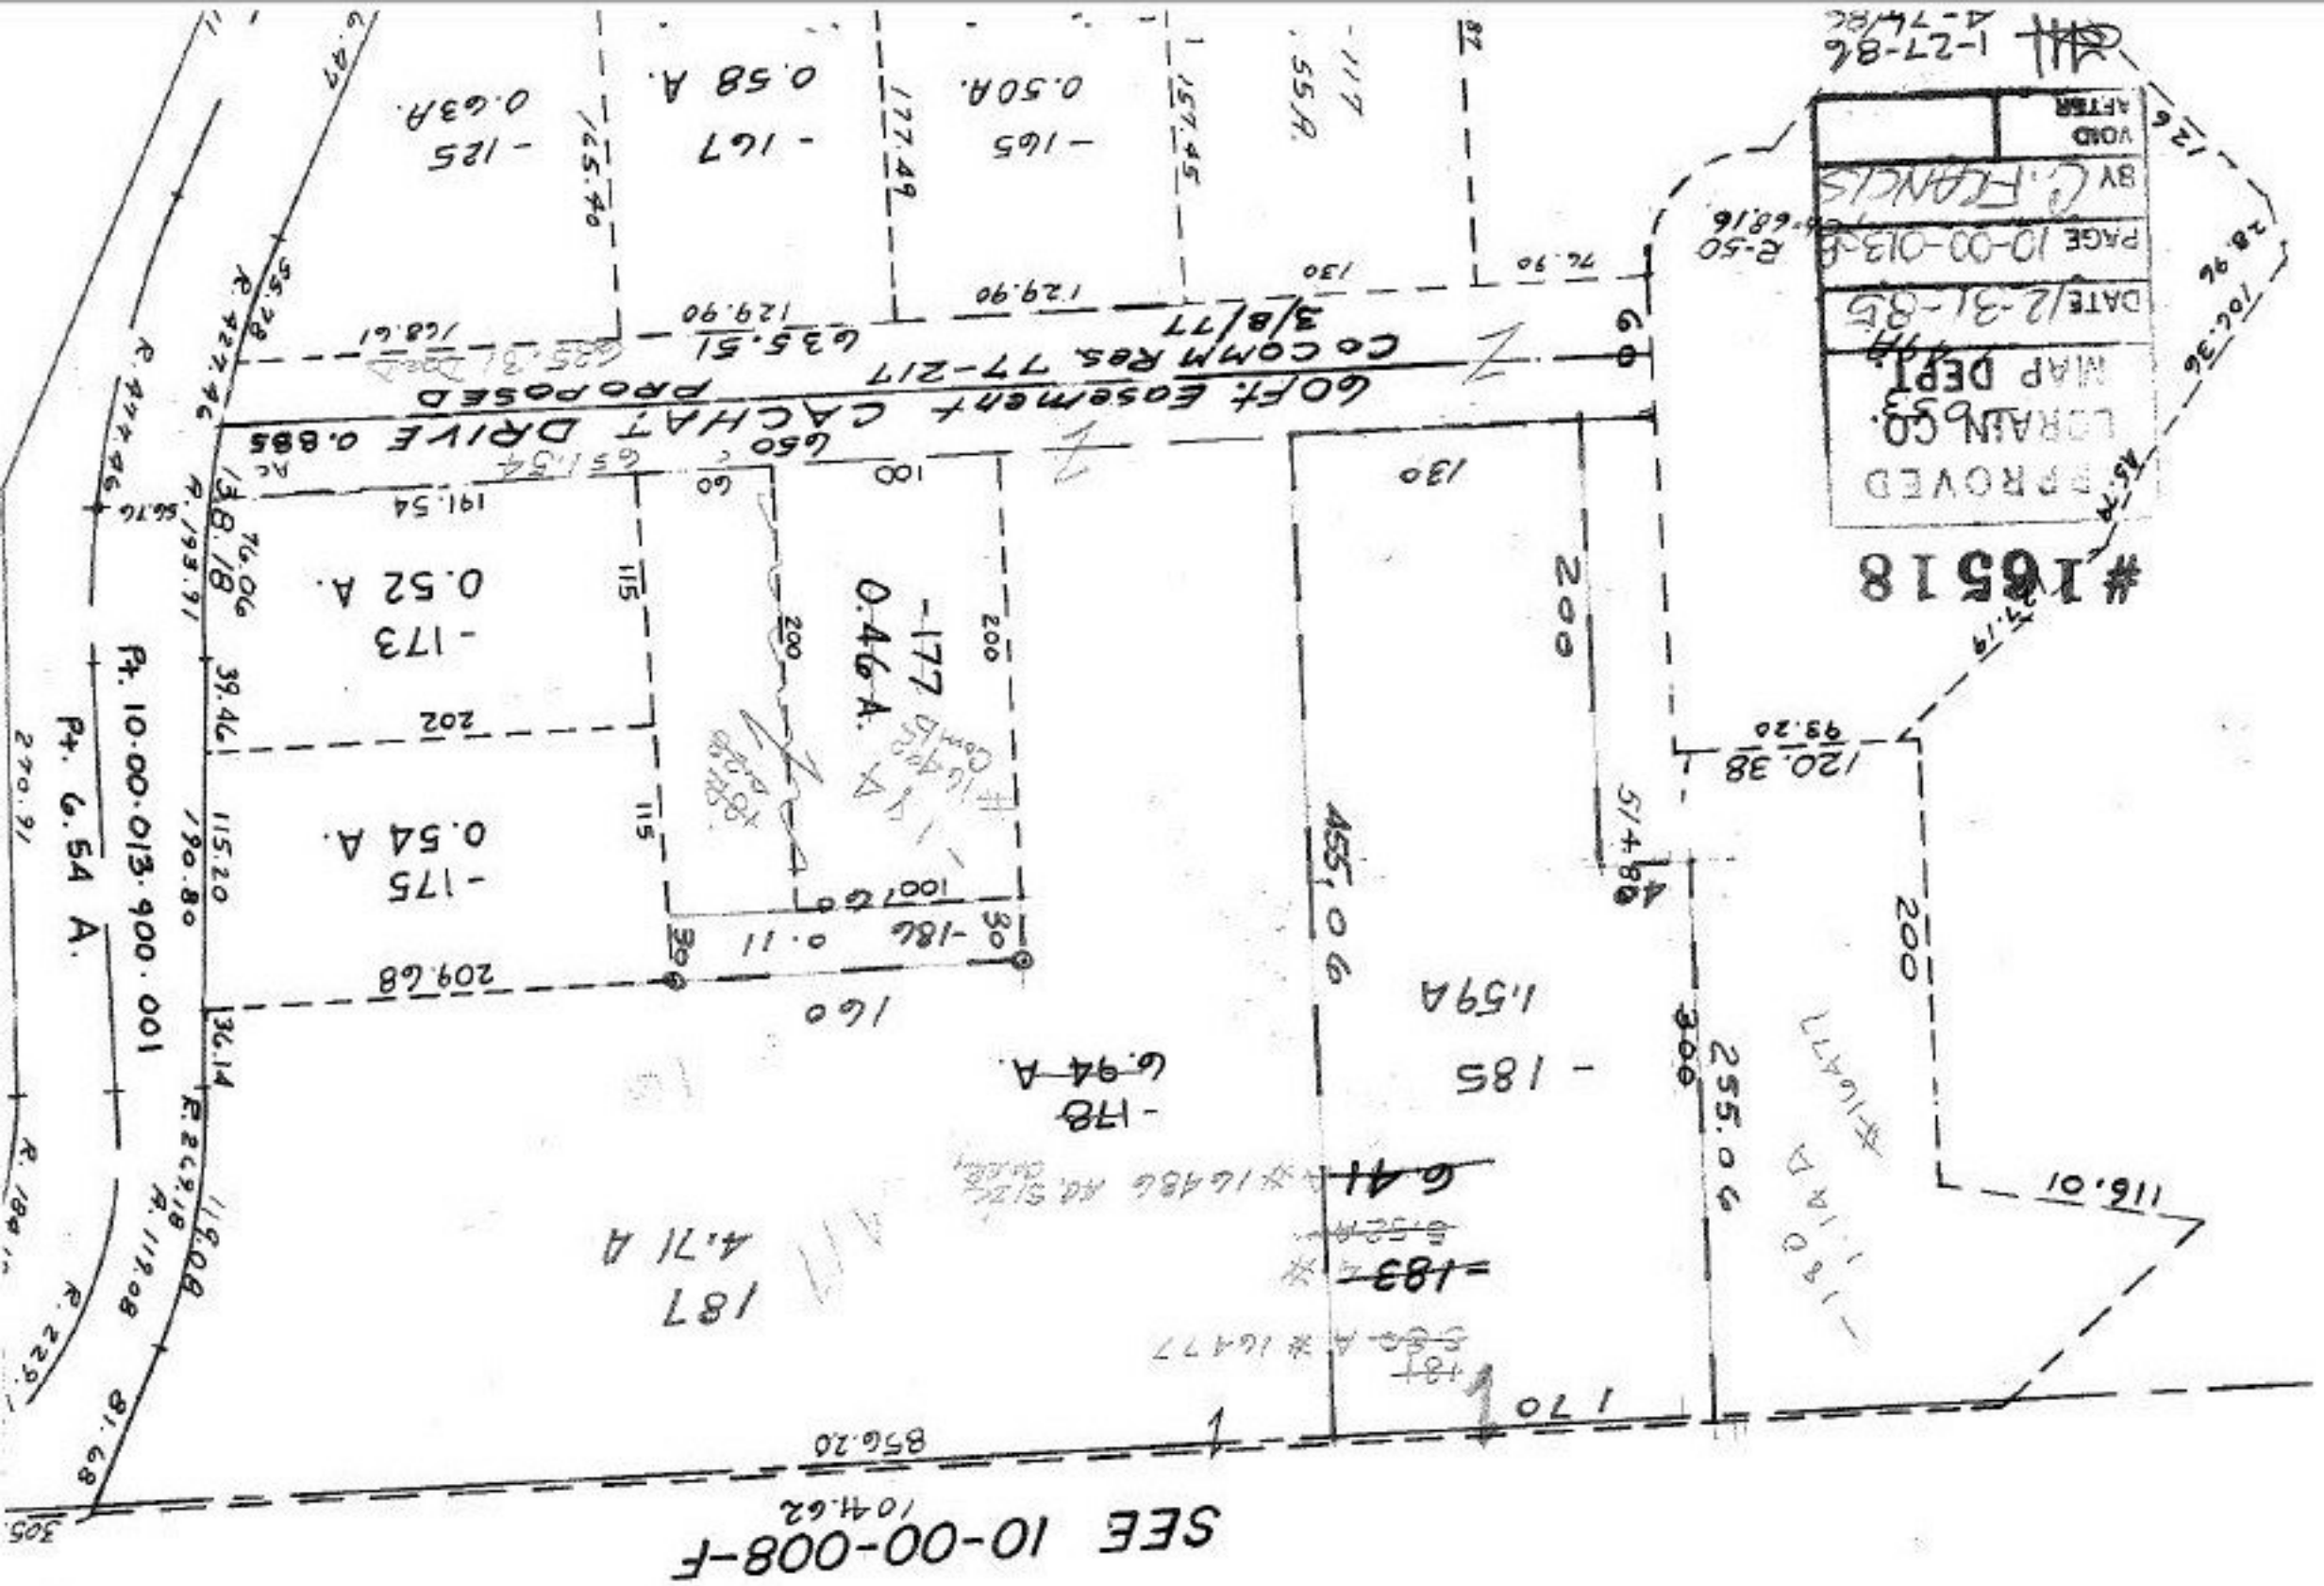

#16518
APPROVED
LORAIN CO.
MAP DEPT.
DATE 12-31-85
PAGE 10-00-013-B
BY C. FRANCIS
VOID
AFTER
1-27-86
4-7-86
60 Ft. Easement CACHAT DRIVE 0.885
CO COMM Res. 77-217
PROPOSED
3/8/77
-125 0.63A.
-167 0.58 A.
-165 0.50A.
-173 0.52 A.
-175 0.54 A.
-177 0.46 A.
-178 6.94 A.
-185 1.59A
-183 6.41
187 4.71 A
Pt. 10-00-013-900-001
Pt. 6.54 A.
SEE 10-00-008-F