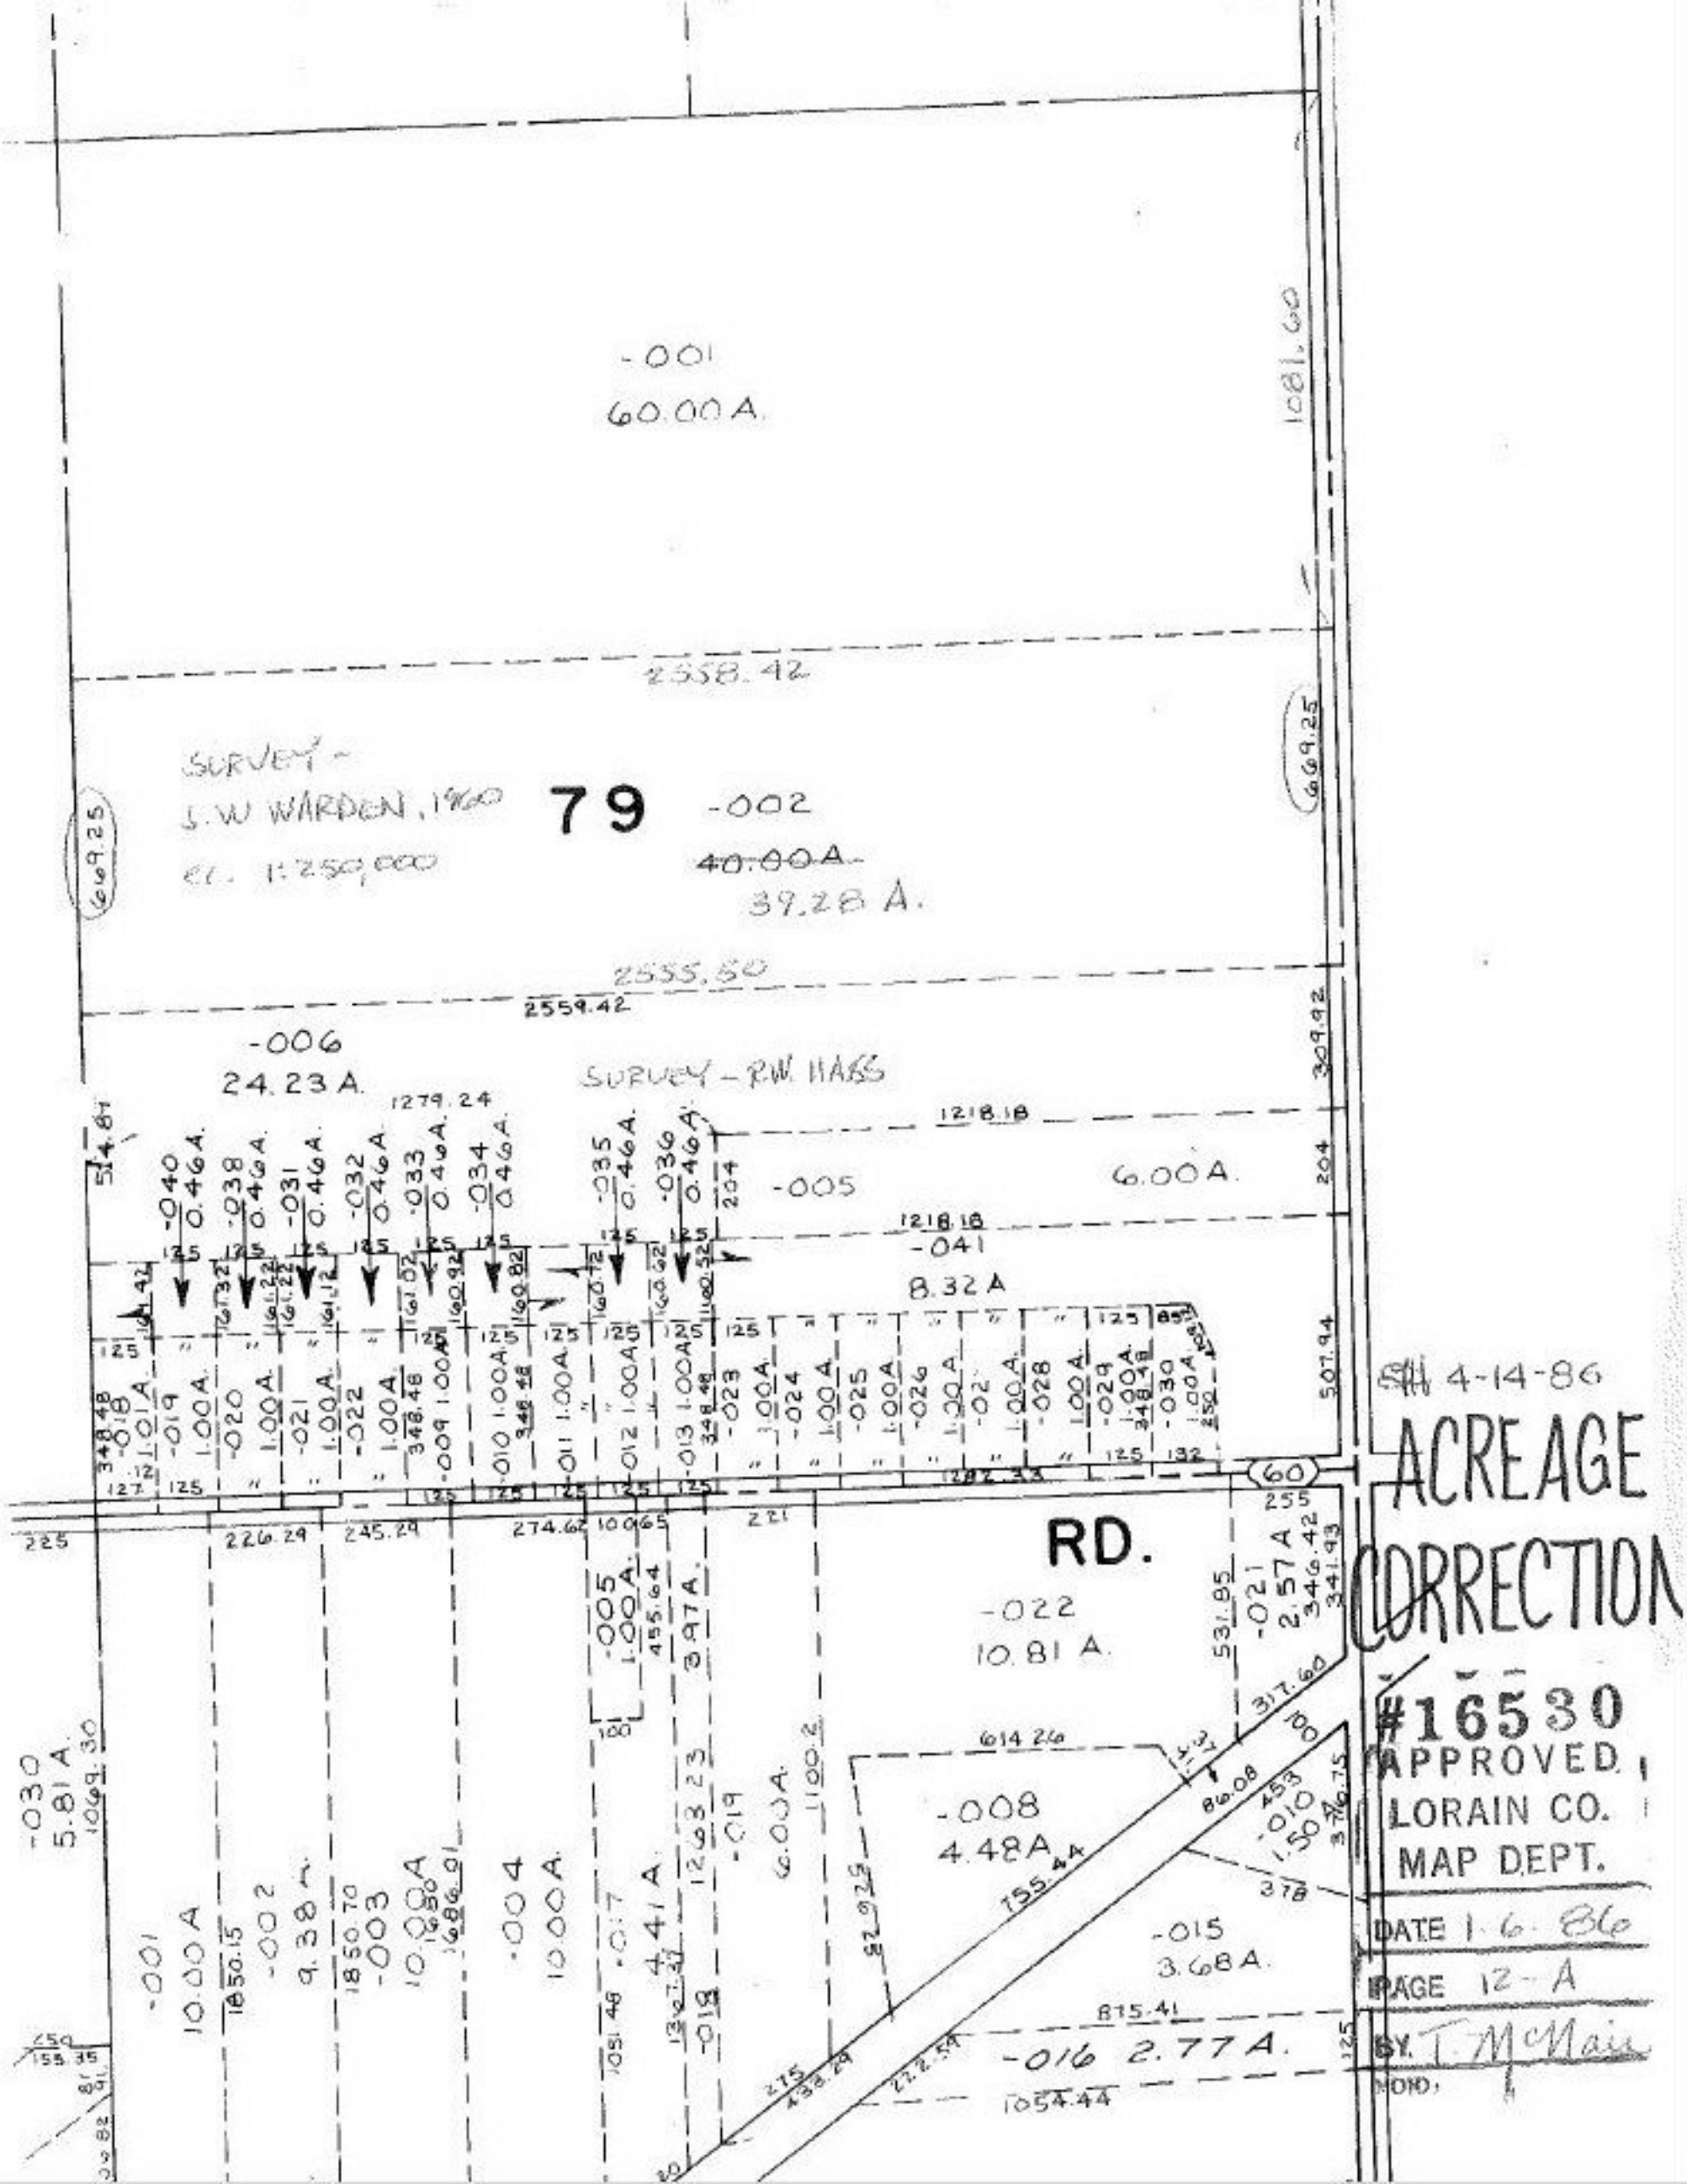

4-14-86

ACREAGE CORRECTION

#16530
APPROVED
LORAIN CO.
MAP DEPT.

DATE 1-6-86
PAGE 12-A
BY T. McNair
MOD.