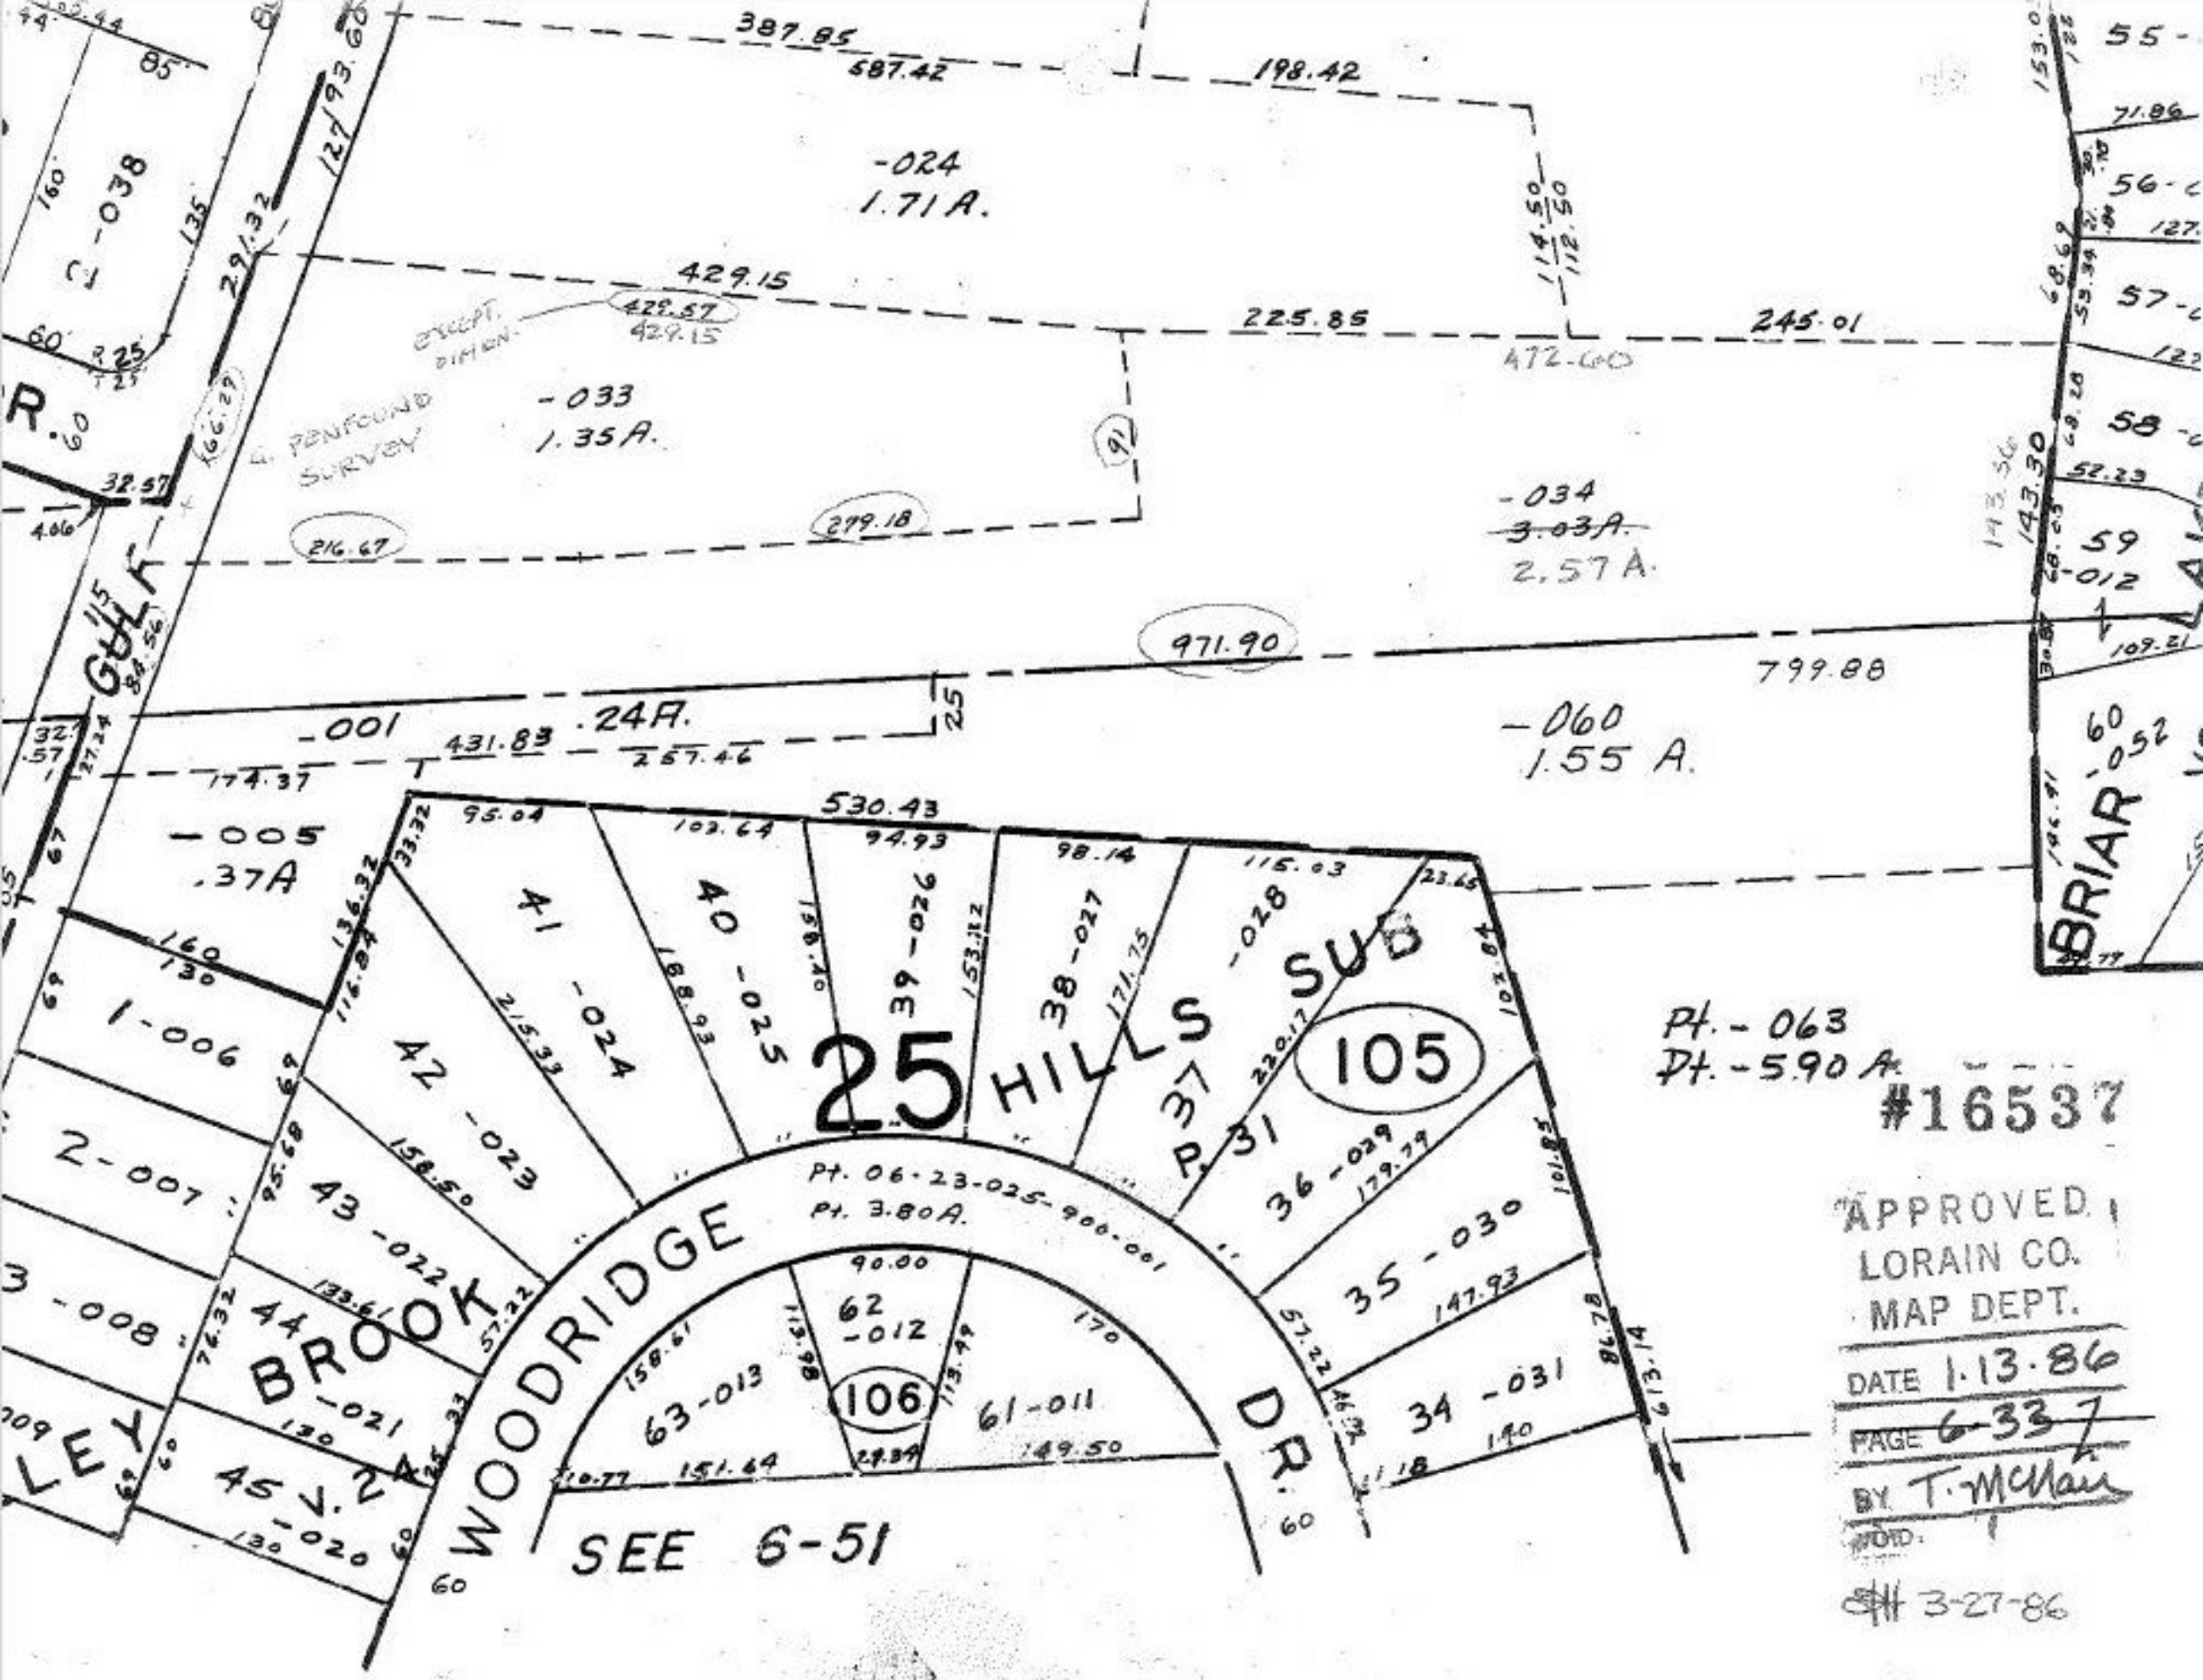

387.85
587.42
198.42
-024
1.71 A.
429.15
225.85
245.01
472.60
-033
1.35 A.
-034
3.03 A.
2.57 A.
971.90
799.88
-060
1.55 A.
-001
.24 A.
431.83
257.46
174.37
530.43
-005
.37 A
25
HILLS SUB
105
P. 31
37
36 -029
35 -030
34 -031
38 -027
39 -026
40 -025
41 -024
42 -023
43 -022
44 -021
45 V. 24 -020
1-006
2-007
3-008
WOODRIDGE
DR.
BROOK
LEY
BRIAR
GULF
Pt. 06-23-025-900-001
Pt. 3.80 A.
62 -012
106
63-013
61-011
SEE 6-51
Pt. - 063
Pt. - 5.90 A.
#16537
APPROVED
LORAIN CO.
MAP DEPT.
DATE 1.13.86
PAGE 6-33
BY T. McNair
VOID
3-27-86