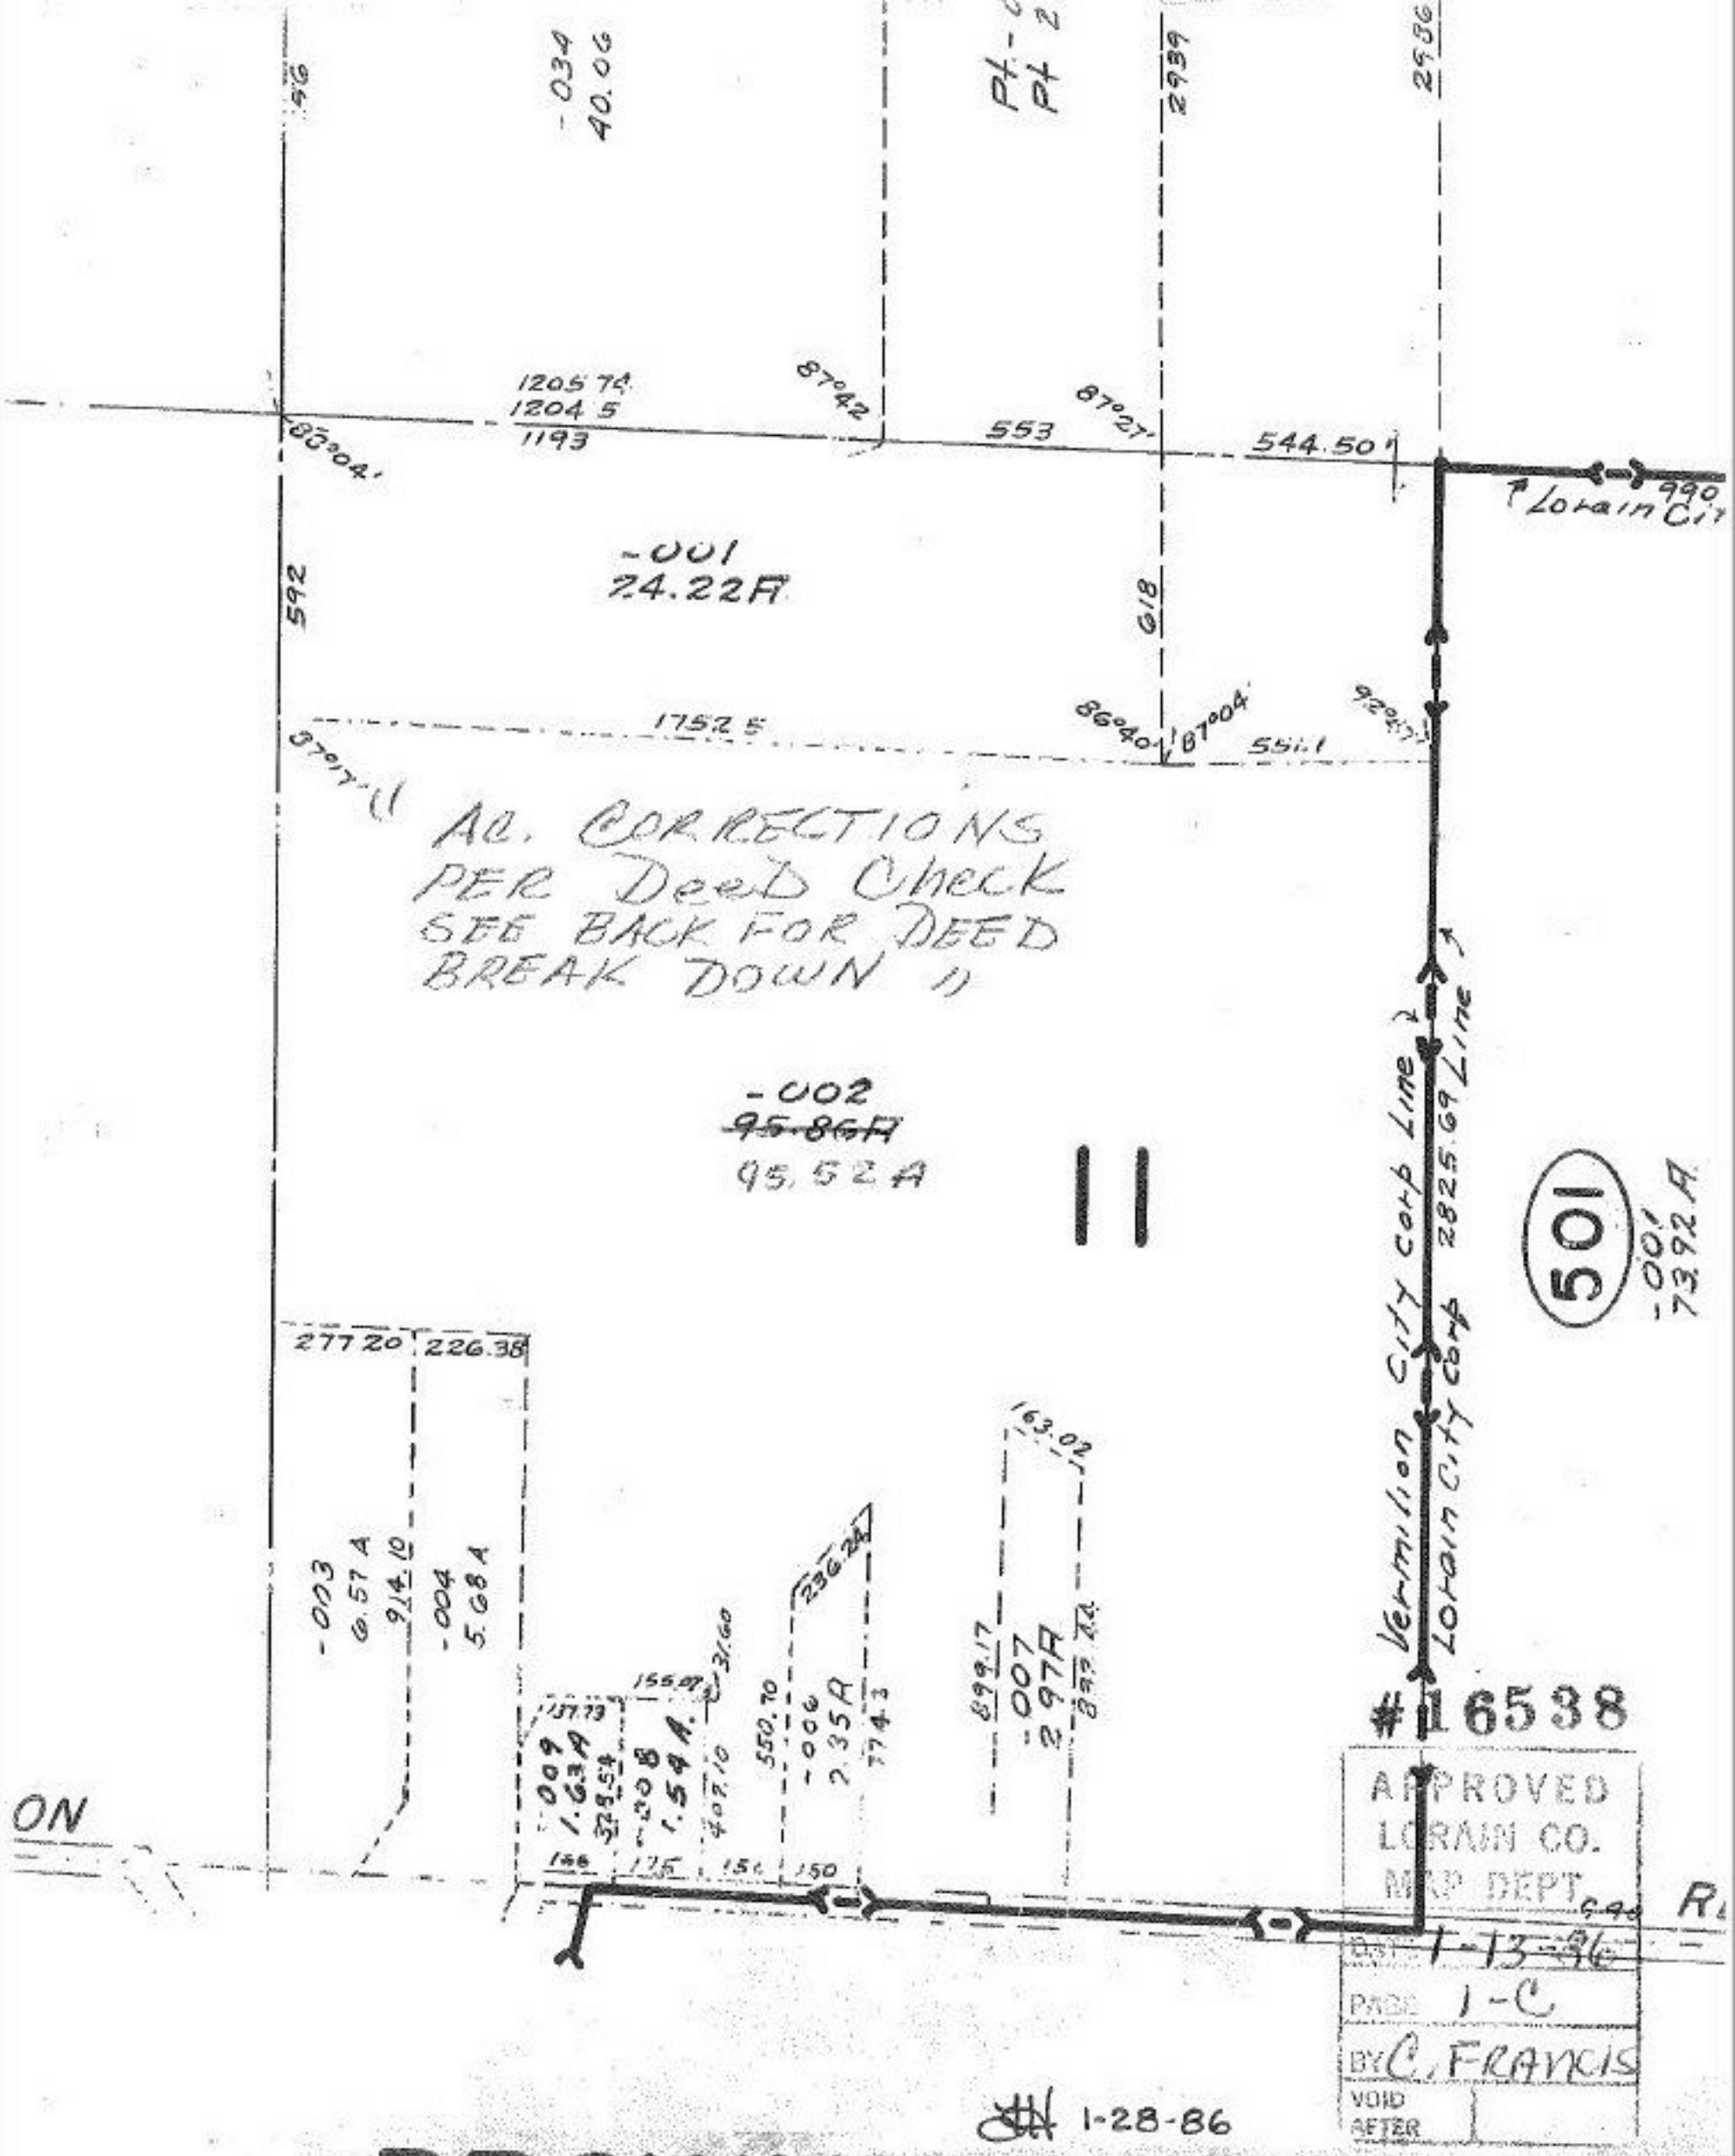

-034
40.06
2939
2936
1205.74
1204.5
1193
87°42
87°27
553
544.50
Lorain City
990
-001
24.22A
592
618
1752.5
86°40
87°04
551.1
AC. CORRECTIONS
PER DeeD Check
SEE BACK FOR DEED
BREAK DOWN
-002
~~95.86A~~
95.52A
Vermilion City Corp Line
Lorain City Corp
2825.69 Line
501
-001
73.92A
277.20
226.38
-003
6.57A
914.10
-004
5.68A
163.02
236.24
899.17
-007
2.97A
-006
2.35A
550.70
407.10
155.07
31.60
-009
1.63A
-008
1.54A
ON
#16538
APPROVED
LORAIN CO.
MAP DEPT.
DATE 1-13-86
PAGE 1-C
BY C. FRANCIS
VOID
AFTER
1-28-86
BROWNHELM TWP