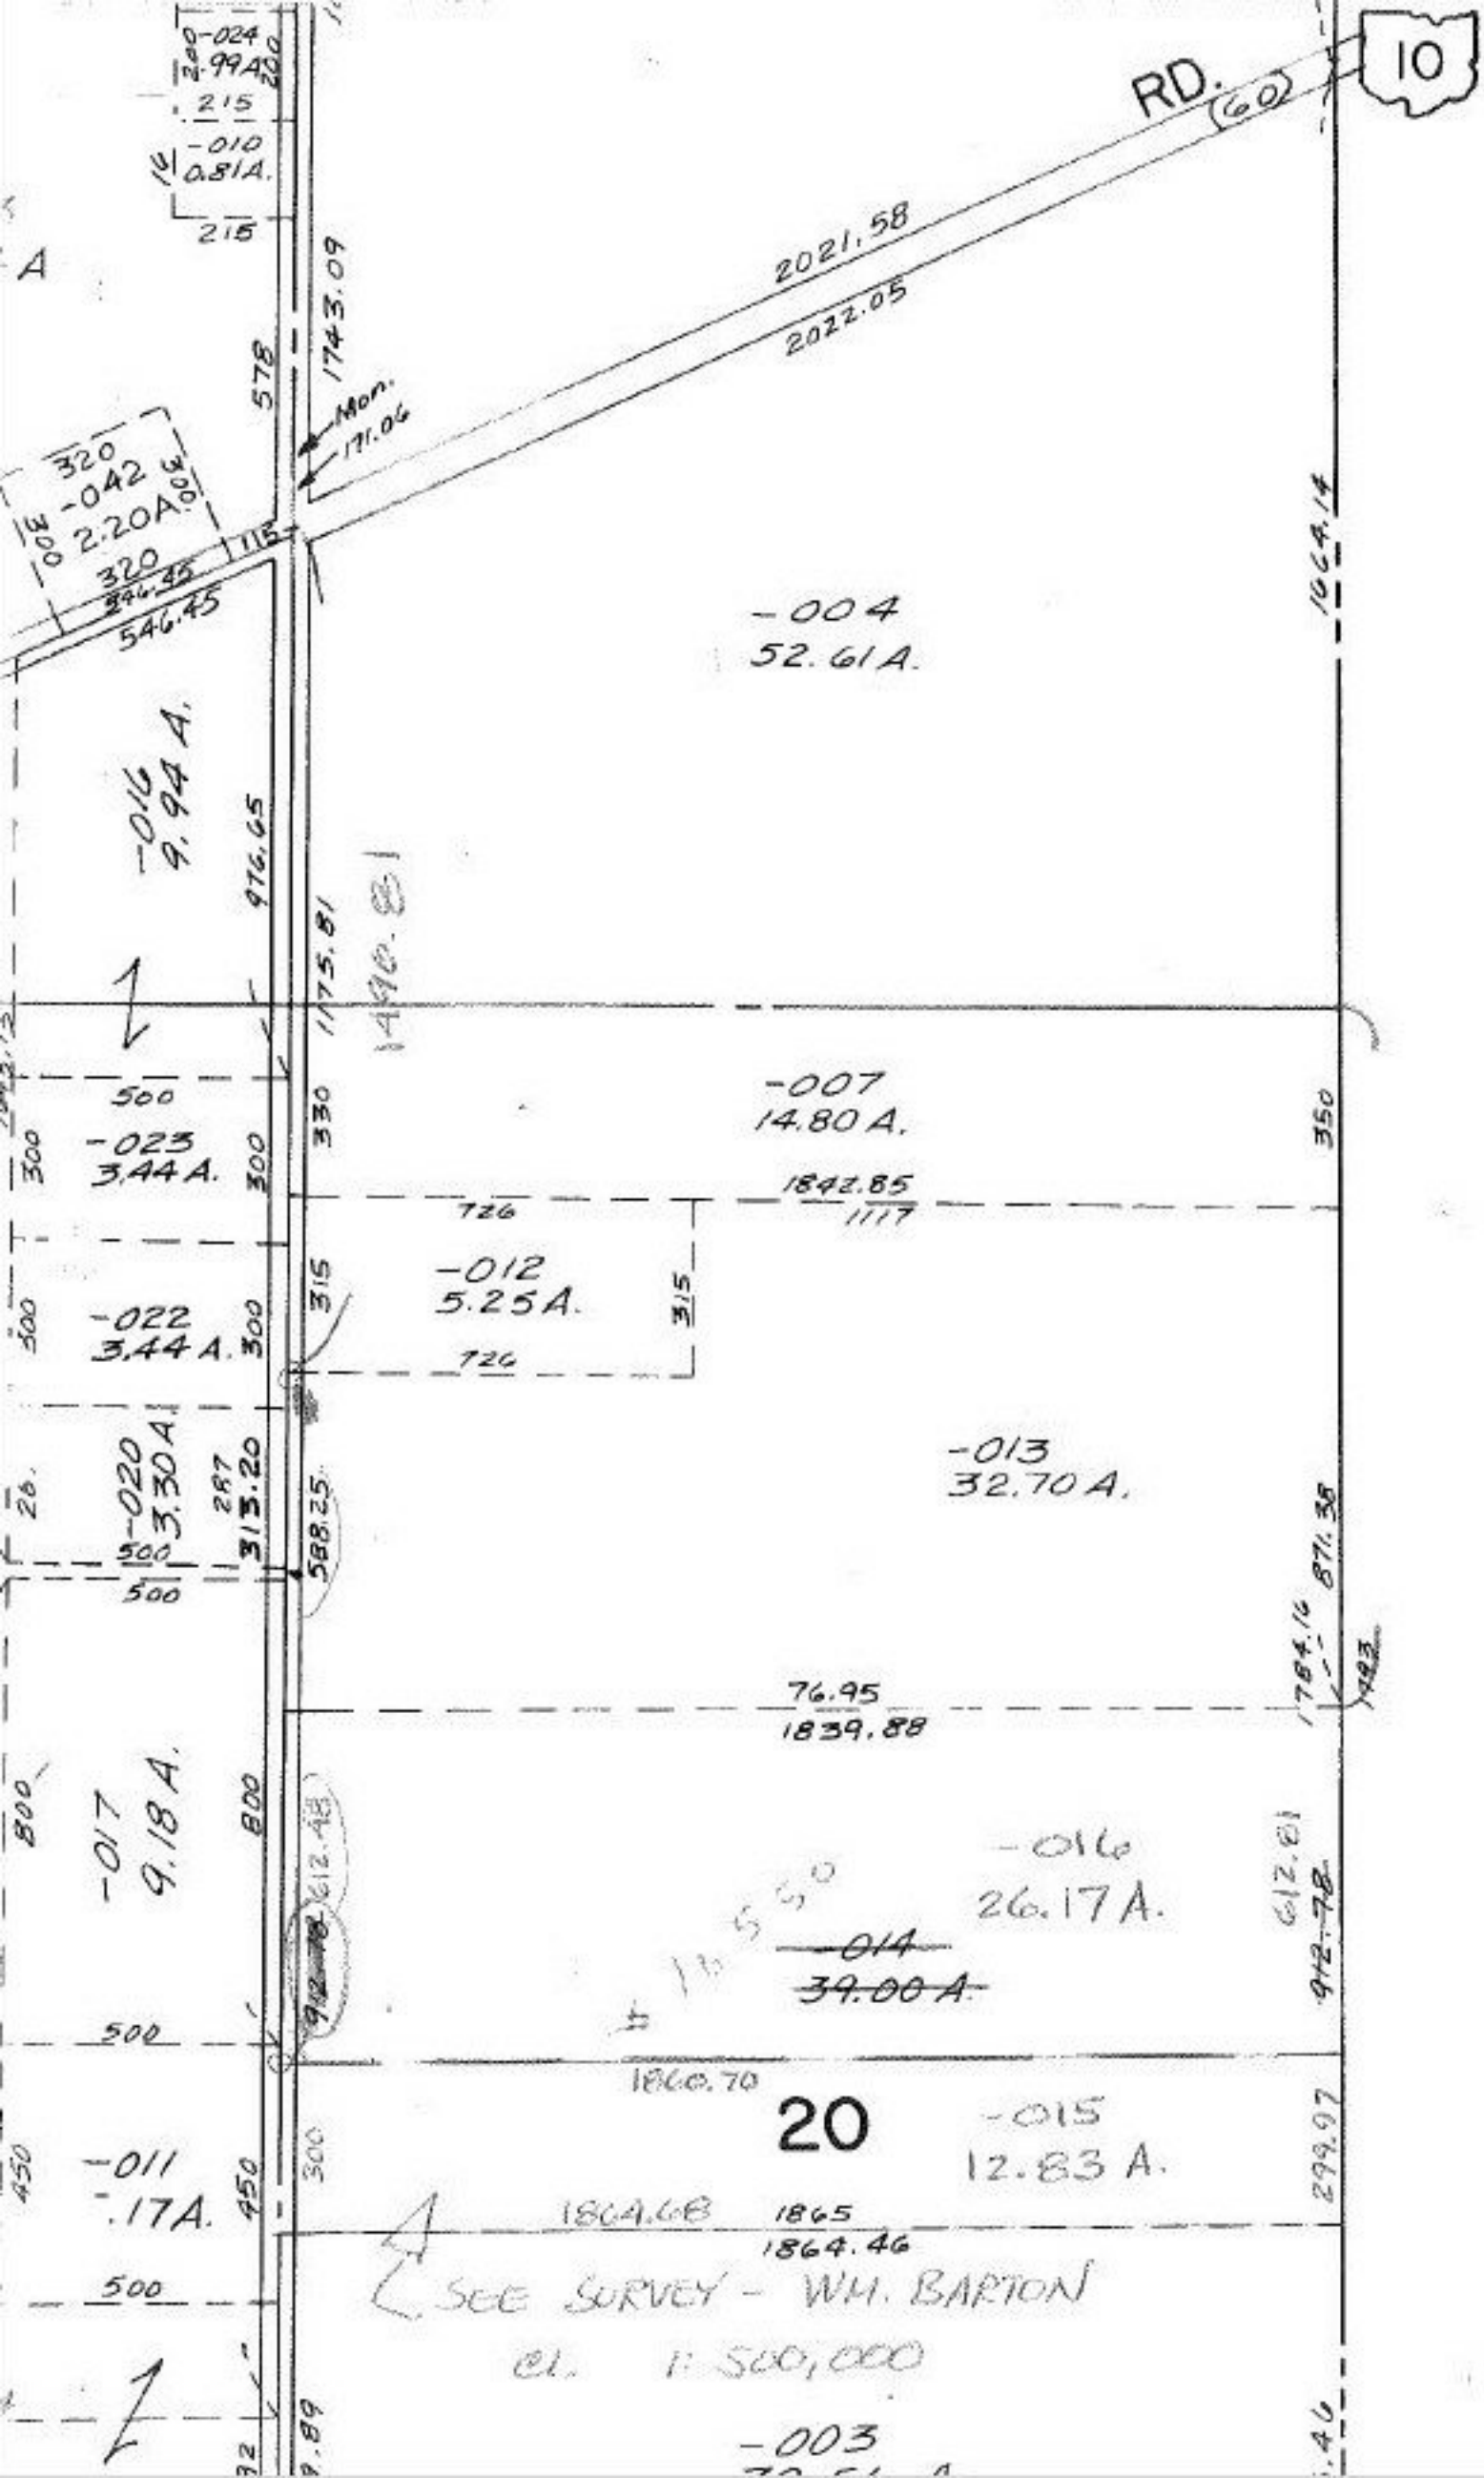

#16550
APPROVED
LORAIN CO.
MAP DEPT.
DATE 1-16-86
PAGE 8-H
BY T. McNair
VOID
3-31-86