


SEE 7-

1367 Yo E. Mills Rd.

JAYCOX

101

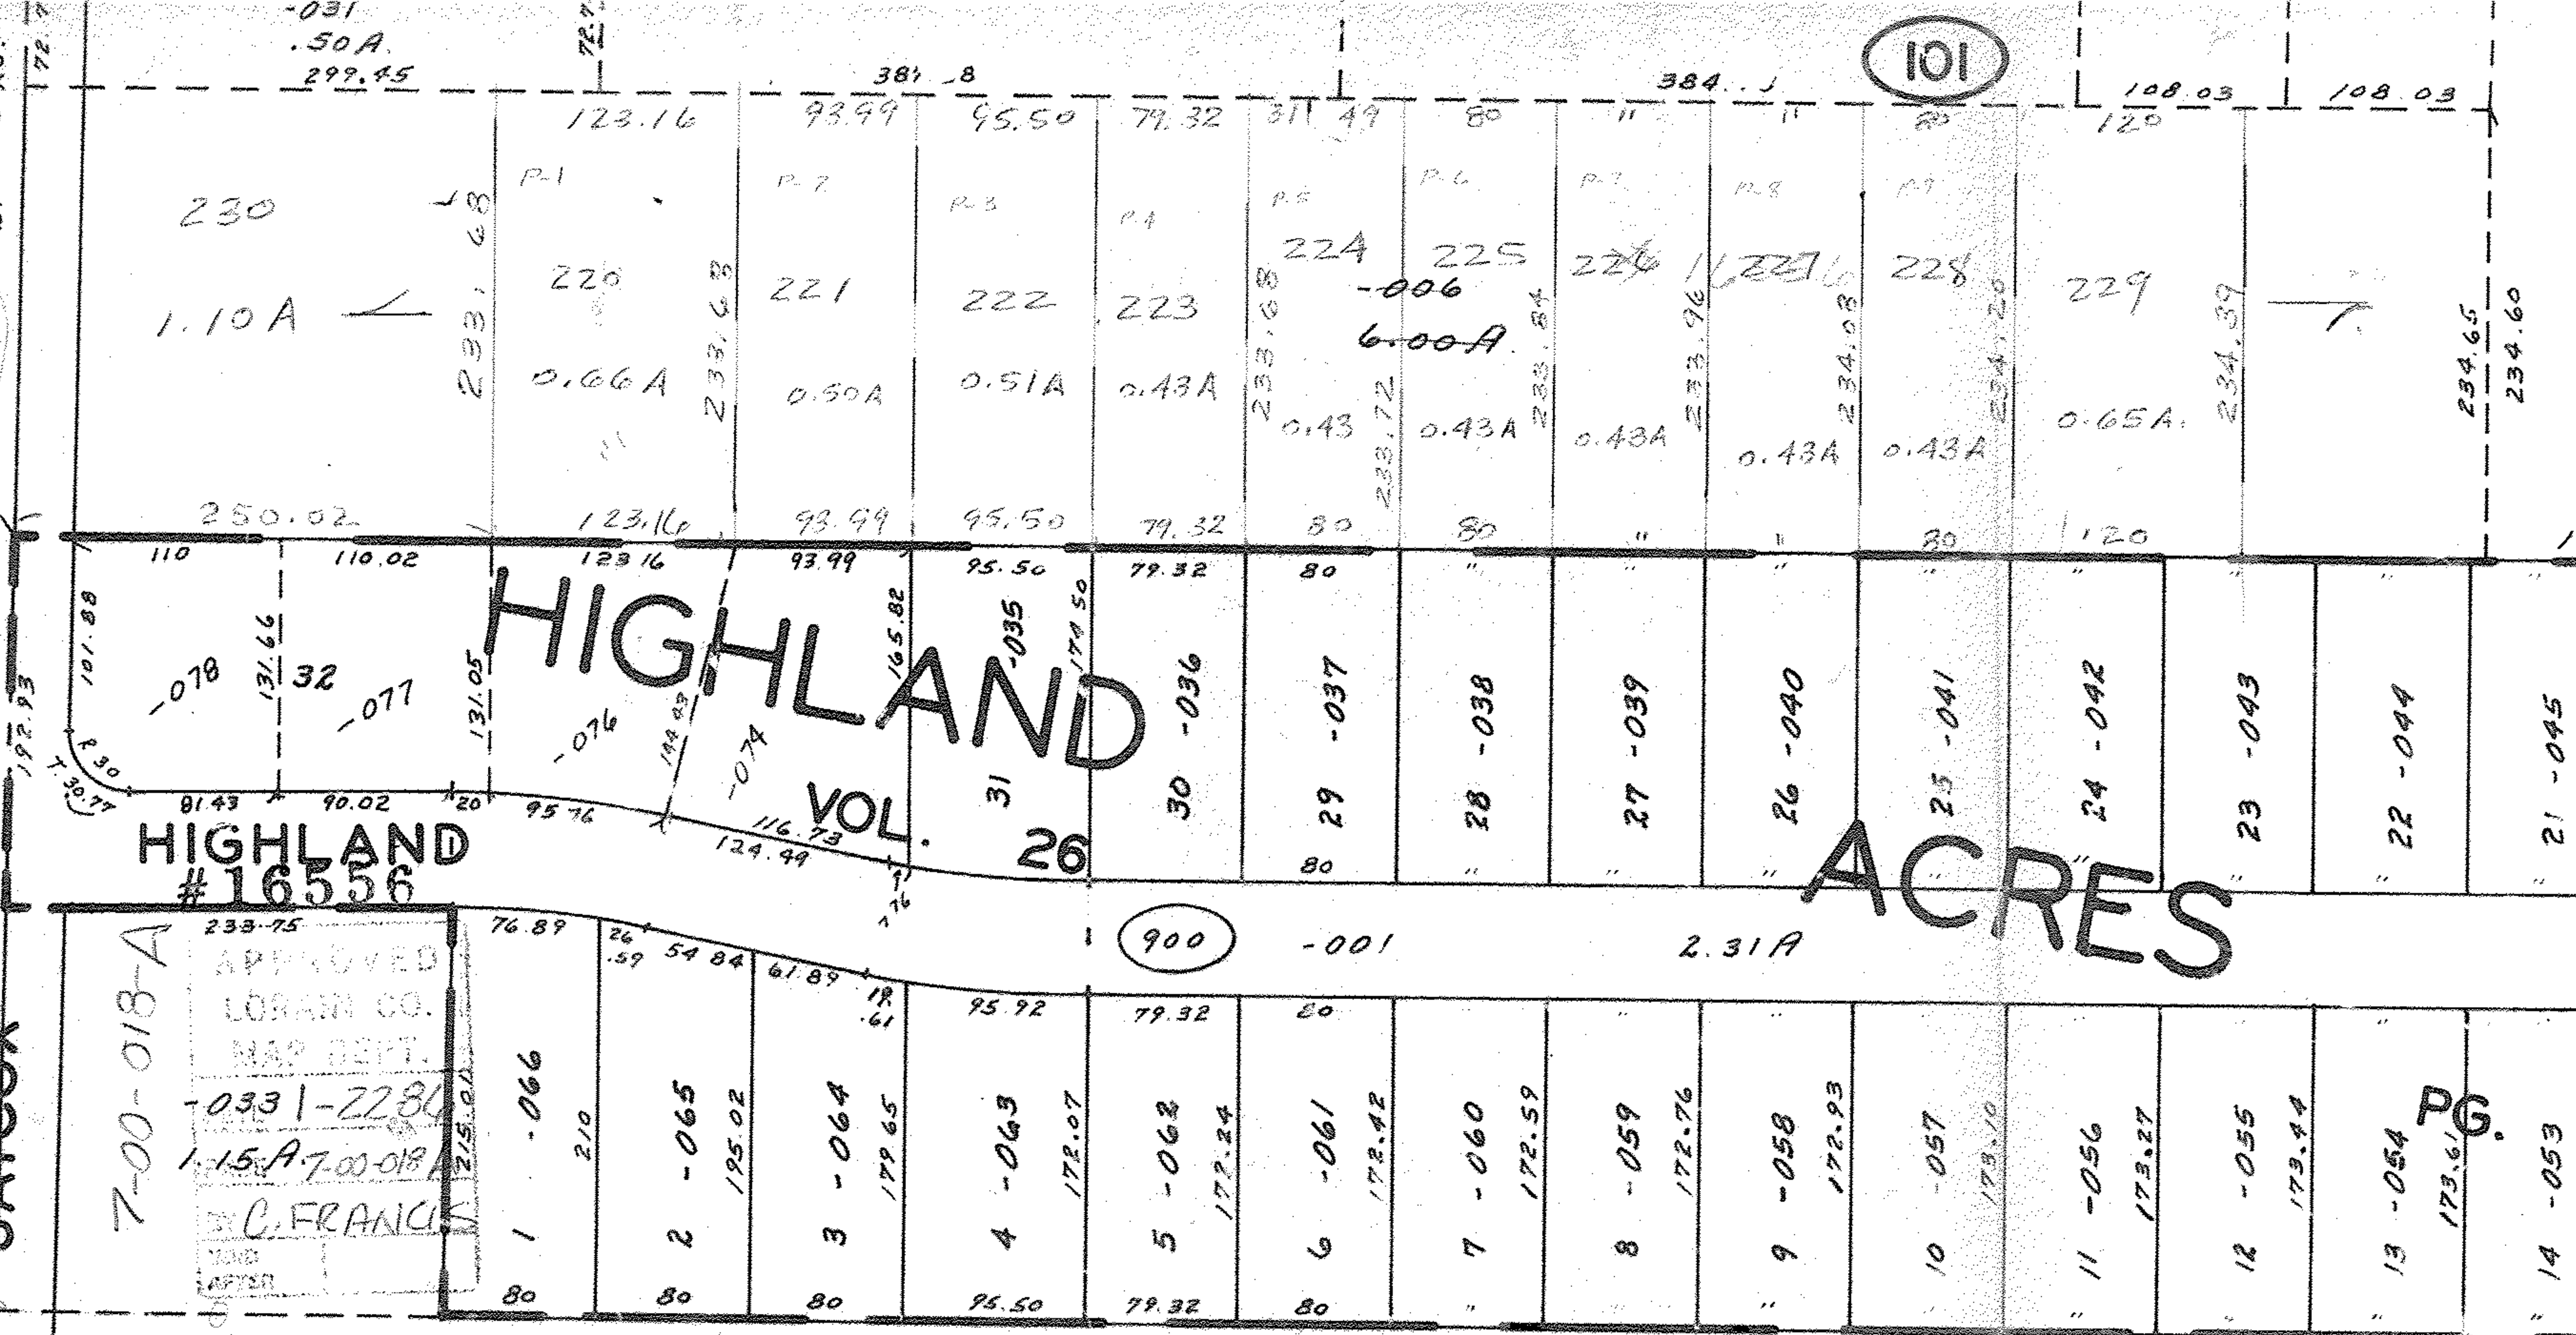

HIGHLAND #16556

HIGHLAND VOL. 26

ACRES

900

7-00-018-A

APPROVED
LORAIN CO.
MAP DEPT.
-0331-2286
1-15-A-7-00-018
BY C. FRANCIS
MAY 1957

4-1-86

SEE 7-00-018-C