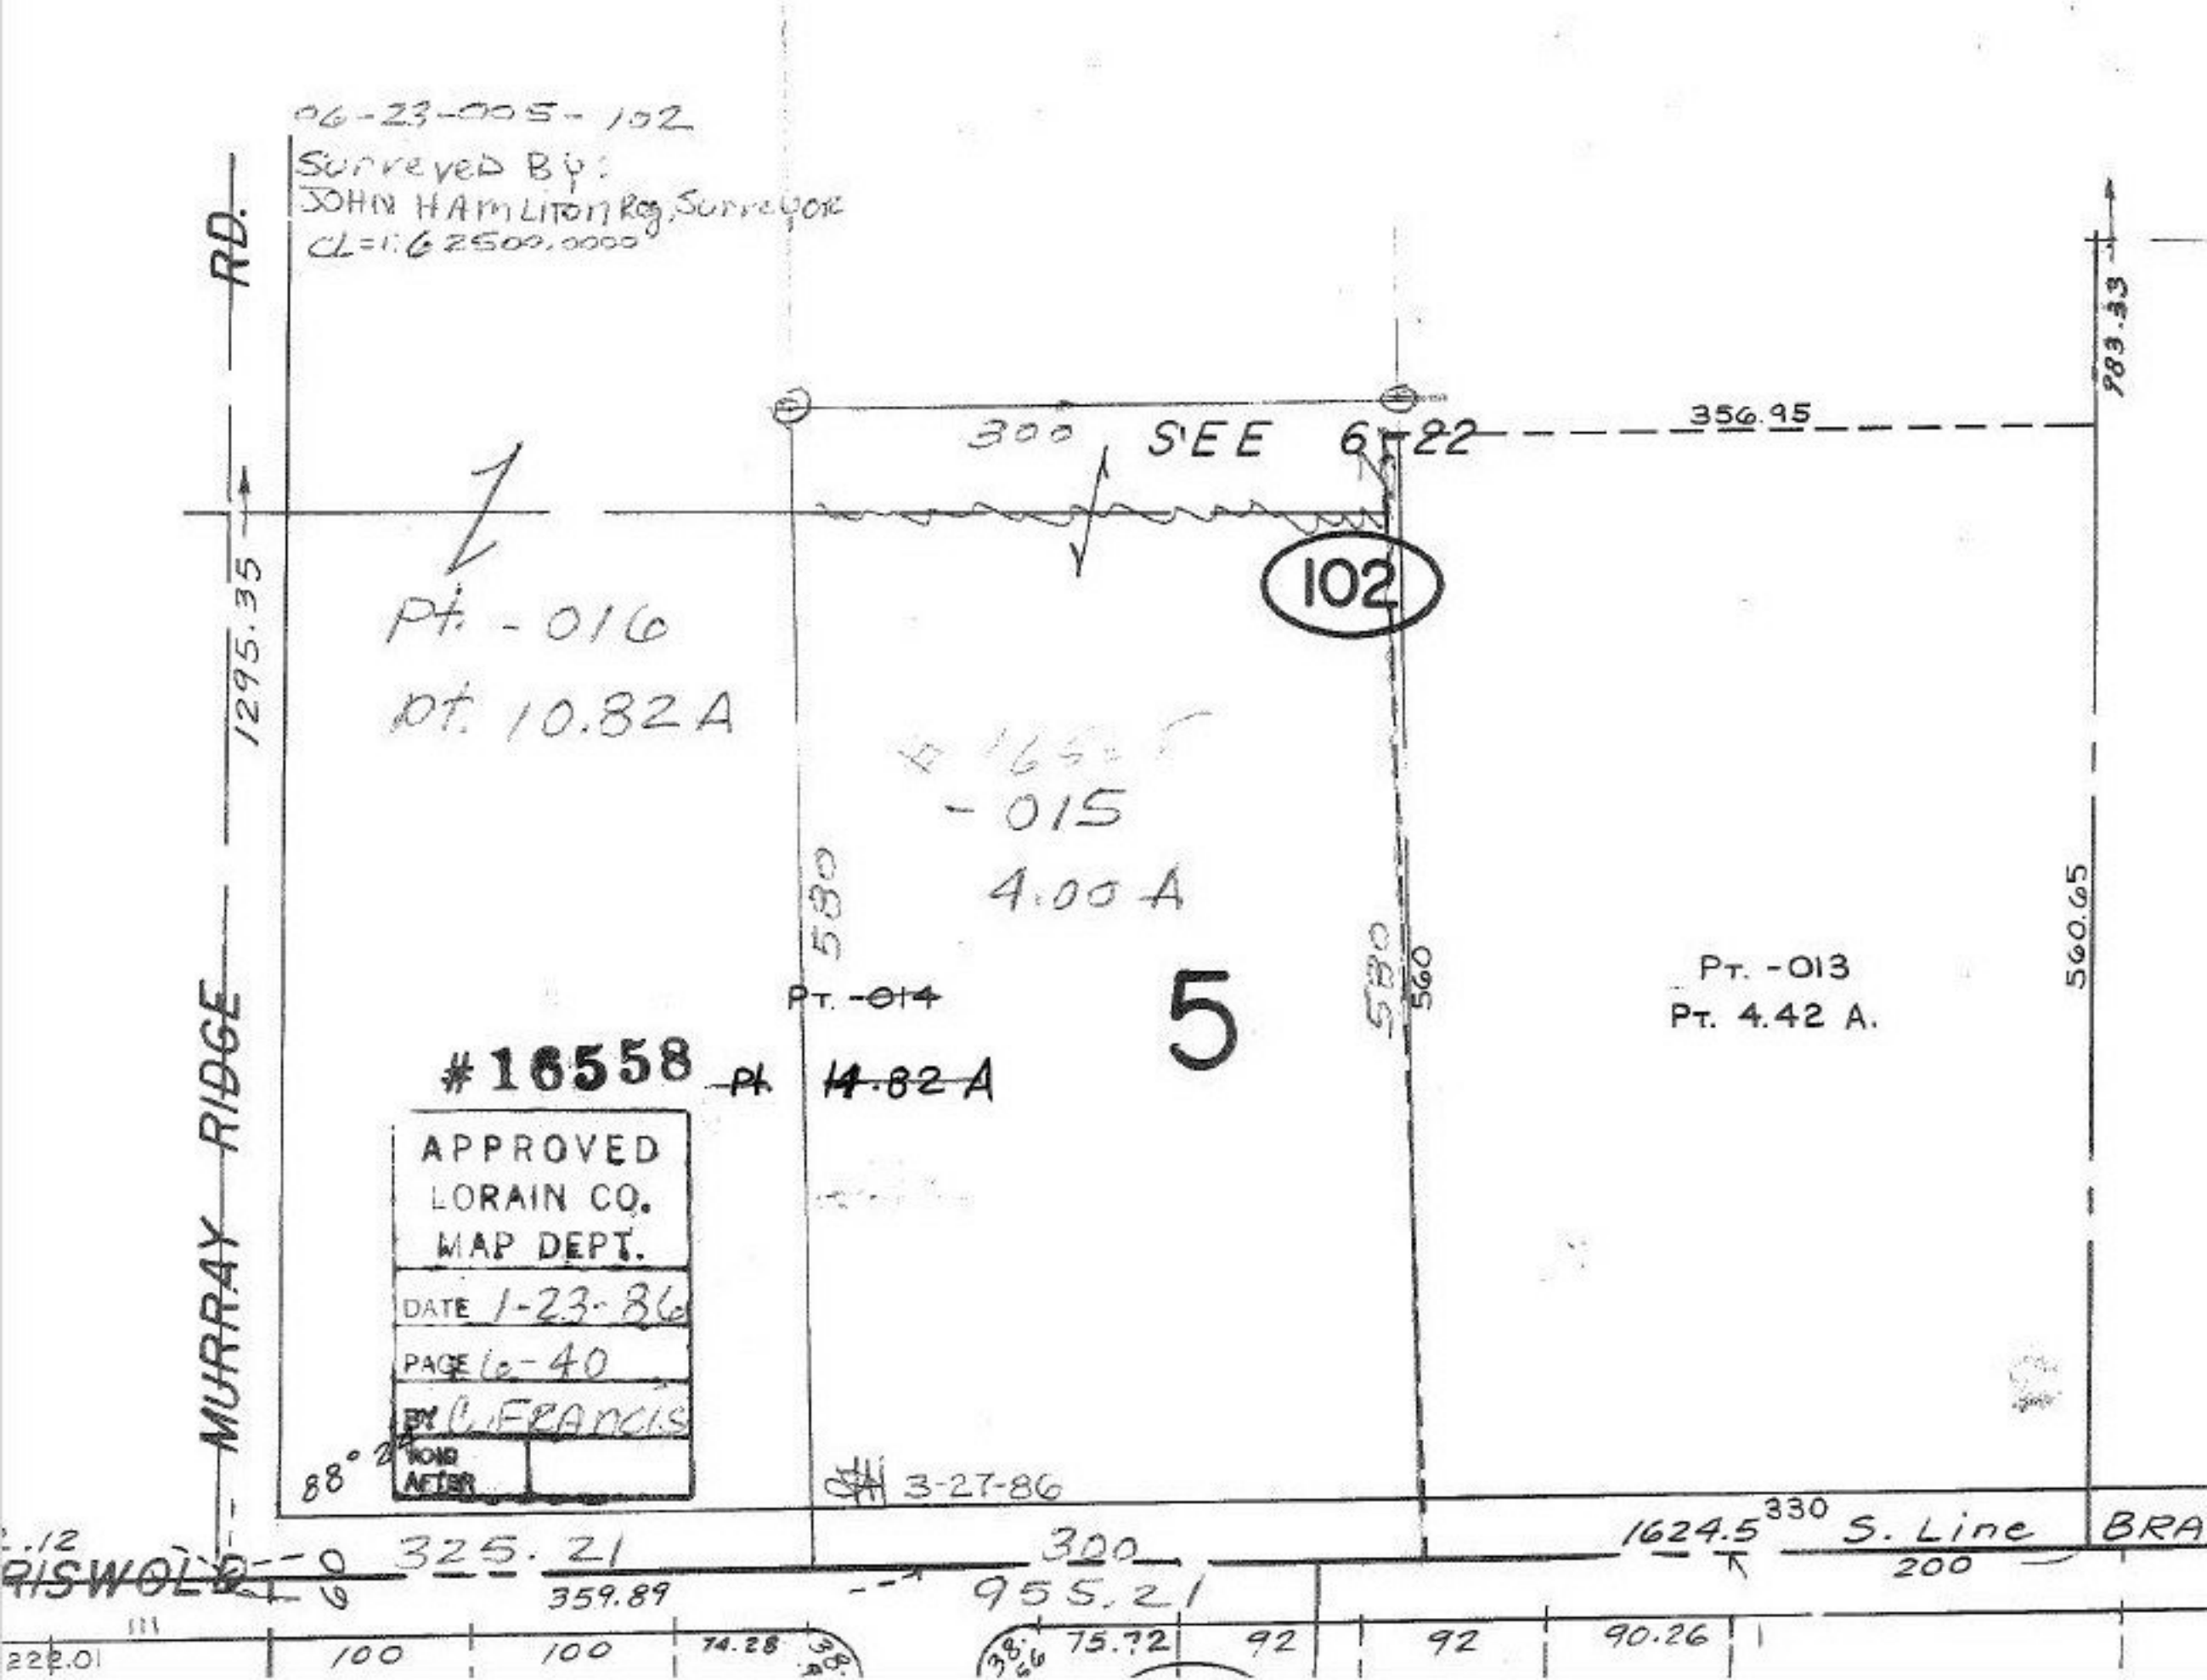
06-23-005-102
Surveyed By:
JOHN HAMLITON Reg. Surveyor
CL=1:62500.0000
RD.
MURRAY RIDGE
1295.35
300
SEE 6-22
356.95
983.33
102
Pt. -016
Pt. 10.82 A
-015
4.00 A
580
Pt. -014
5
580
560
Pt. -013
Pt. 4.42 A.
560.65
#16558 Pt. 14.82 A
APPROVED
LORAIN CO.
MAP DEPT.
DATE 1-23-86
PAGE 6-40
BY C. FRANCIS
VOID AFTER
88° 24
3-27-86
RISWOLD
325.21
300
1624.5
330
S. Line
BRA
200
359.89
955.21
222.01
100
100
74.28
75.72
92
92
90.26