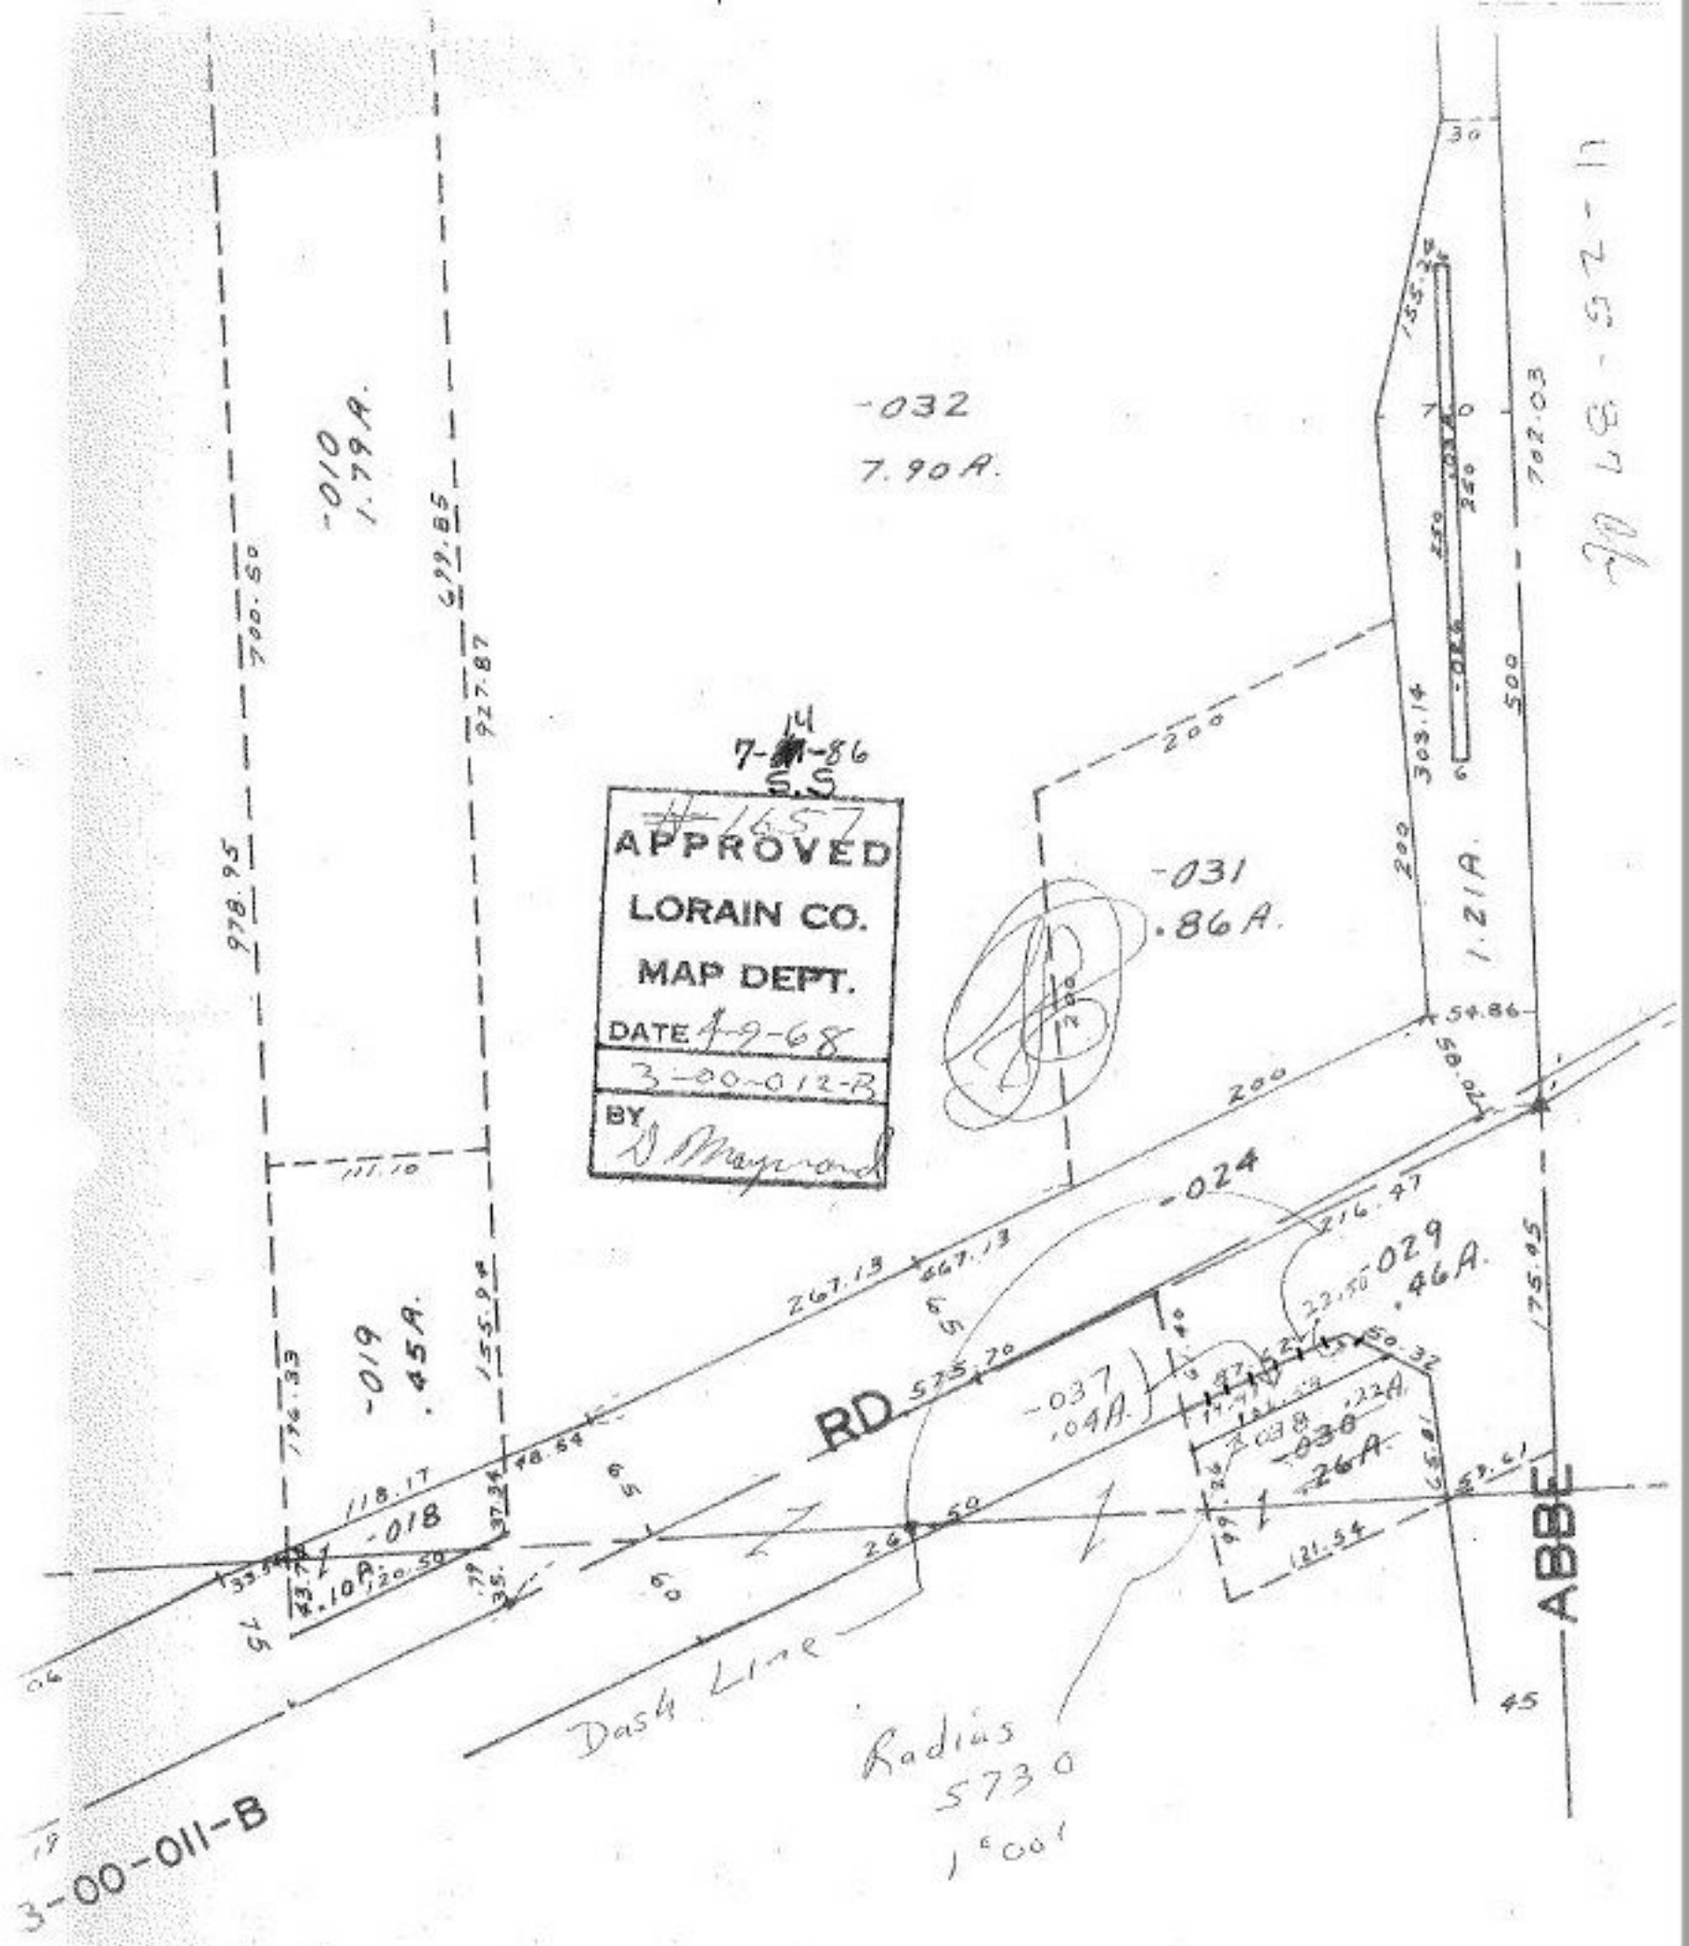

E. PT. LOT 12

Done 5-4-68
LW Hall