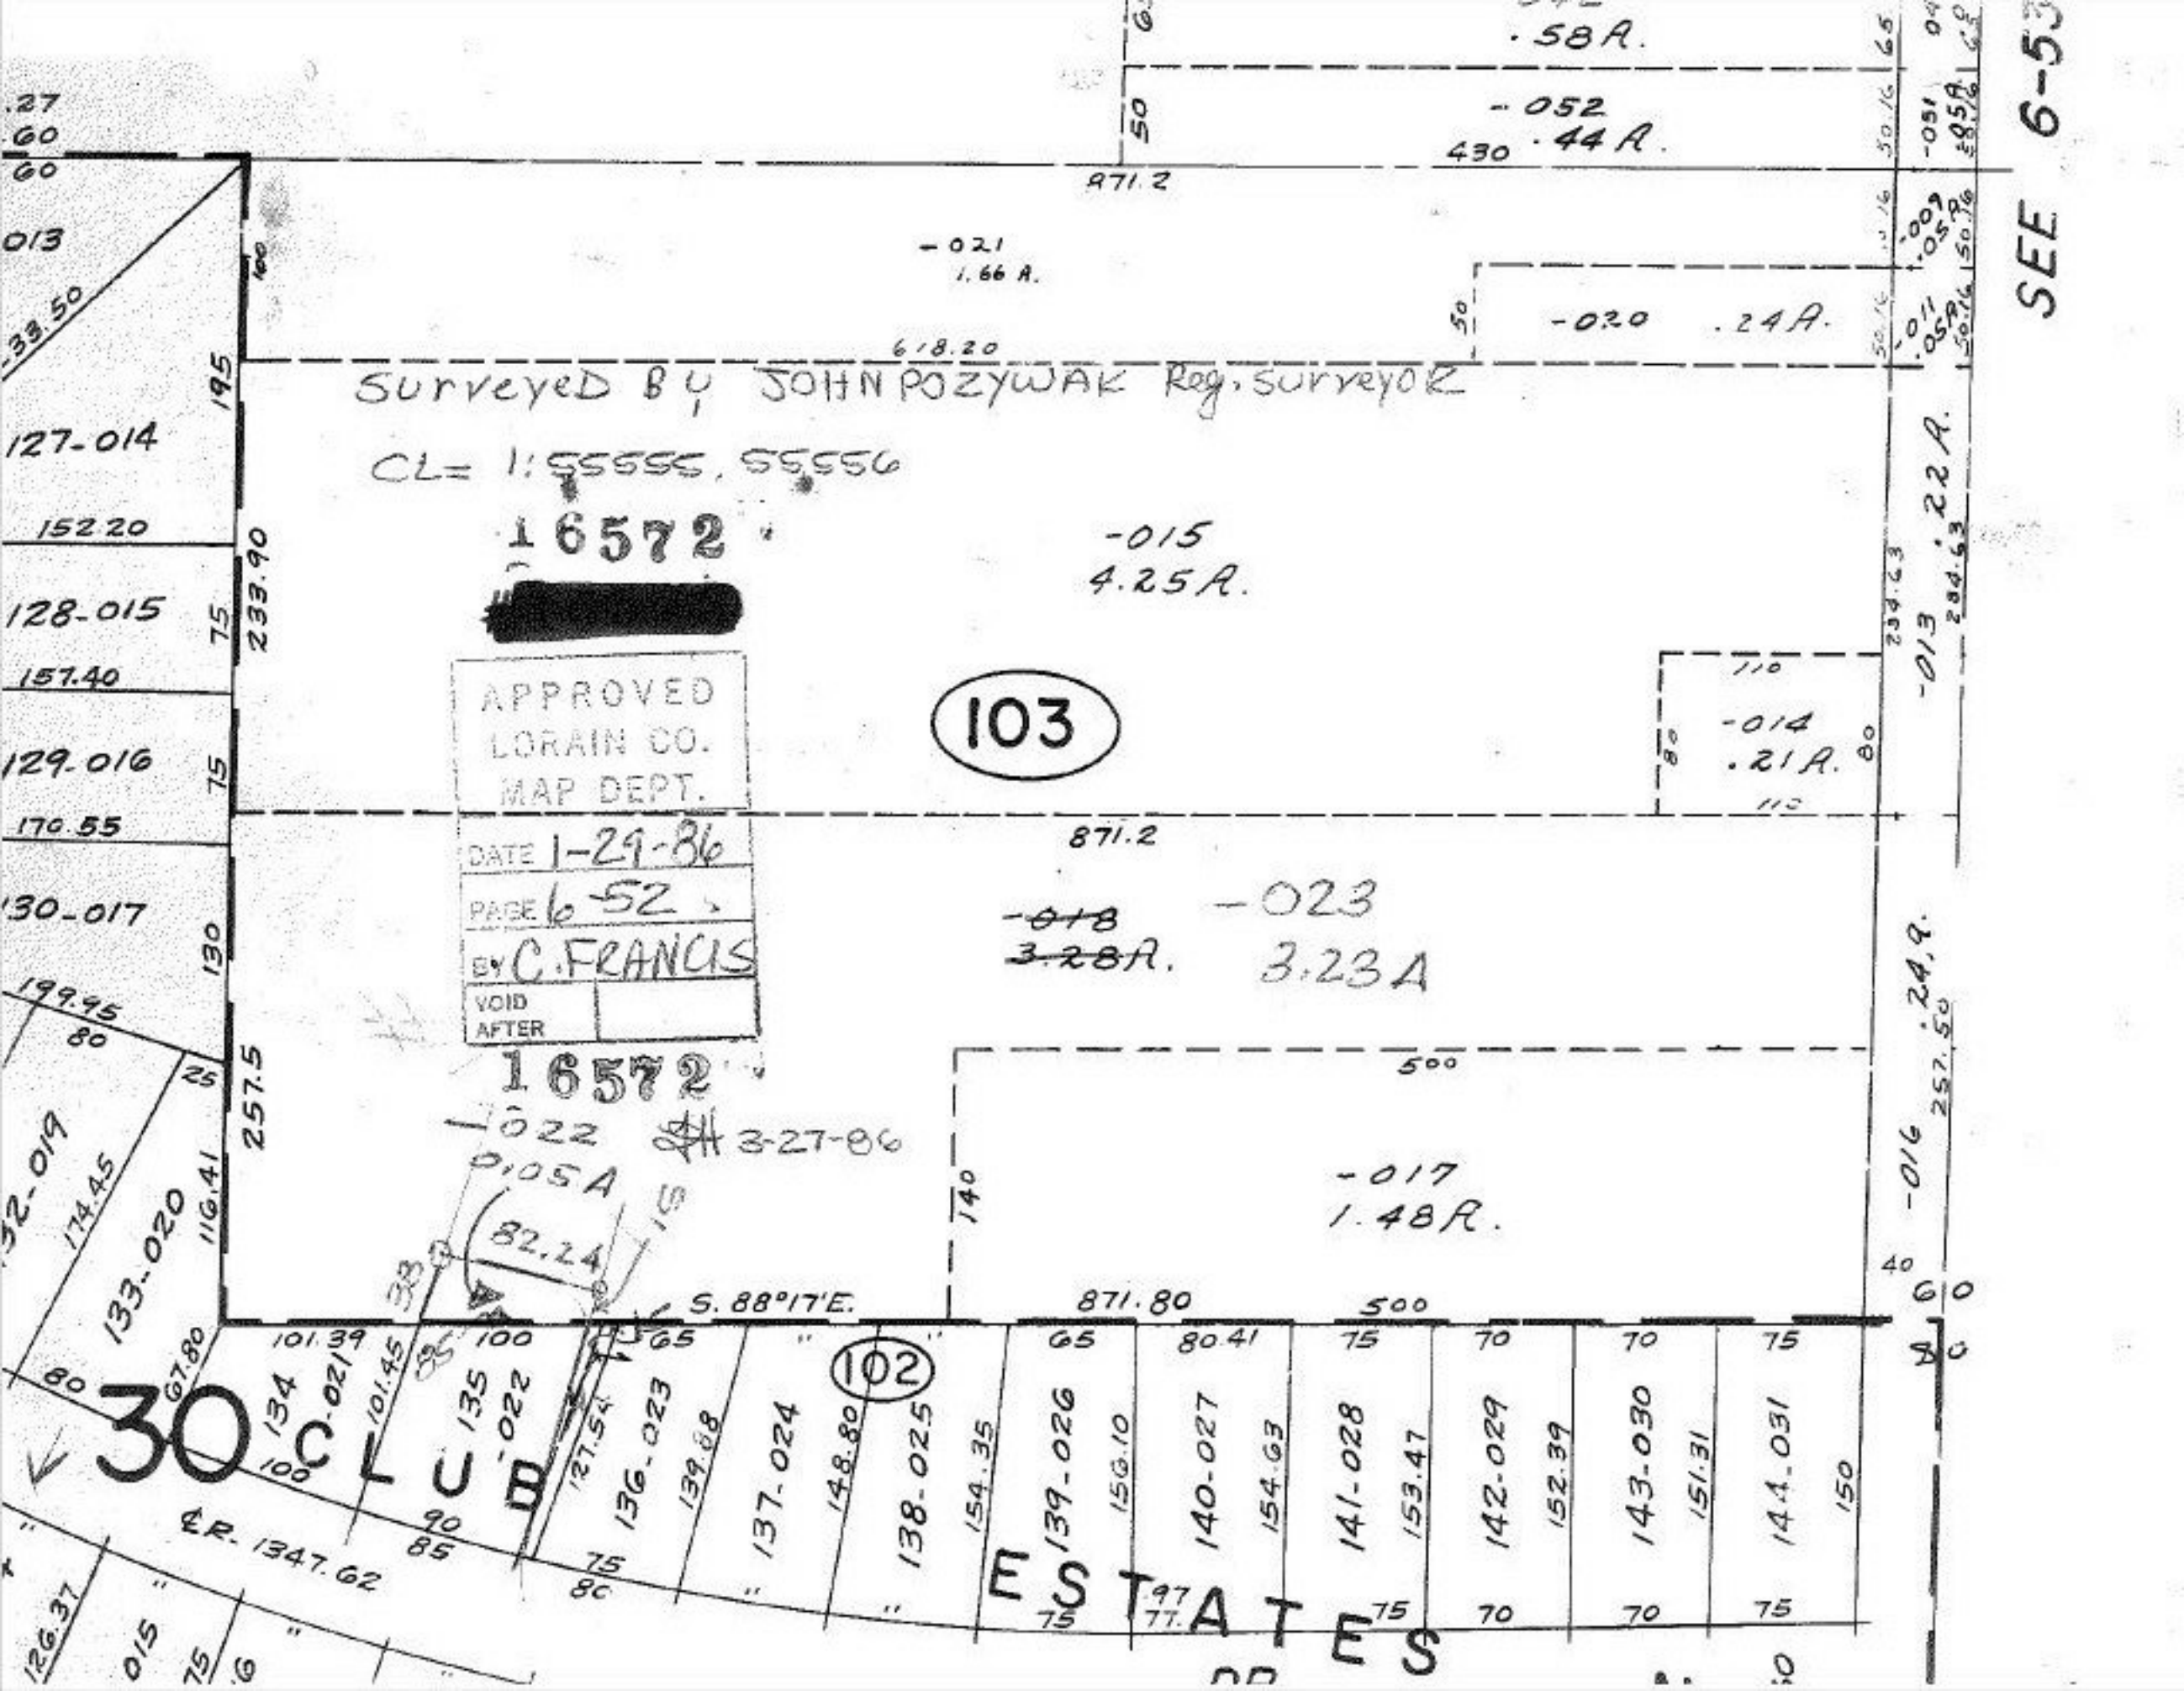

SEE 6-53
.58 A.
-052
.44 A.
430
871.2
-021
1.66 A.
-020
.24 A.
618.20
Surveyed By JOHN POZYWAK Reg. Surveyor
CL= 1:55555, 55556
16572
[redacted]
-015
4.25 A.
APPROVED
LORAIN CO.
MAP DEPT.
DATE 1-29-86
PAGE 6-52
BY C. FRANCIS
VOID AFTER
103
-014
.21 A.
871.2
-018
3.28 A.
-023
3.23 A
16572
-022
3-27-86
0.05 A
82.24
-017
1.48 A.
S. 88°17'E.
871.80
500
102
30 CLUB
ESTATES
127-014
128-015
129-016
130-017
133-020
134-021
135-022
136-023
137-024
138-025
139-026
140-027
141-028
142-029
143-030
144-031
℄ R. 1347.62