SEE 2-02-019-B

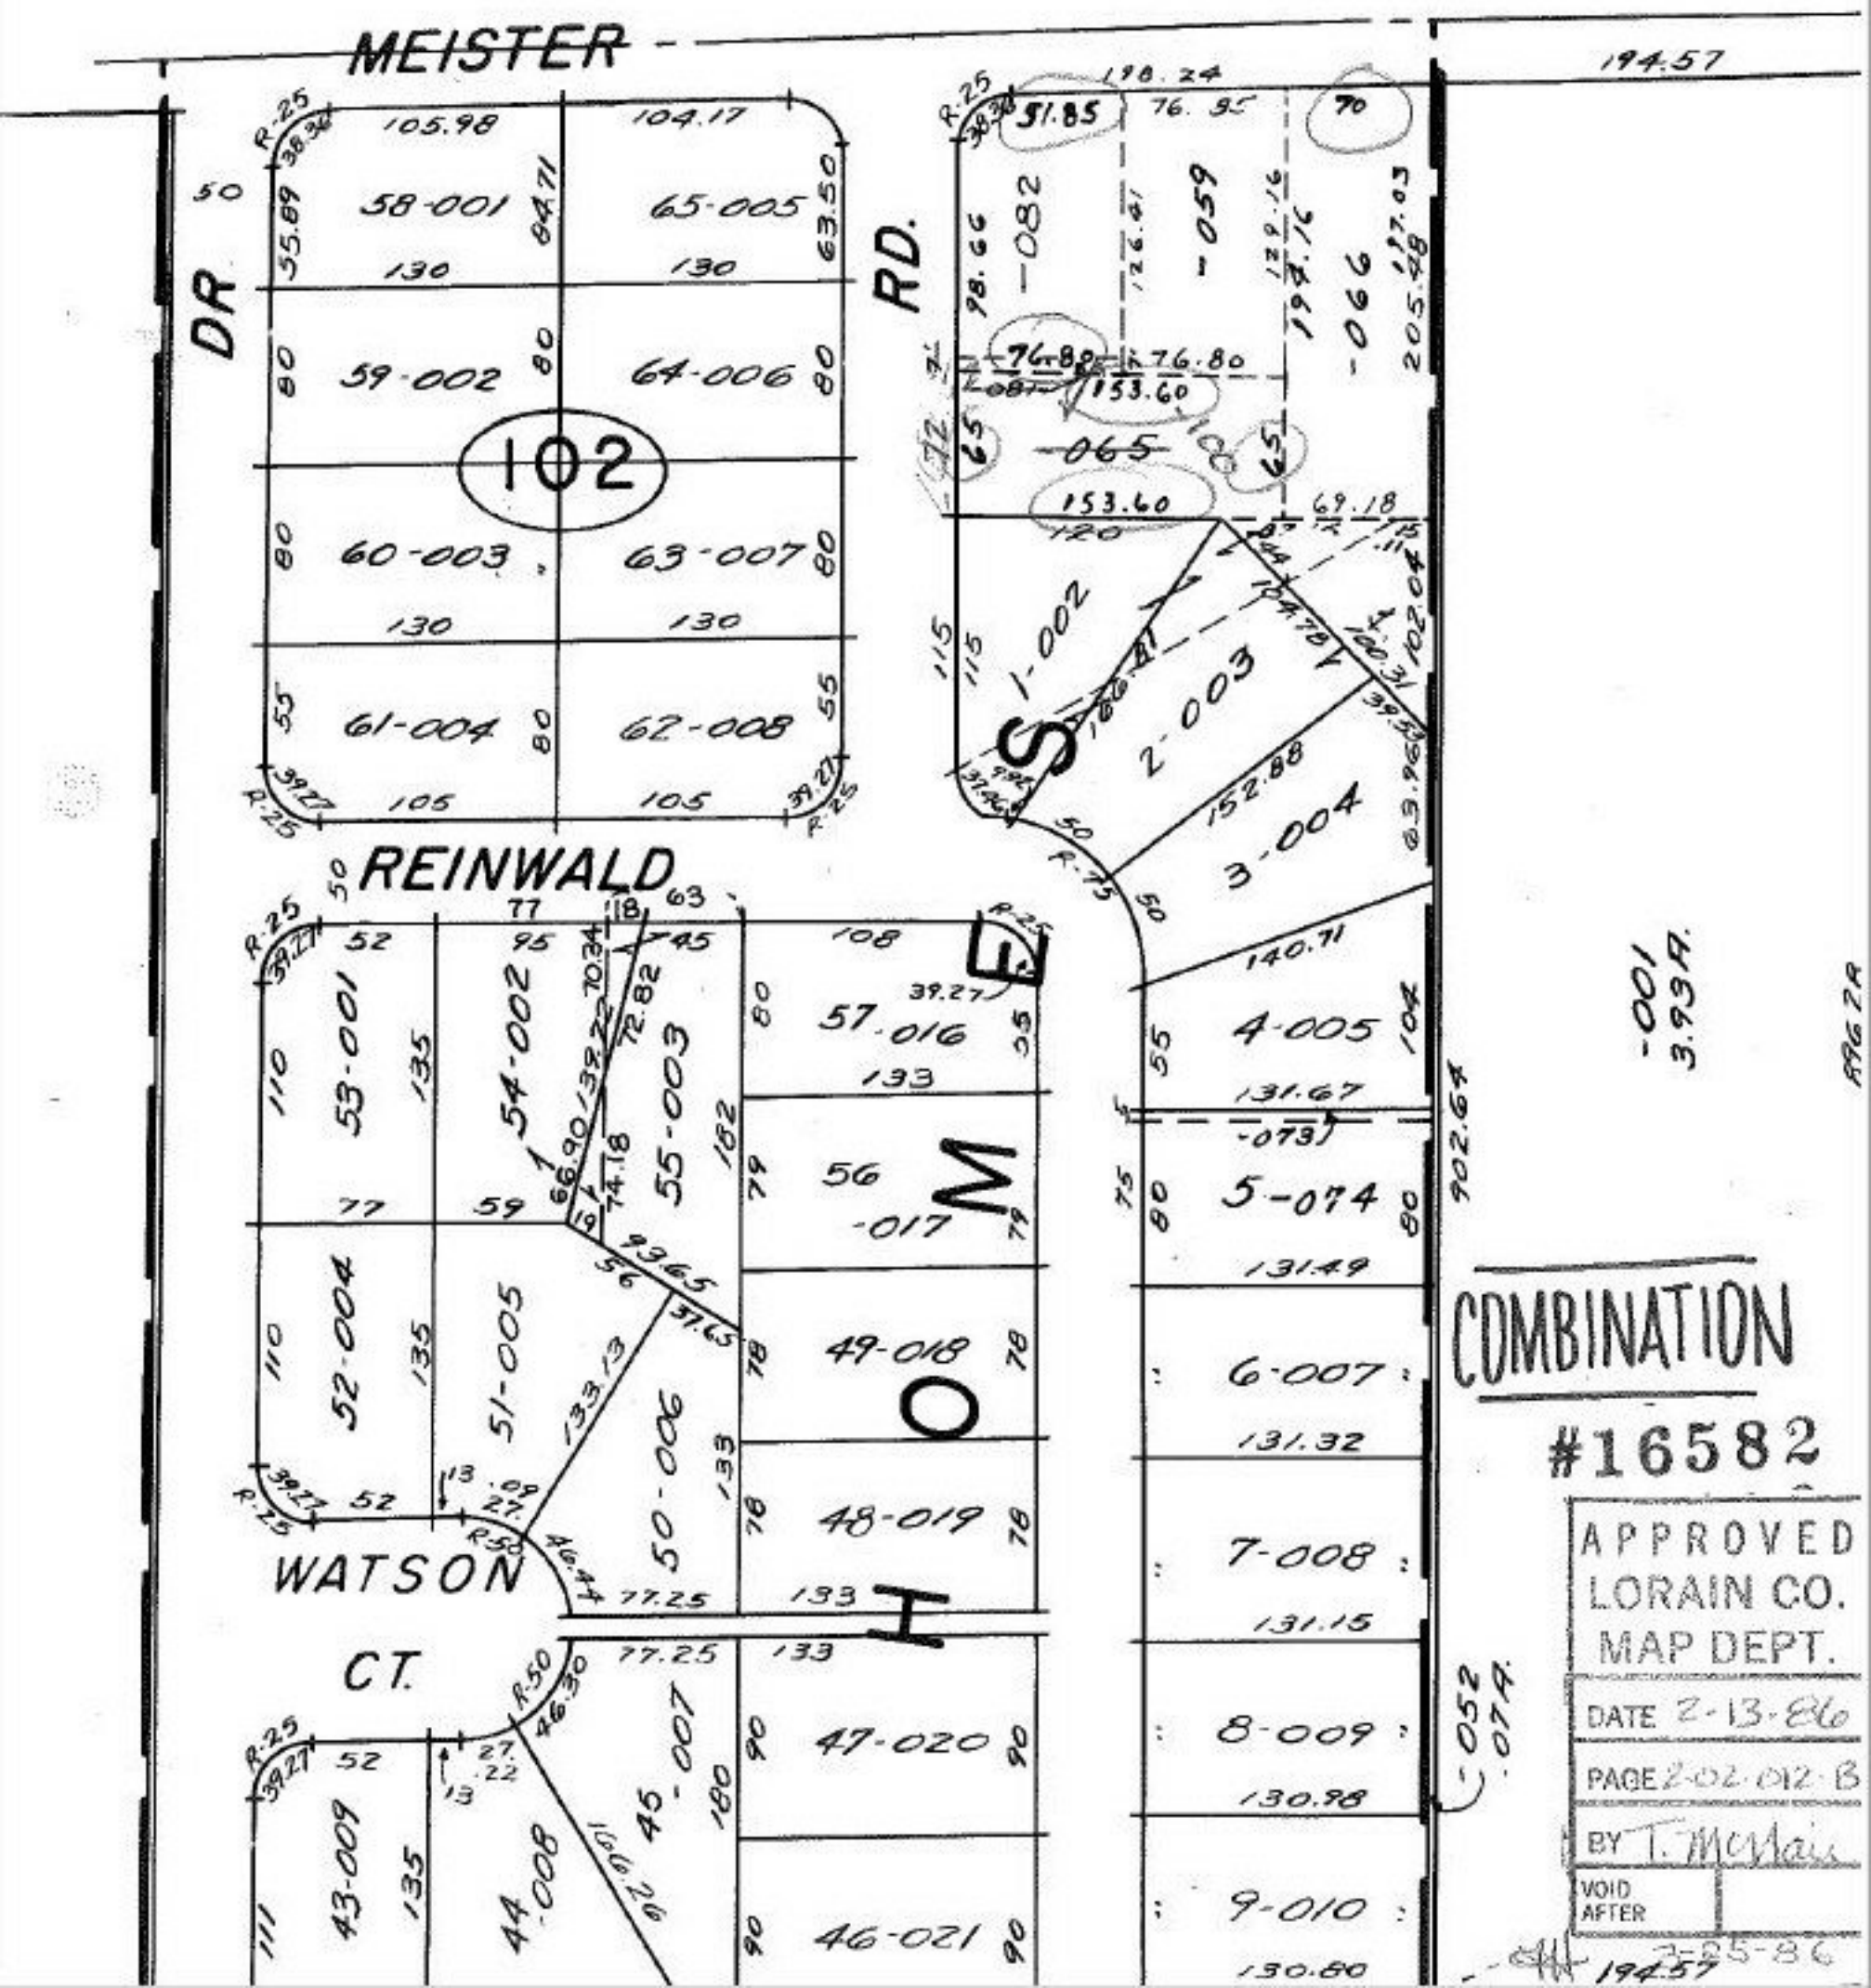
MEISTER
DR
RD.
REINWALD
WATSON
CT.
102
58-001
65-005
59-002
64-006
60-003
63-007
61-004
62-008
53-001
54-002
55-003
57-016
56-017
52-004
51-005
50-006
49-018
48-019
47-020
46-021
43-009
44-008
45-007
1-002
2-003
3-004
4-005
5-074
6-007
7-008
8-009
9-010
-082
-059
-066
-065
-001
3.93A.
-052
.07A.
194.57
902.64
COMBINATION
#16582
APPROVED
LORAIN CO.
MAP DEPT.
DATE 2-13-86
PAGE 2-02-012-B
BY T. McNair
VOID AFTER
2-25-86