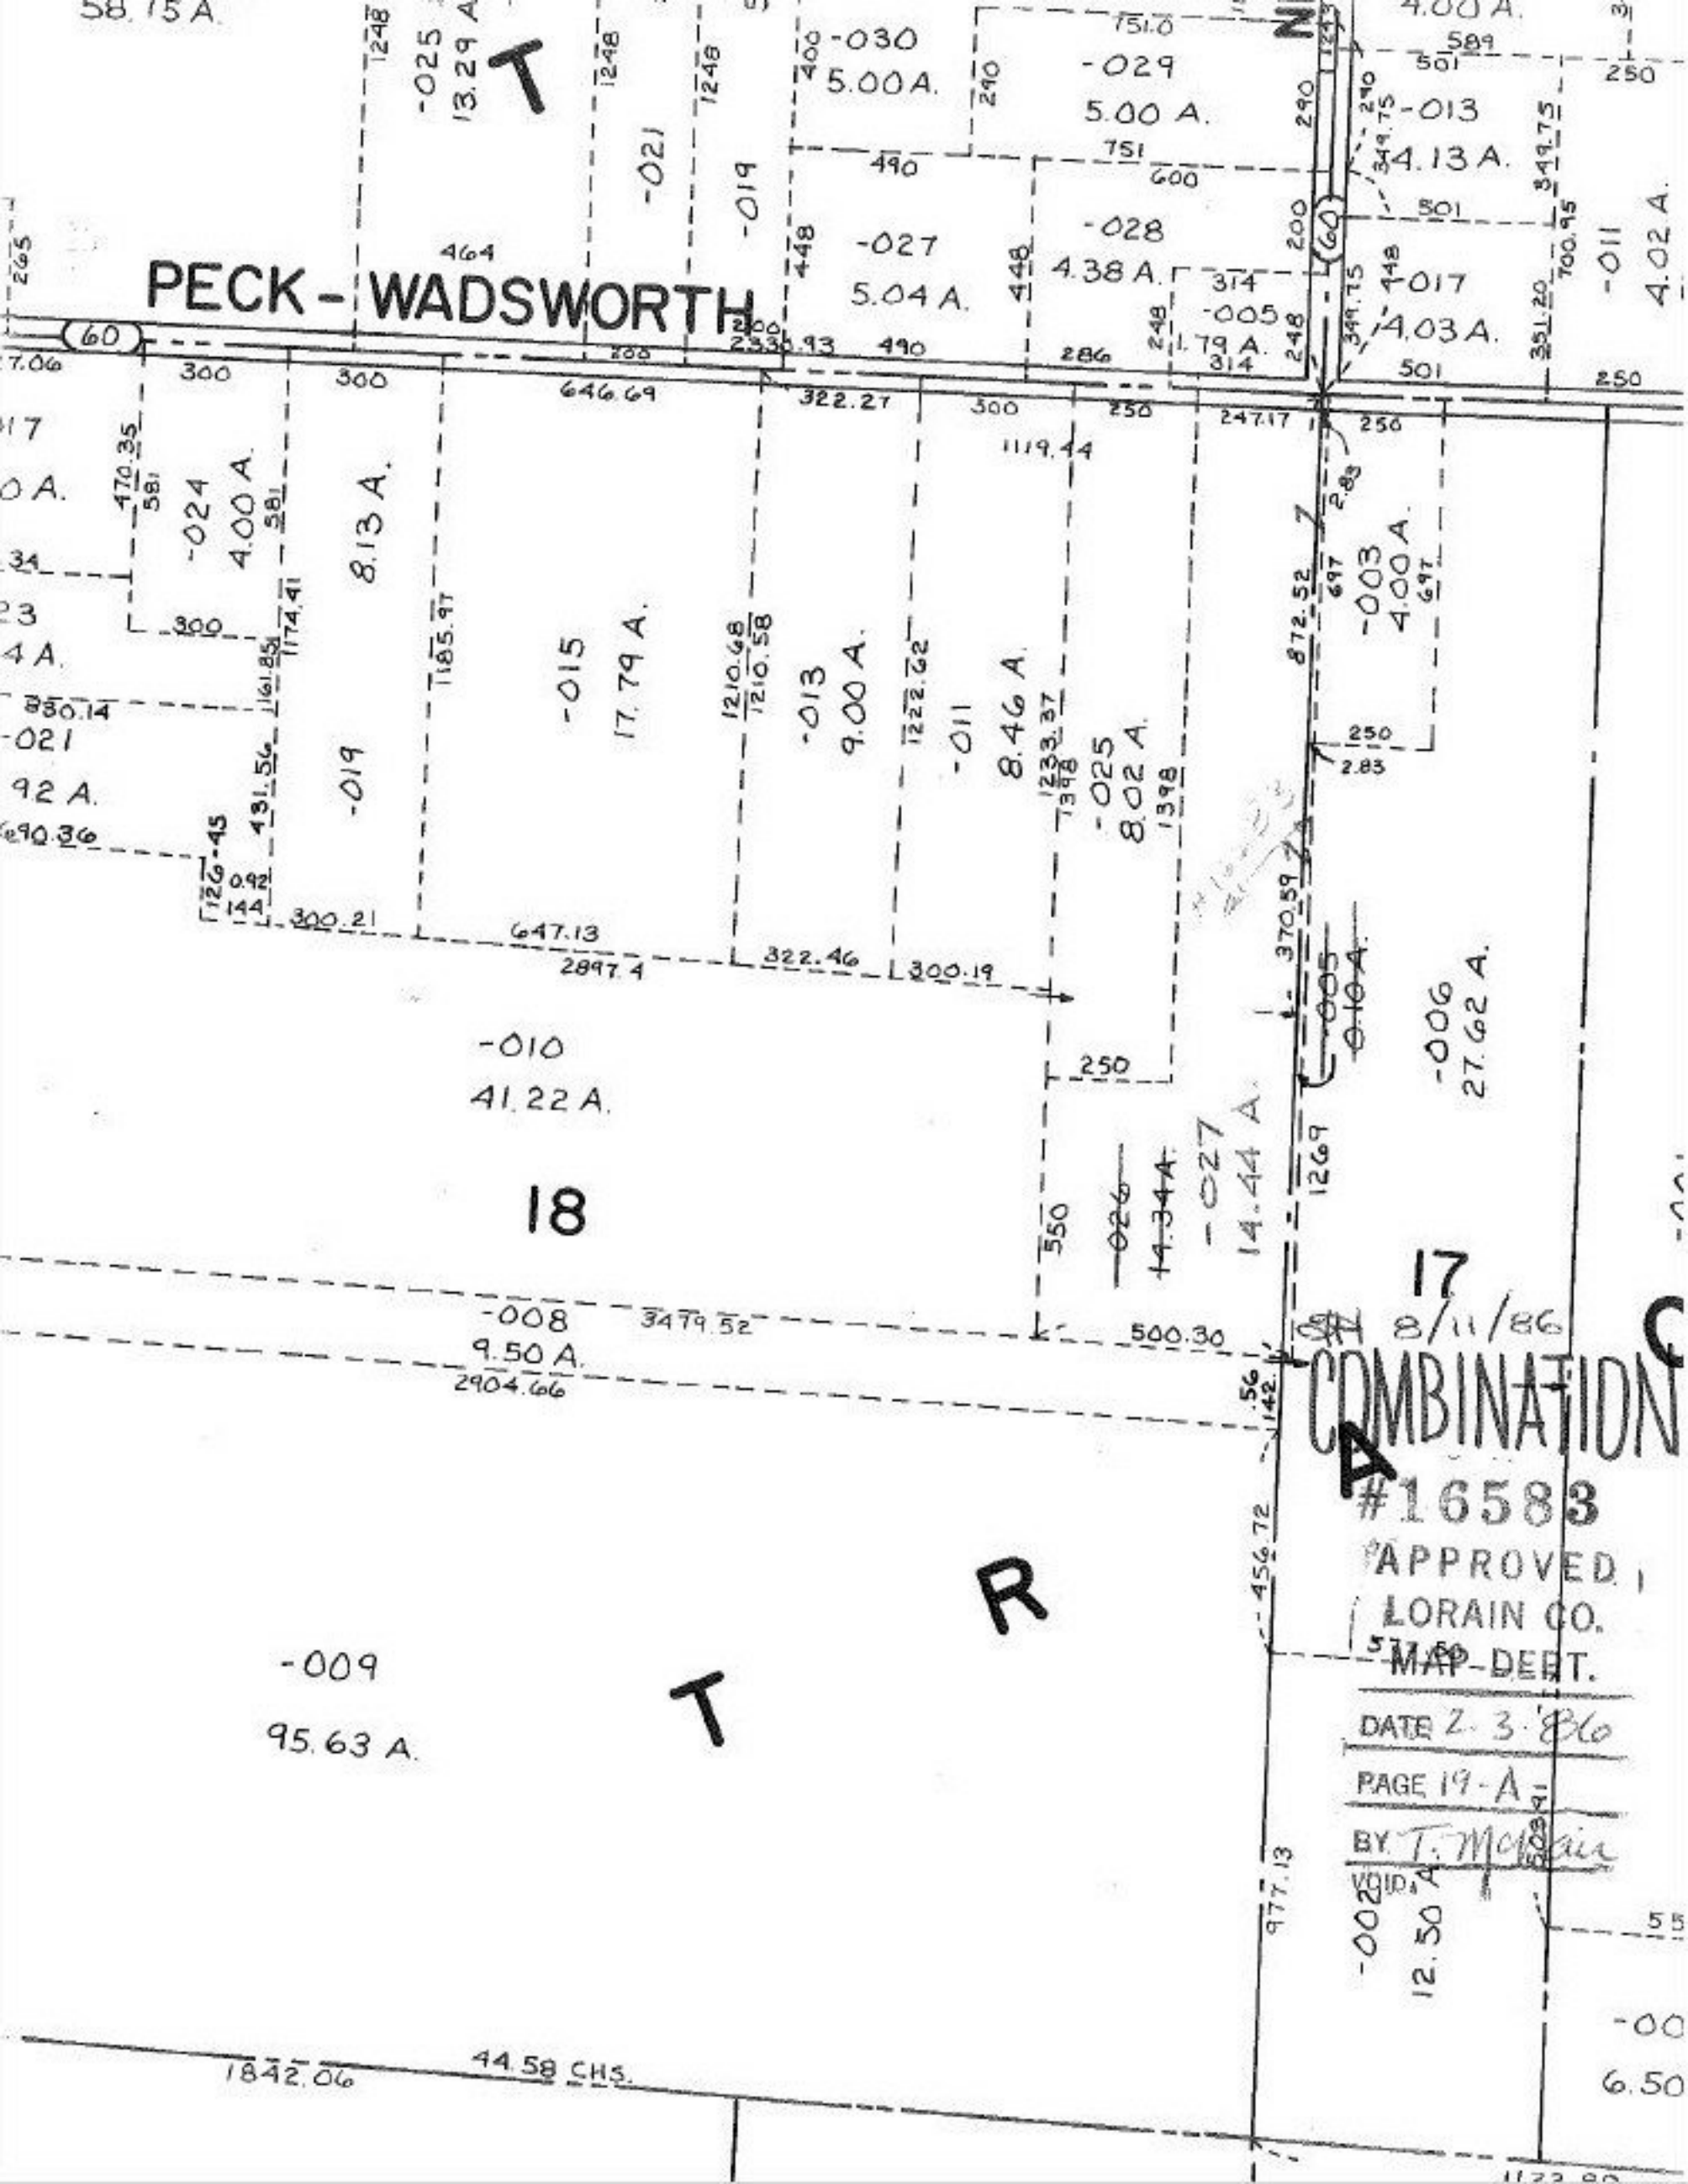
PECK - WADSWORTH
T
R
A
C
18
17
-025
13.29 A.
-030
5.00 A.
-029
5.00 A.
-013
4.13 A.
-021
-019
-027
5.04 A.
-028
4.38 A.
-005
1.79 A.
-017
4.03 A.
-011
4.02 A.
-024
4.00 A.
8.13 A.
-015
17.79 A.
-013
9.00 A.
-011
8.46 A.
-025
8.02 A.
-003
4.00 A.
-021
92 A.
-010
41.22 A.
-006
27.62 A.
-027
14.44 A.
-008
9.50 A.
-009
95.63 A.
-002
12.50 A.
-00
6.50
44.58 CHS.
1842.06
8/11/86
COMBINATION
#16583
APPROVED
LORAIN CO.
MAP DEPT.
DATE 2-3-86
PAGE 19-A
BY T. McKain
VOID