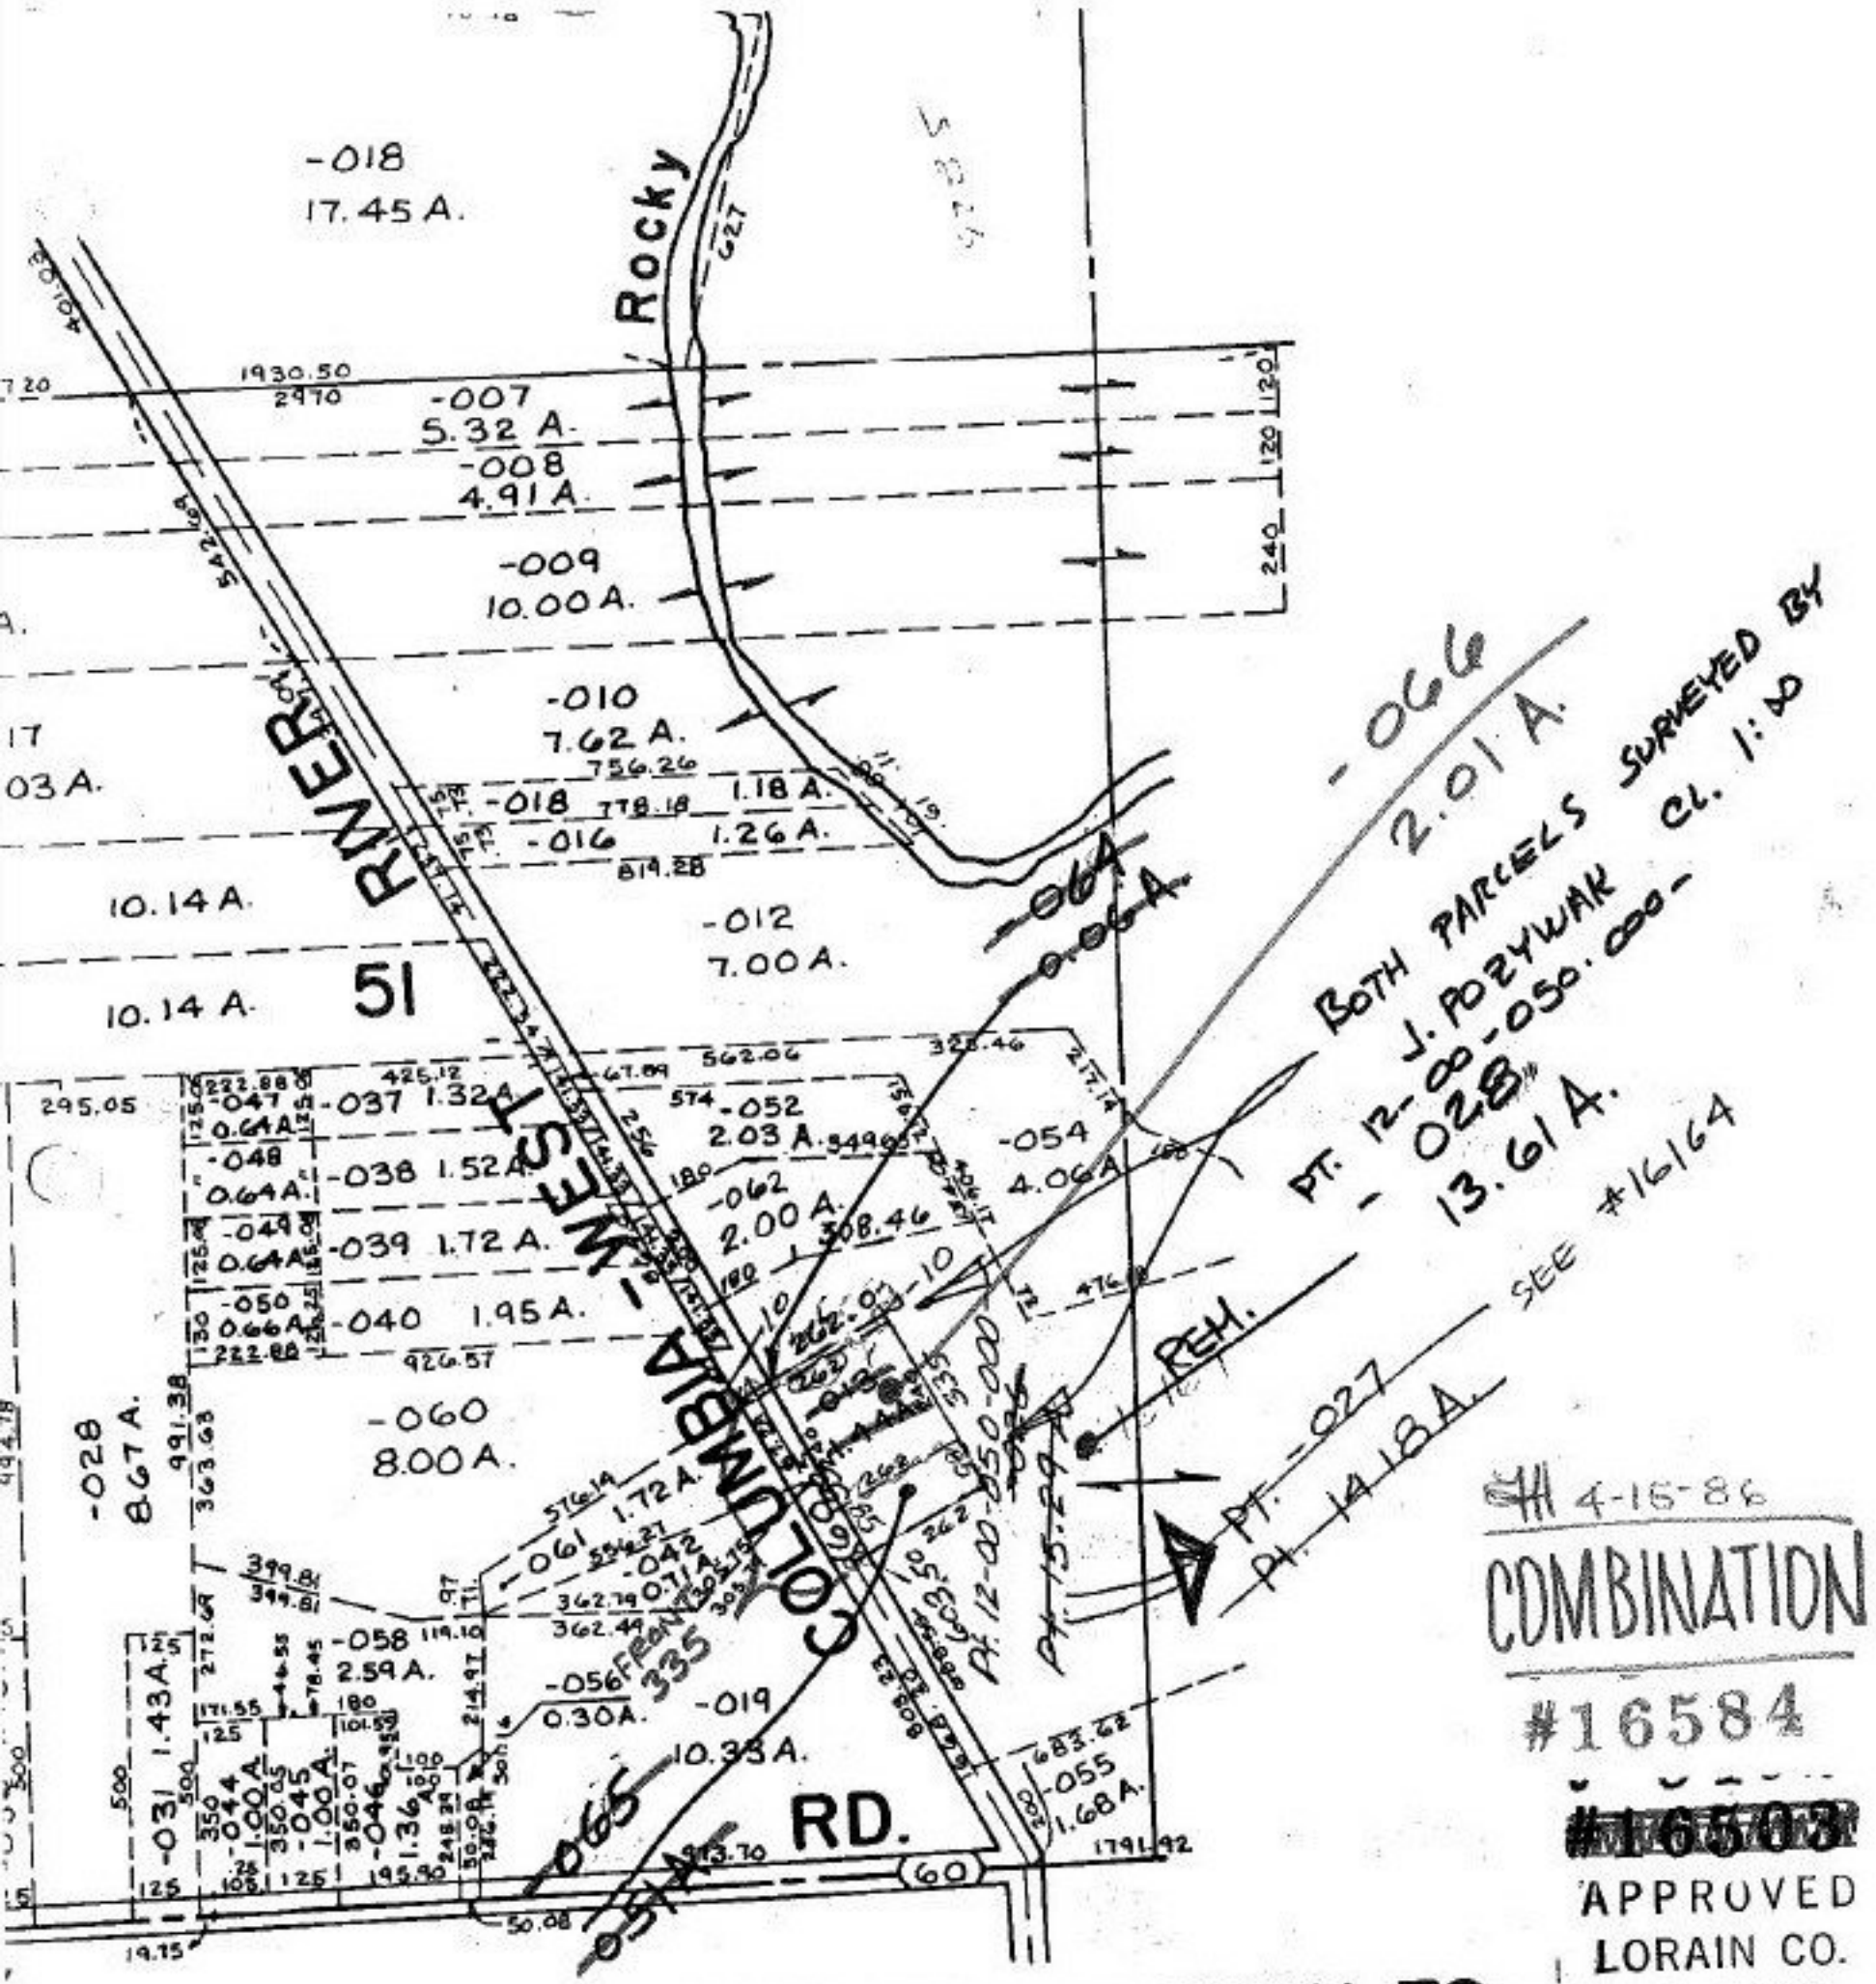

LOTS 51 THRU 55, 66 THRU 70

4-16-86

COMBINATION

#16584

~~#16503~~

APPROVED
LORAIN CO.
MAP DEPT.

DATE 1.8.86

PAGE 12-F

BY T. McMain

VOID