SEE 4-00-022-G

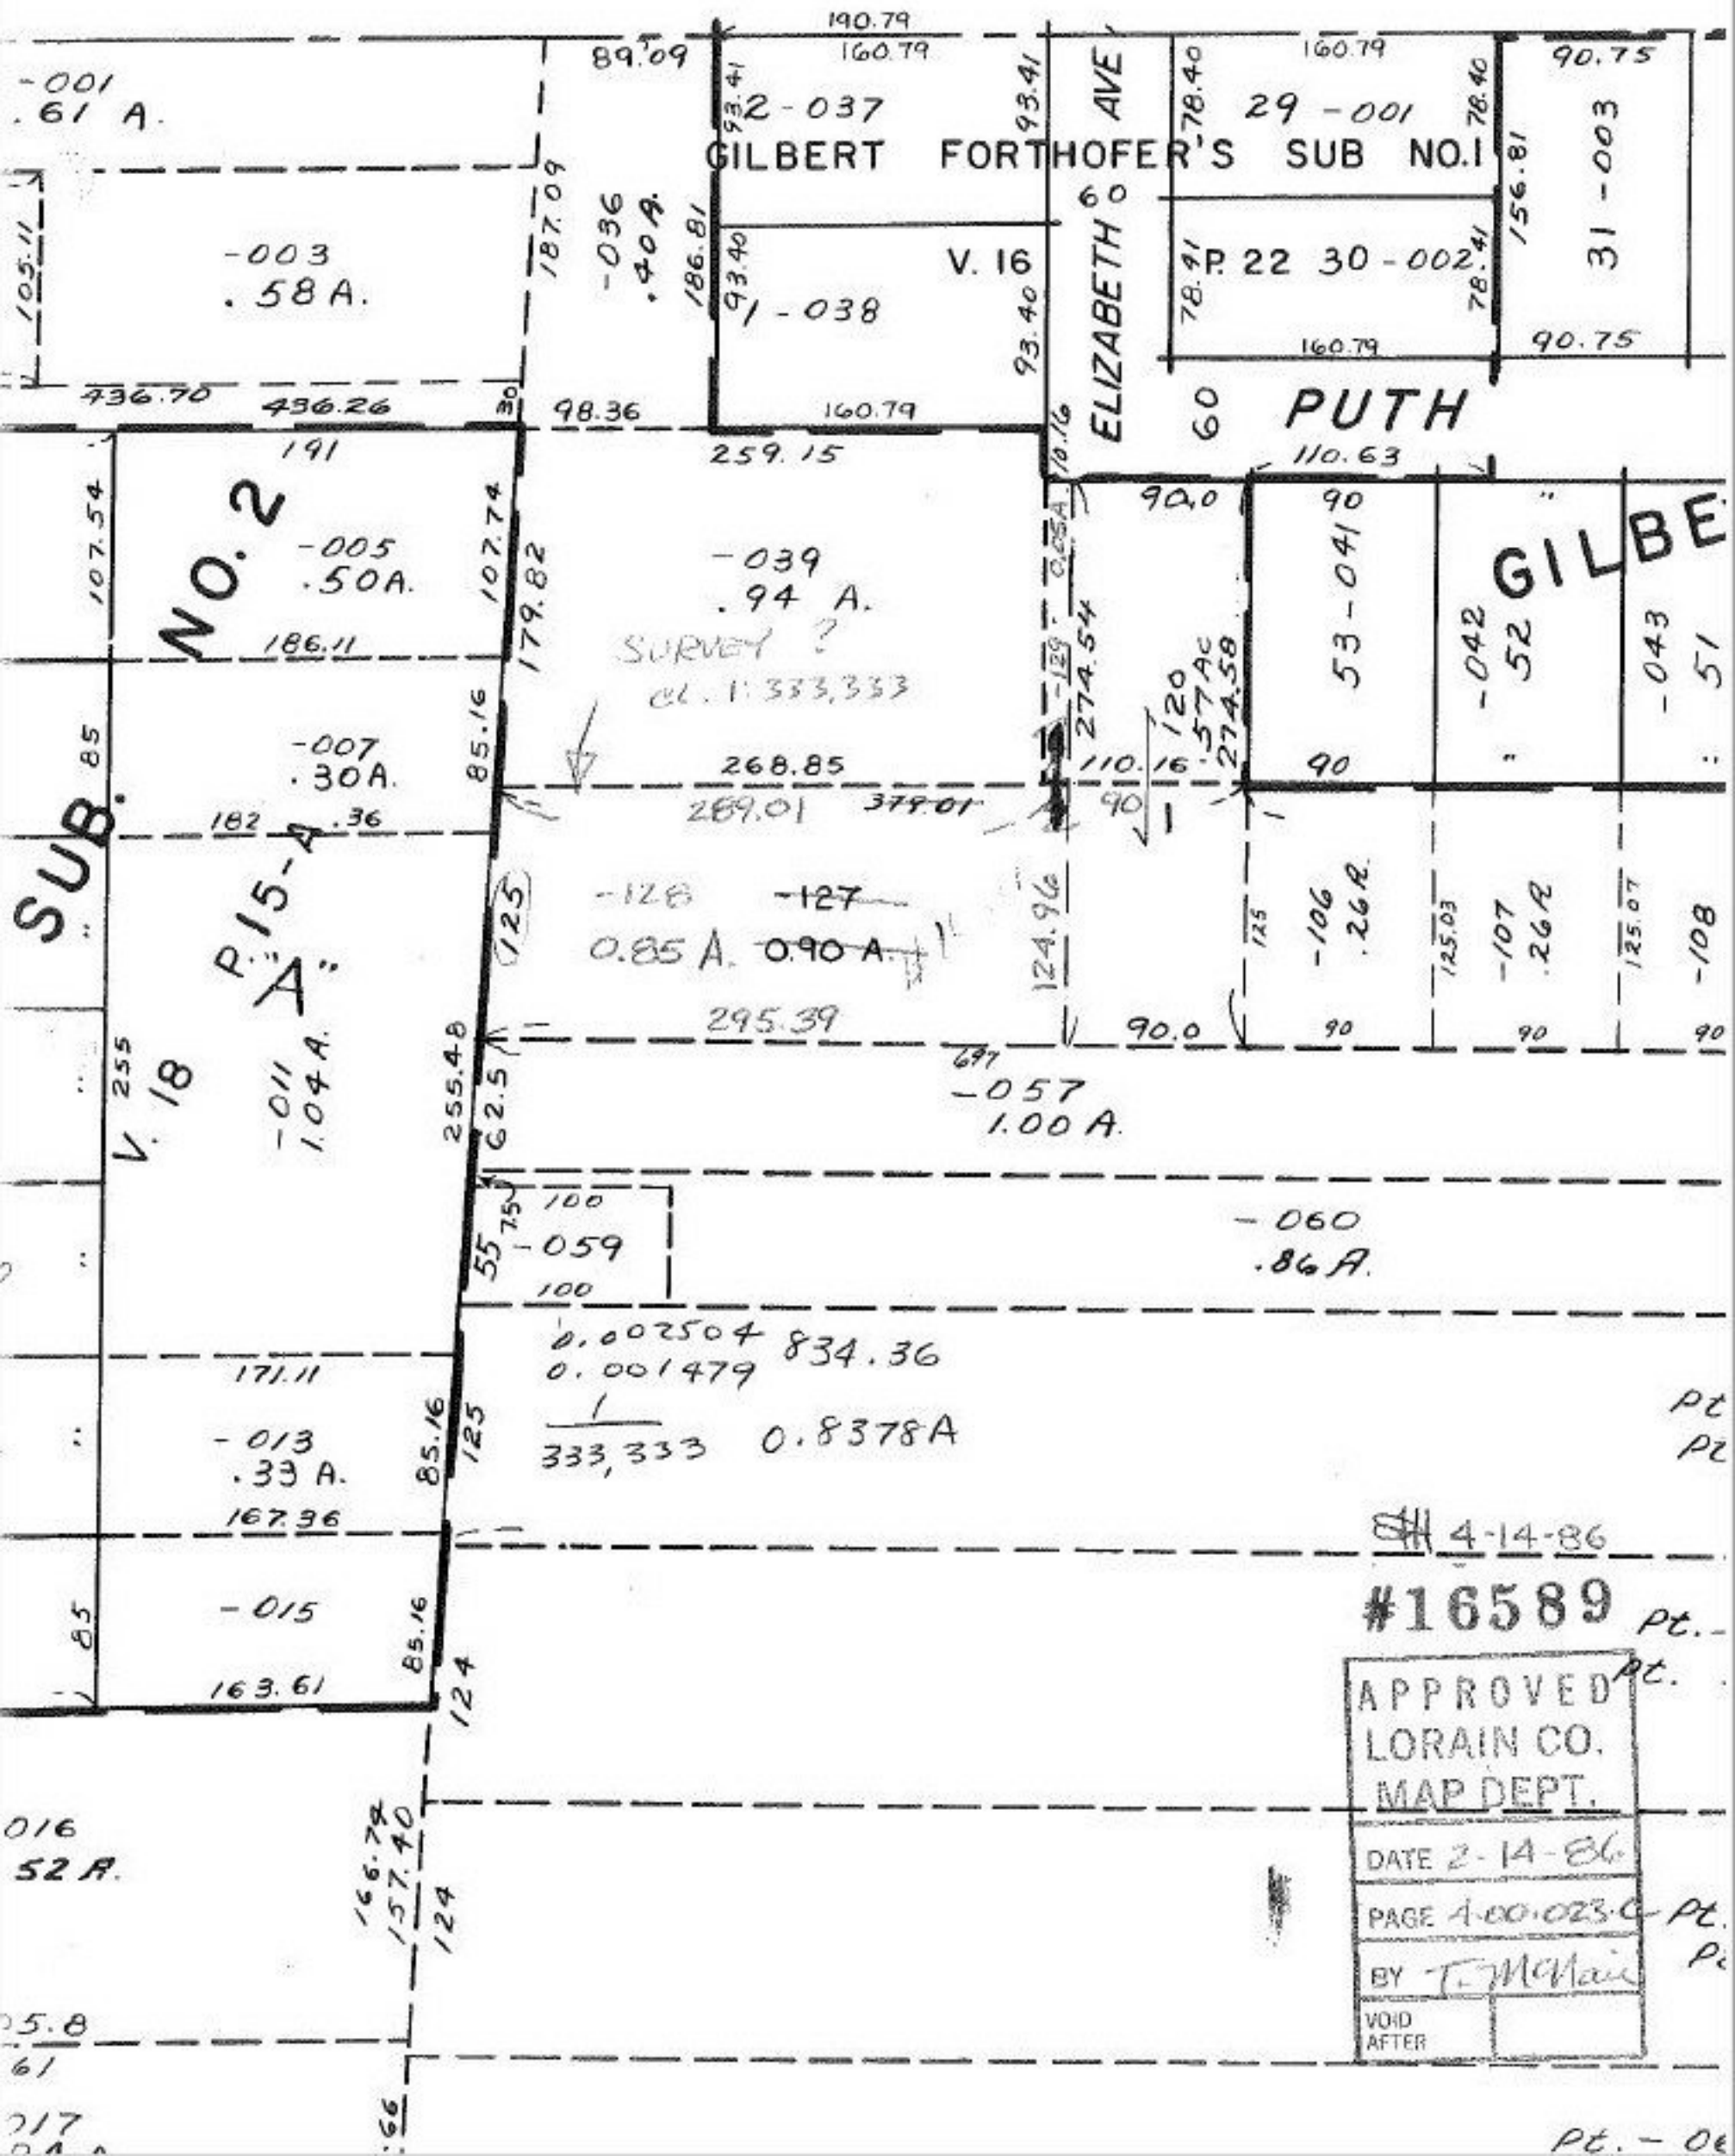

GILBERT FORTHOFER'S SUB NO.1
ELIZABETH AVE
PUTH
GILBE
SUB. NO. 2
P. 15-A "A"
V. 16
V. 18
2-037
1-038
29-001
P. 22 30-002
31-003
-001 .61 A.
-003 .58 A.
-036 .40 A.
-005 .50 A.
-039 .94 A.
-007 .30 A.
-128 0.85 A.
-127 0.90 A.
-011 1.04 A.
-057 1.00 A.
-059
-060 .86 A.
-013 .33 A.
-015
-106 .26 A.
-107 .26 A.
-108
53-041
-042 52
-043 51
0.002504
0.001479
834.36
1/333,333
0.8378 A
SURVEY ?
cl. 1:333,333
4-14-86
#16589
APPROVED
LORAIN CO.
MAP DEPT.
DATE 2-14-86
PAGE 4-00-023-C
BY T. McNair
VOID AFTER