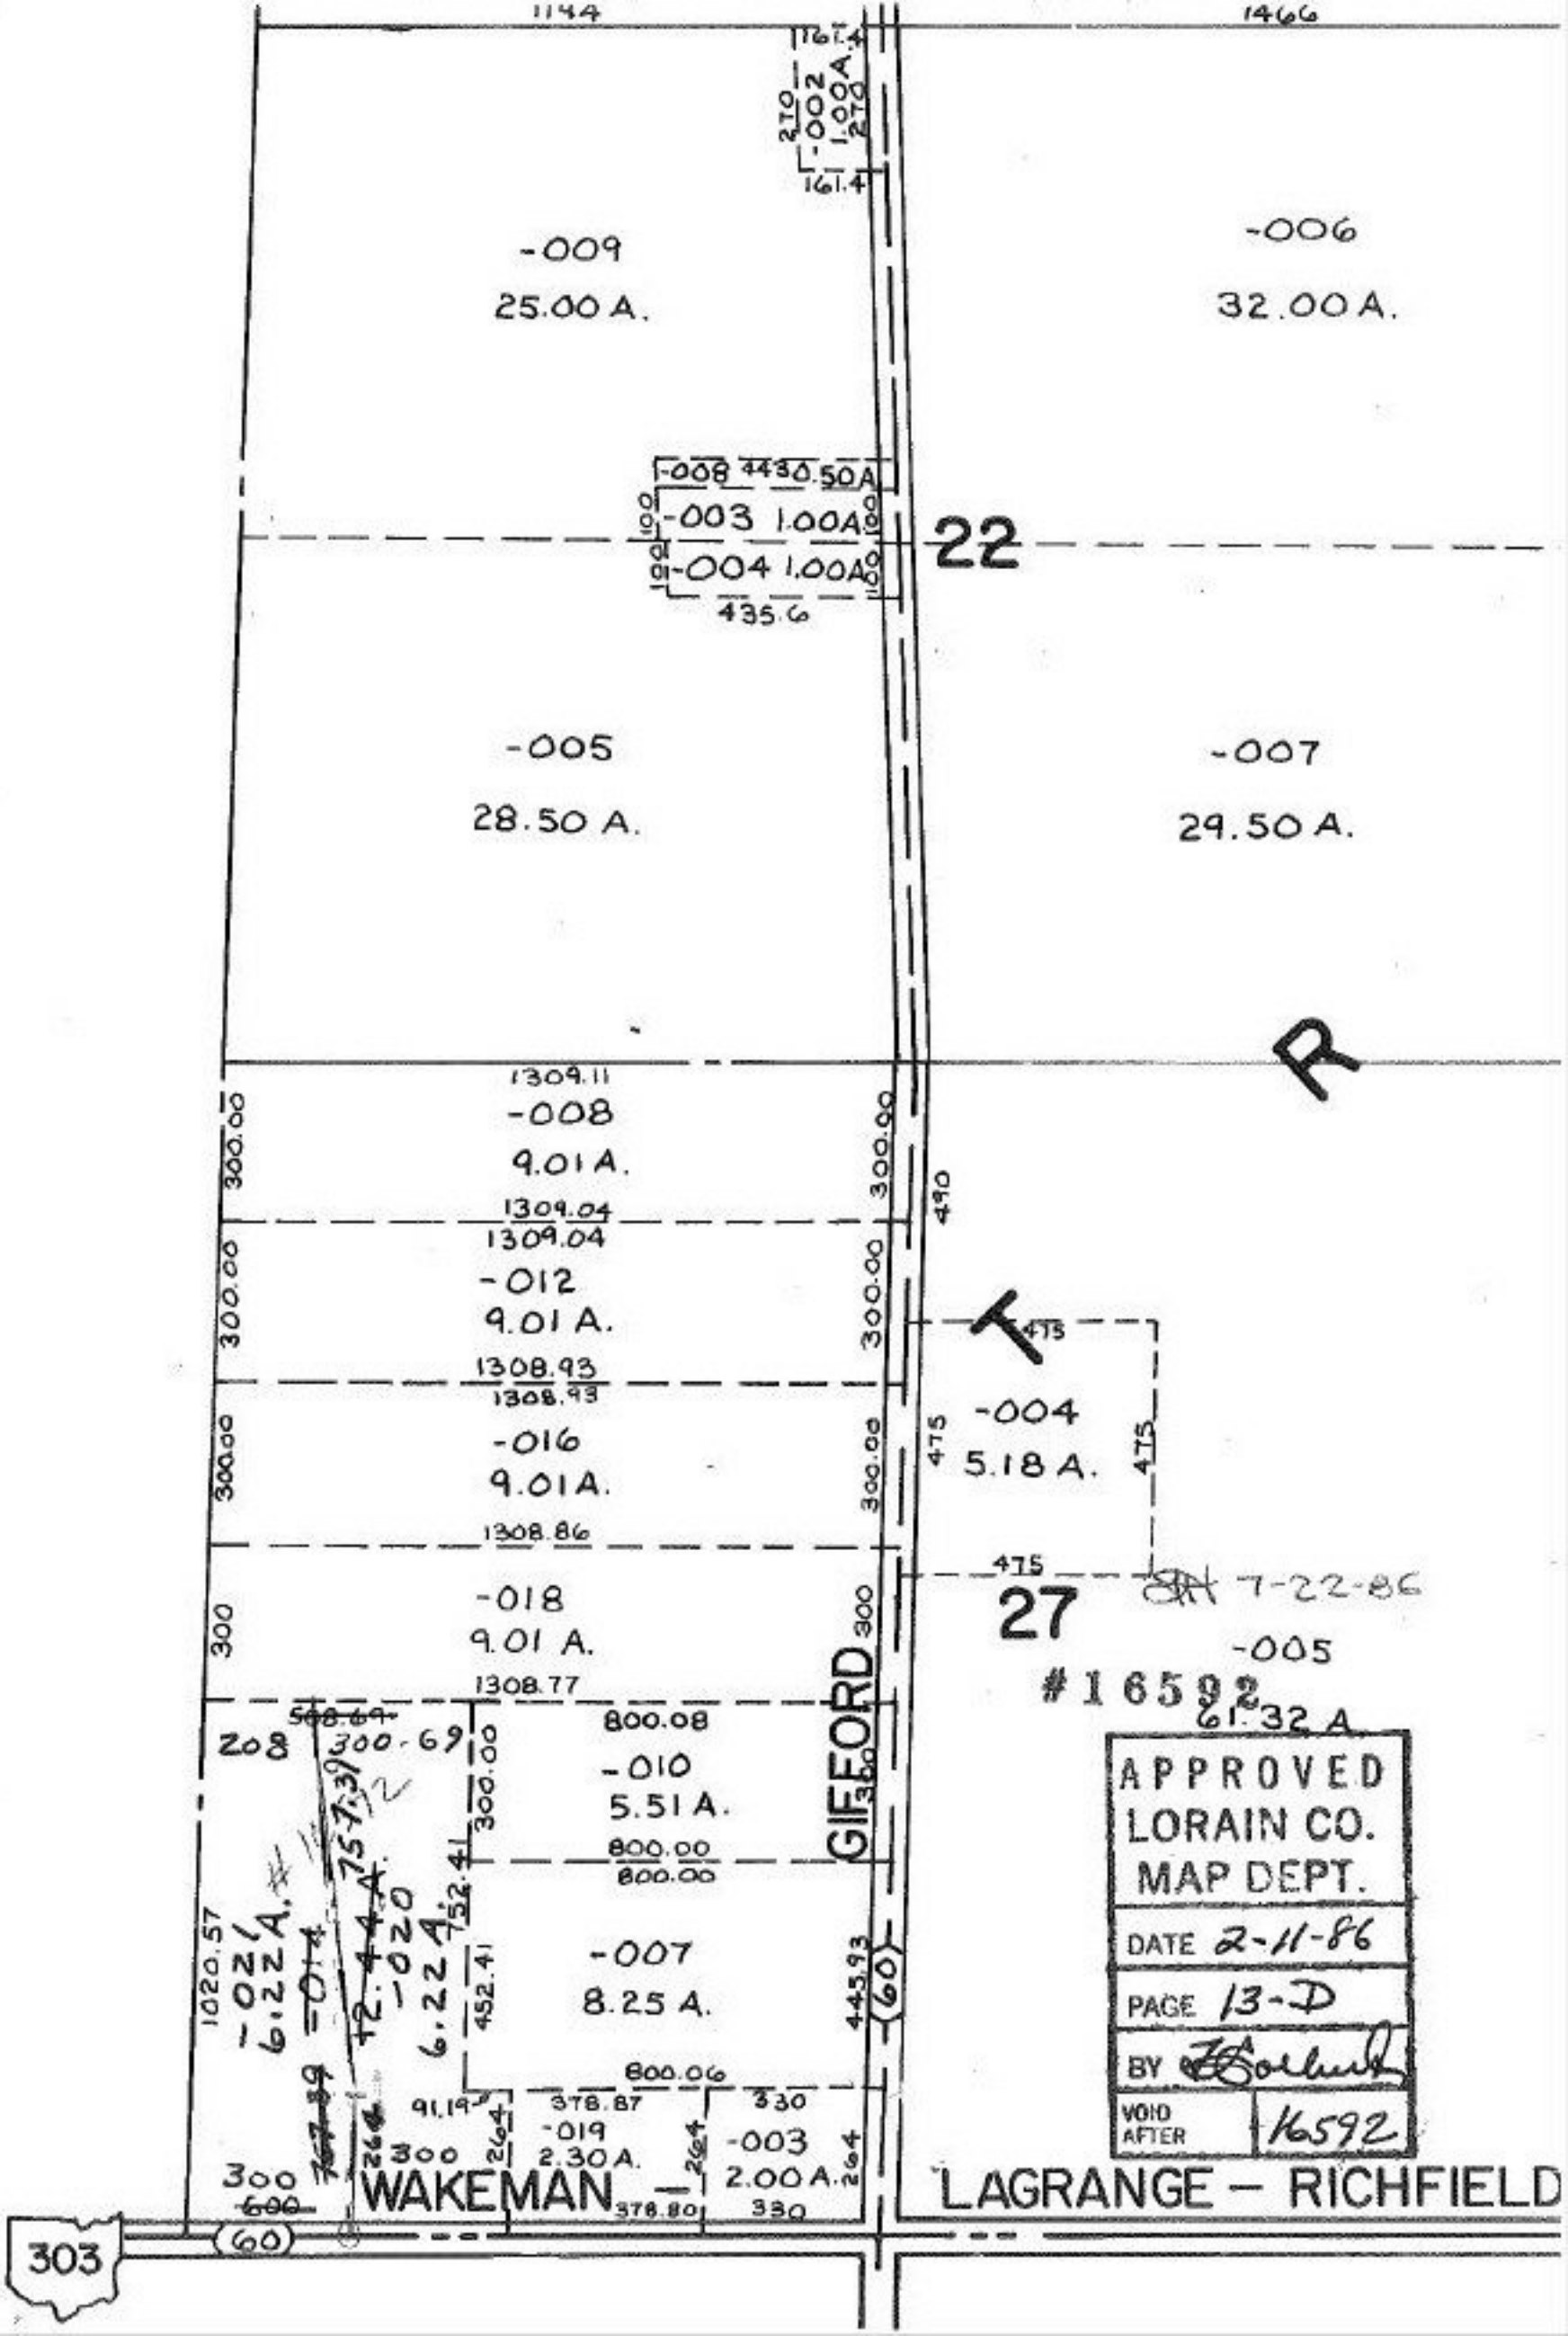

1144
1466
161.4
270
-002
1.00A.
270
161.4
-009
25.00 A.
-006
32.00 A.
-008 4430.50A
-003 1.00A
-004 1.00A
435.6
22
-005
28.50 A.
-007
29.50 A.
R
1309.11
-008
9.01 A.
1309.04
1309.04
-012
9.01 A.
1308.93
1308.93
-016
9.01 A.
1308.86
-018
9.01 A.
1308.77
300.00
490
475
-004
5.18 A.
475
27
7-22-86
-005
61.32 A.
#16592
GIFFORD
800.08
-010
5.51 A.
800.00
800.00
-007
8.25 A.
800.06
208
300-69
1020.57
-021
6.22 A.
-014
-020
6.22 A.
752.41
452.41
445.93
(60)
91.19
378.87
-019
2.30 A.
330
-003
2.00 A.
378.80
330
300
WAKEMAN
LAGRANGE - RICHFIELD
303
(60)
APPROVED
LORAIN CO.
MAP DEPT.
DATE 2-11-86
PAGE 13-D
BY
VOID AFTER 16592