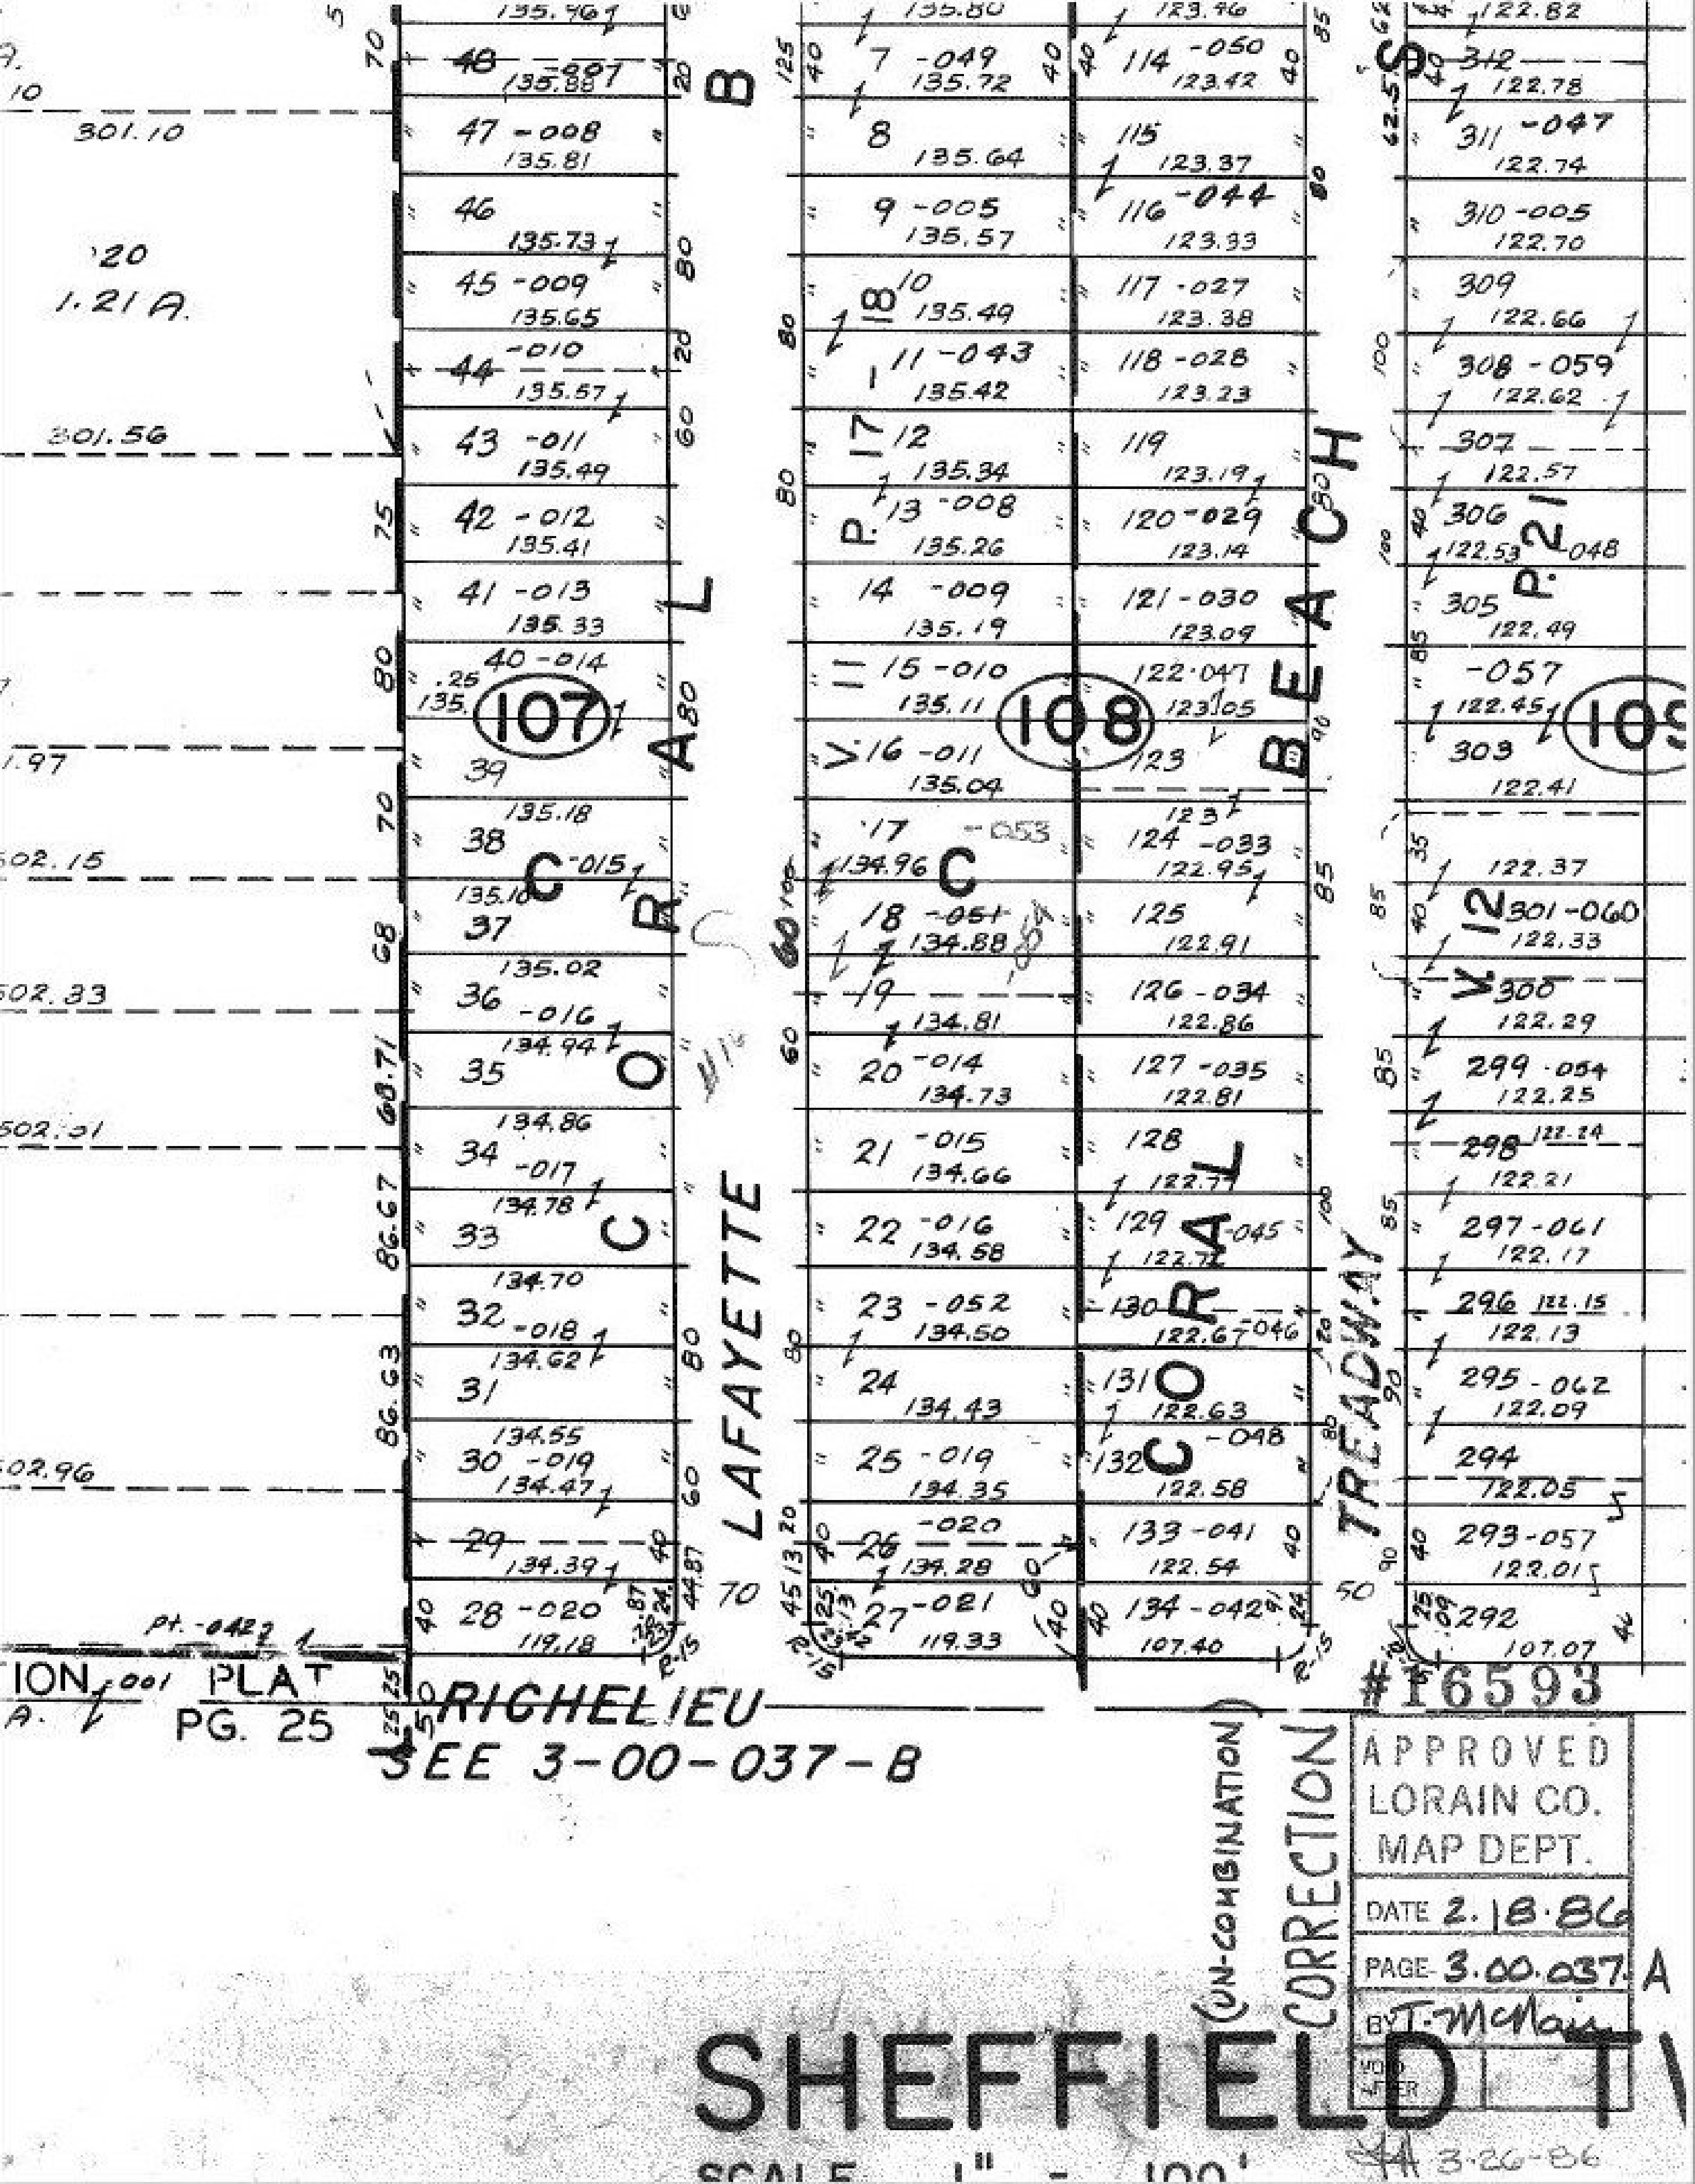
CORAL
LAFAYETTE
CORAL BEACH
CORAL
TREADWAY
RICHELIEU
SEE 3-00-037-B
PLAT PG. 25
107
108
109
P. 17 - V. 11
P. 21 - V. 12
#16593
(UN-COMBINATION)
CORRECTION
APPROVED LORAIN CO. MAP DEPT.
DATE 2.18.86
PAGE 3.00.037 A
BY T. McNair
VOID AFTER
SHEFFIELD T
3-26-86