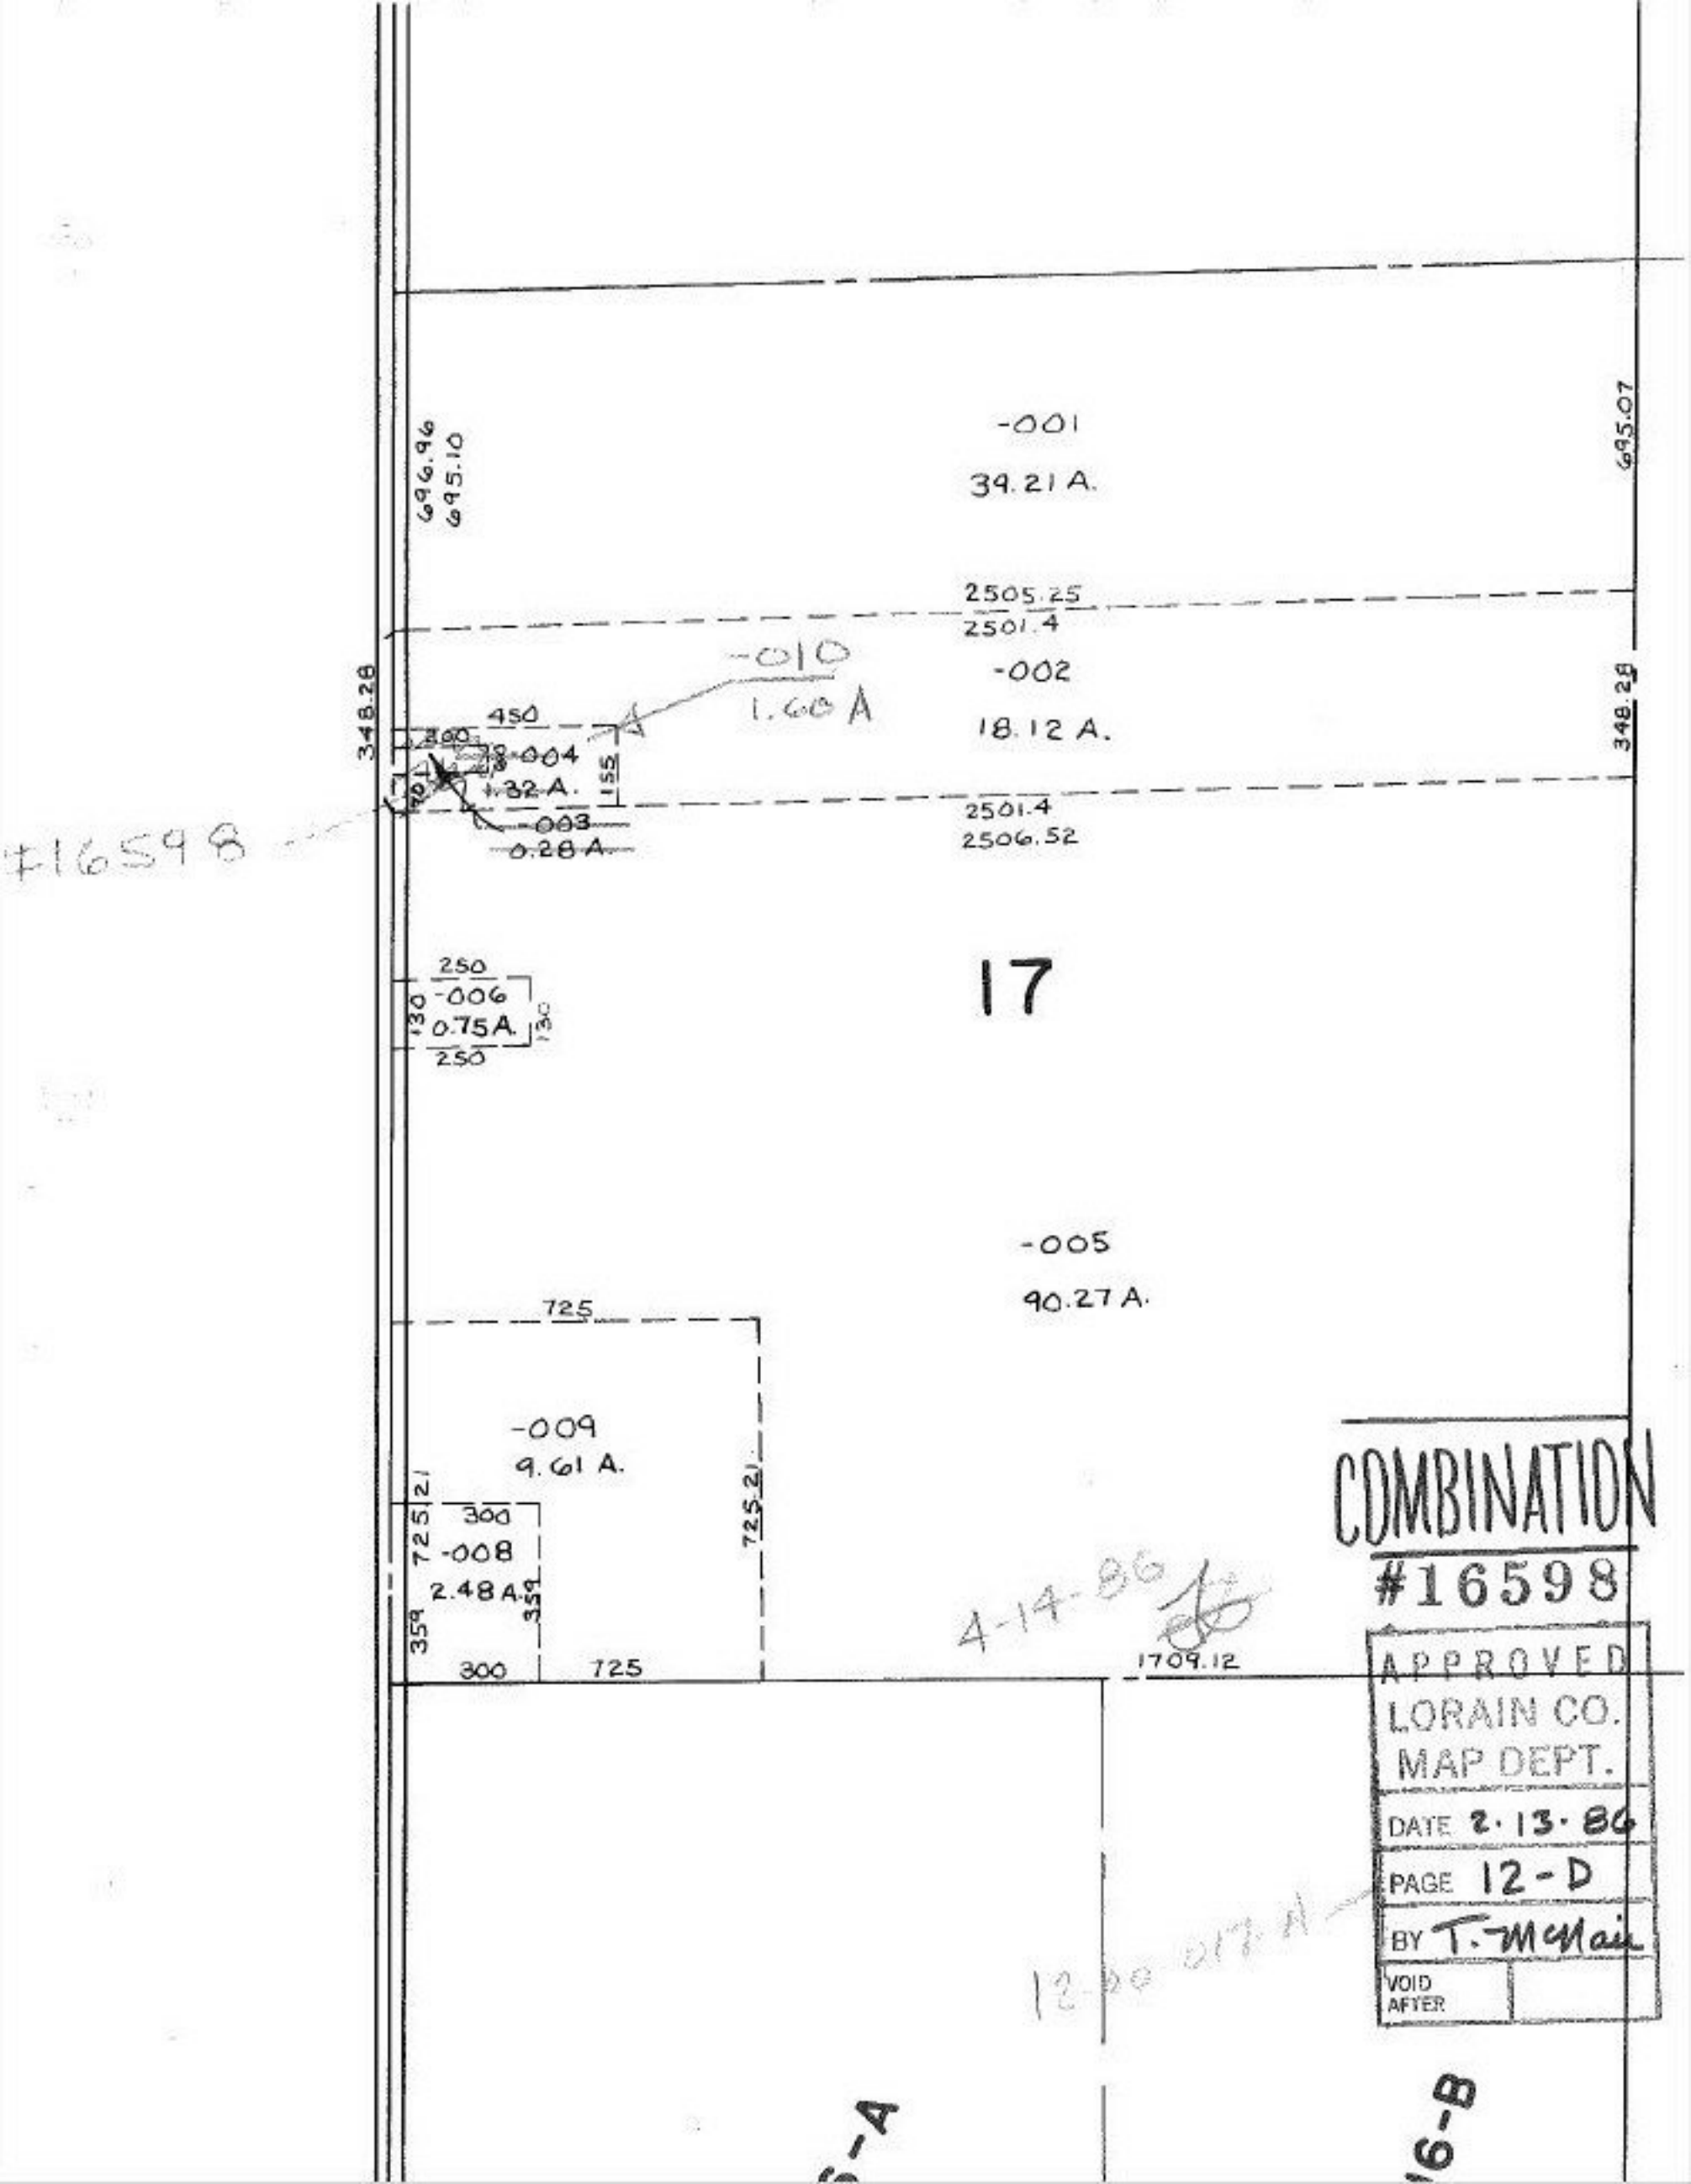

-001
39.21 A.
696.96
695.10
695.07
2505.25
2501.4
-010
1.60 A
-002
18.12 A.
348.28
348.28
450
200
-004
1.32 A.
155
-003
0.28 A.
2501.4
2506.52
#16598
250
-006
0.75 A.
130
130
250
17
-005
90.27 A.
725
-009
9.61 A.
725.21
725.21
300
-008
2.48 A.
359
359
300
725
1709.12
4-14-86
12-00 017 A
COMBINATION
#16598
APPROVED
LORAIN CO.
MAP DEPT.
DATE 2·13·86
PAGE 12-D
BY T. McNair
VOID AFTER