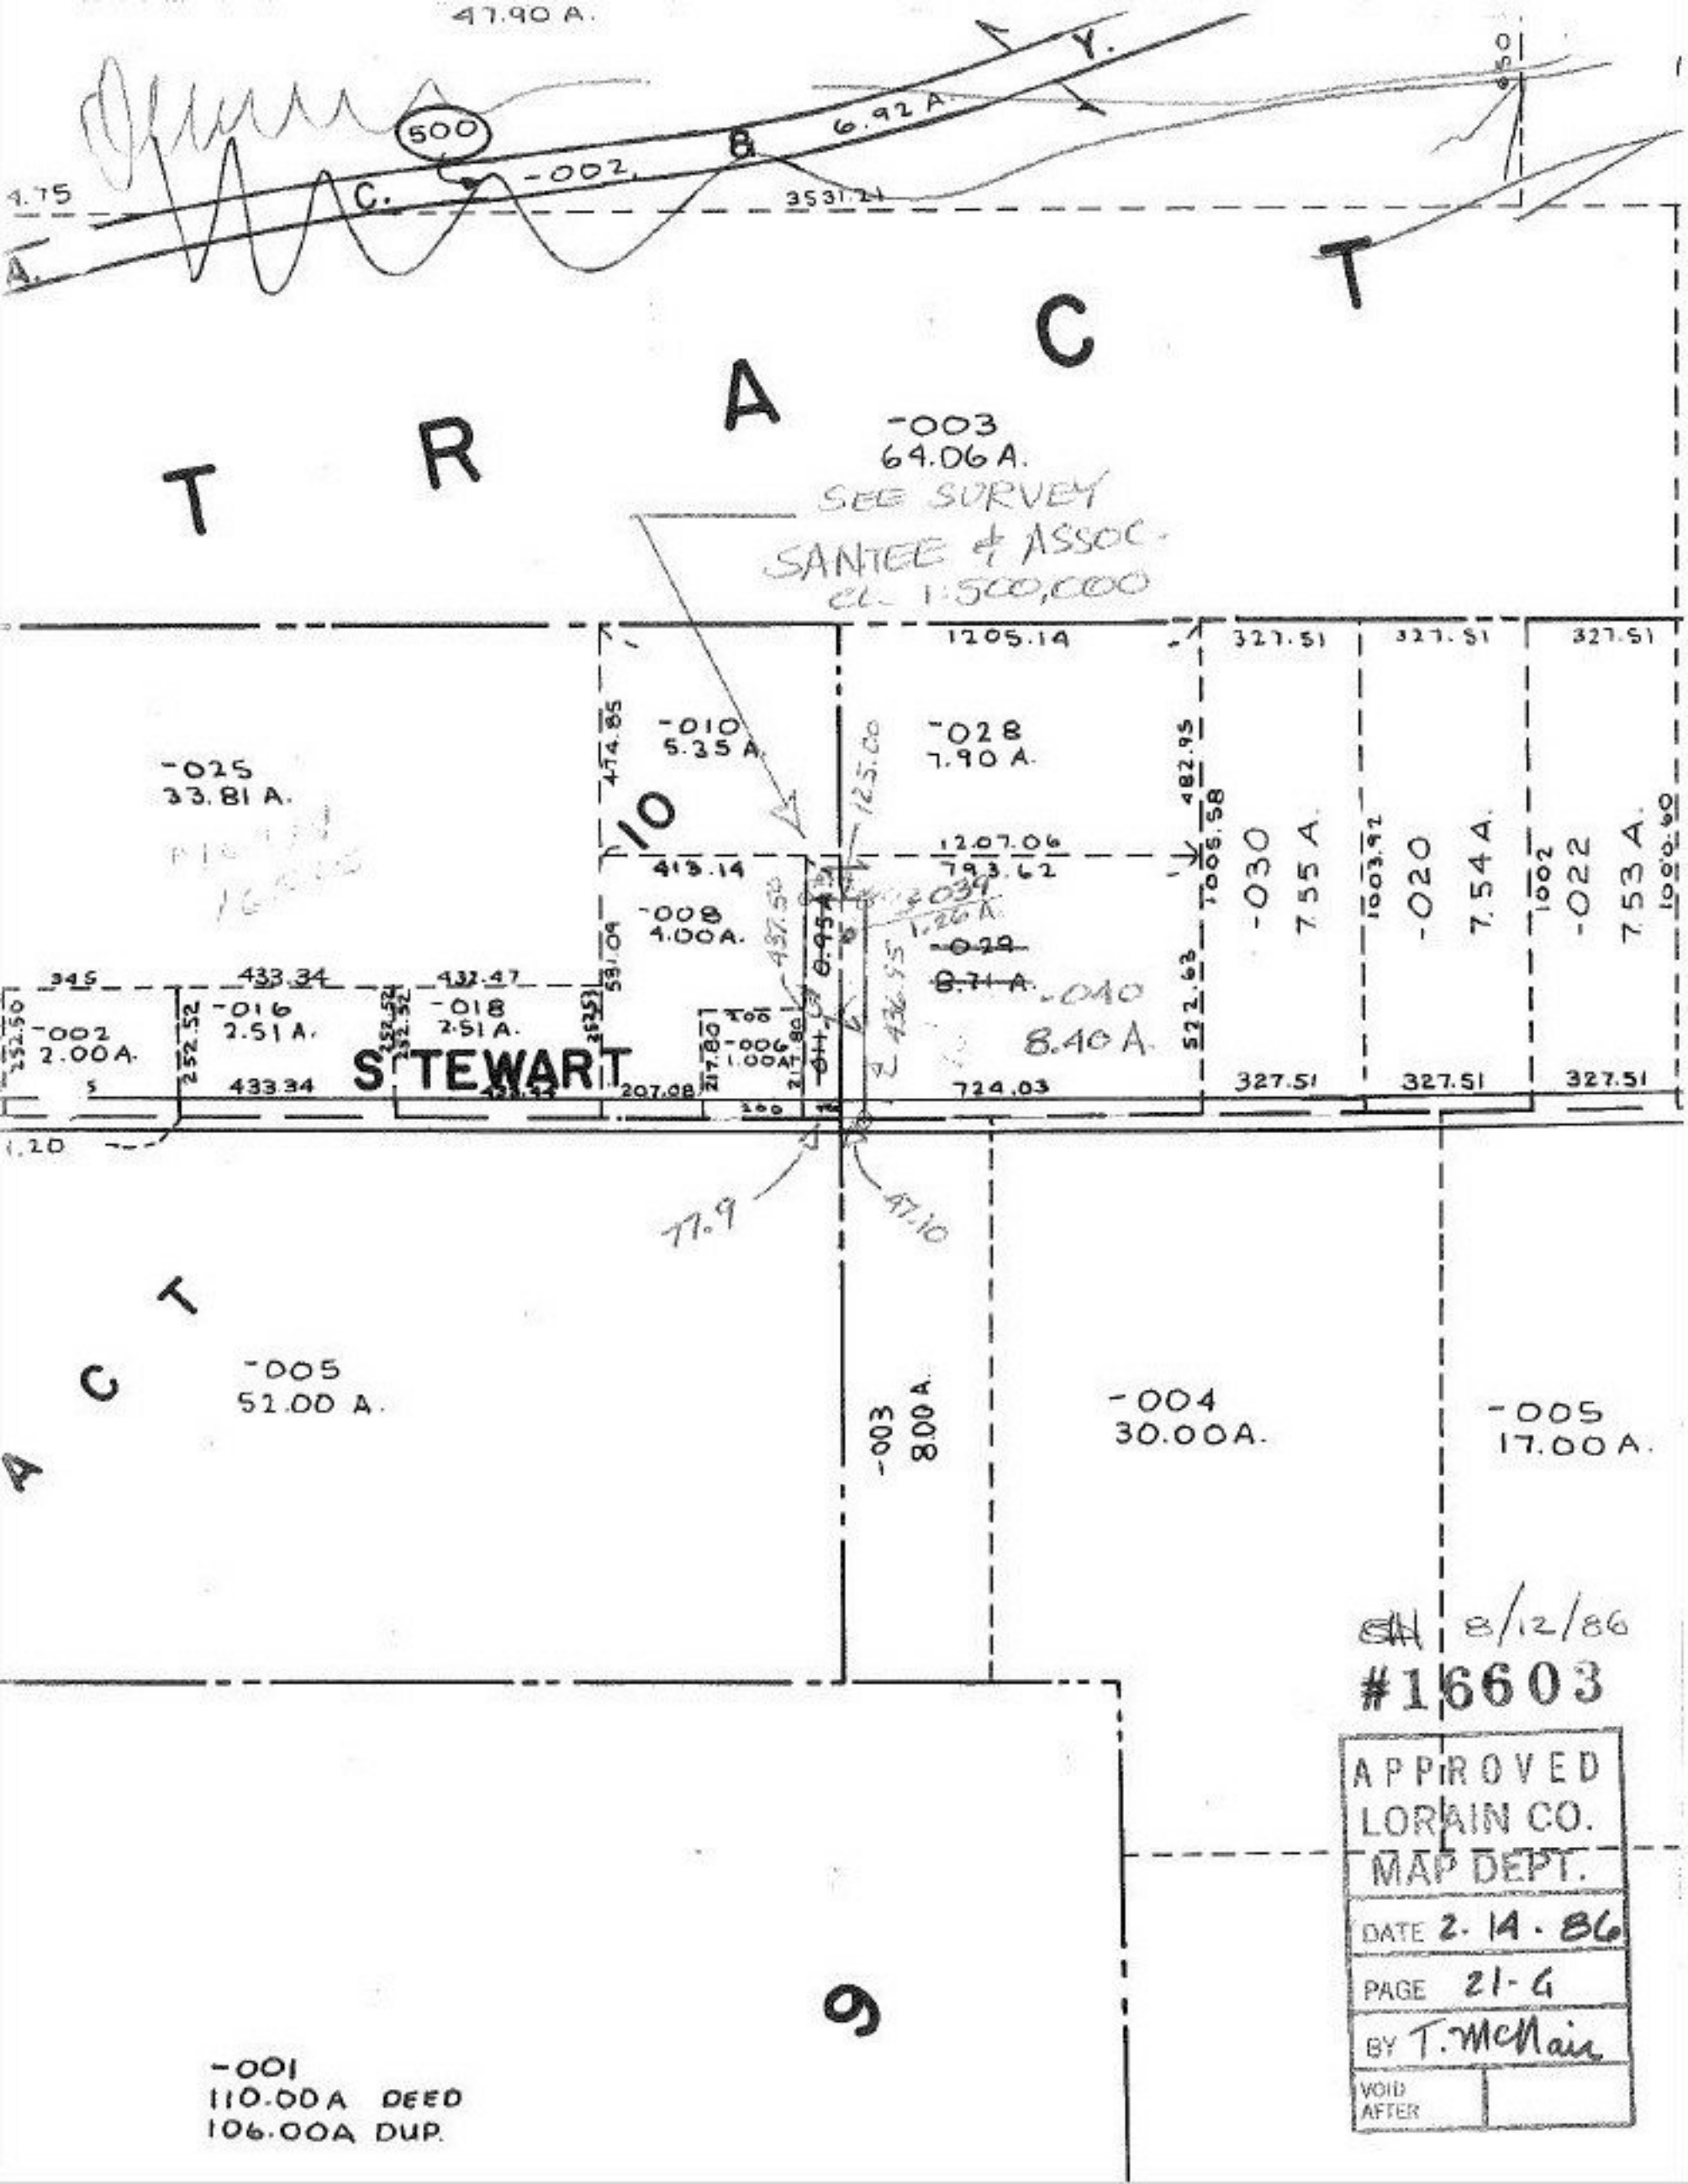
47.90 A.
500
-002
6.92 A.
3531.21
4.75
A.
C.
B.
Y.
T R A C T
-003
64.06 A.
SEE SURVEY
SANTEE & ASSOC.
CL. 1:500,000
1205.14
327.51
327.51
327.51
-025
33.81 A.
-010
5.35 A.
-028
7.90 A.
474.85
482.95
125.00
10
1207.06
793.62
413.14
-008
4.00 A.
-039
1.26 A.
-029
8.71 A.
-040
8.40 A.
-030
7.55 A.
-020
7.54 A.
-022
7.53 A.
1005.58
1003.92
1002
1000.60
522.63
345
433.34
432.47
-002
2.00 A.
-016
2.51 A.
-018
2.51 A.
-006
1.00 A.
STEWART
433.34
207.08
724.03
327.51
327.51
327.51
77.9
47.10
-005
52.00 A.
-003
8.00 A.
-004
30.00 A.
-005
17.00 A.
8/12/86
#16603
APPROVED
LORAIN CO.
MAP DEPT.
DATE 2-14-86
PAGE 21-G
BY T. McNair
VOID AFTER
9
-001
110.00 A DEED
106.00 A DUP.