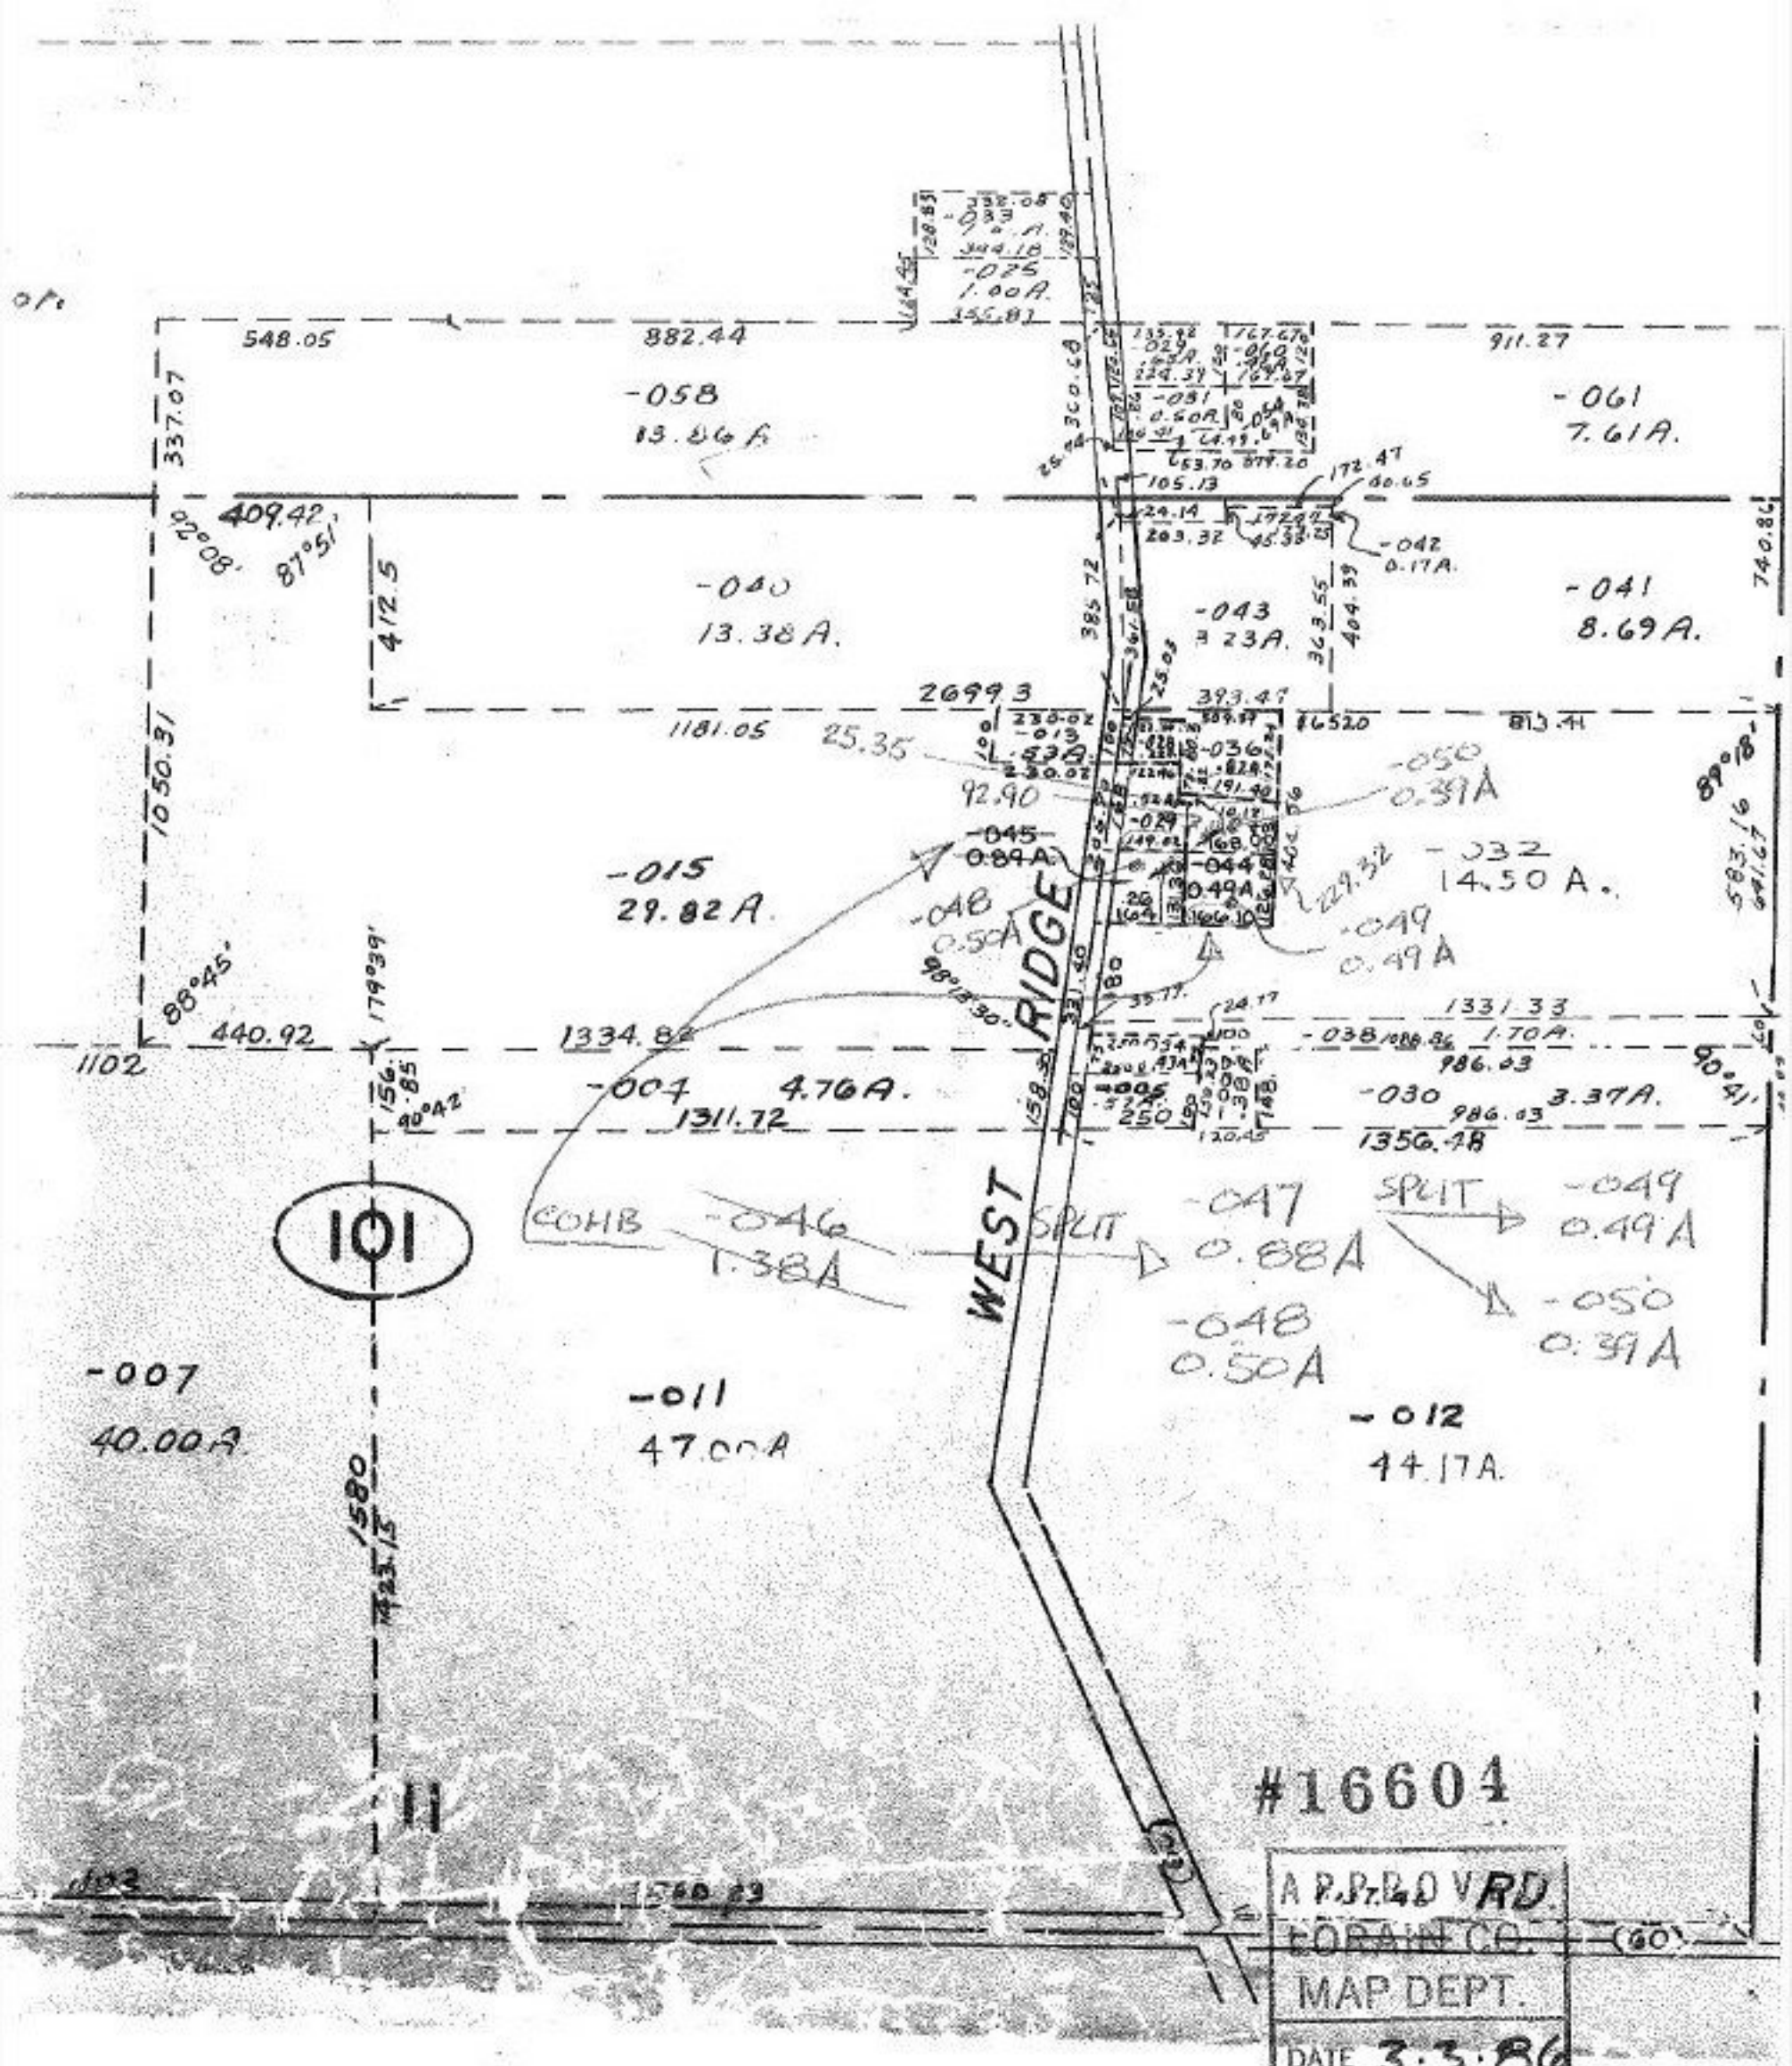


APPROVED
LORAIN CO.
MAP DEPT.
DATE 3·3·86
PAGE 10-A
BY T. McNair
VOID AFTER