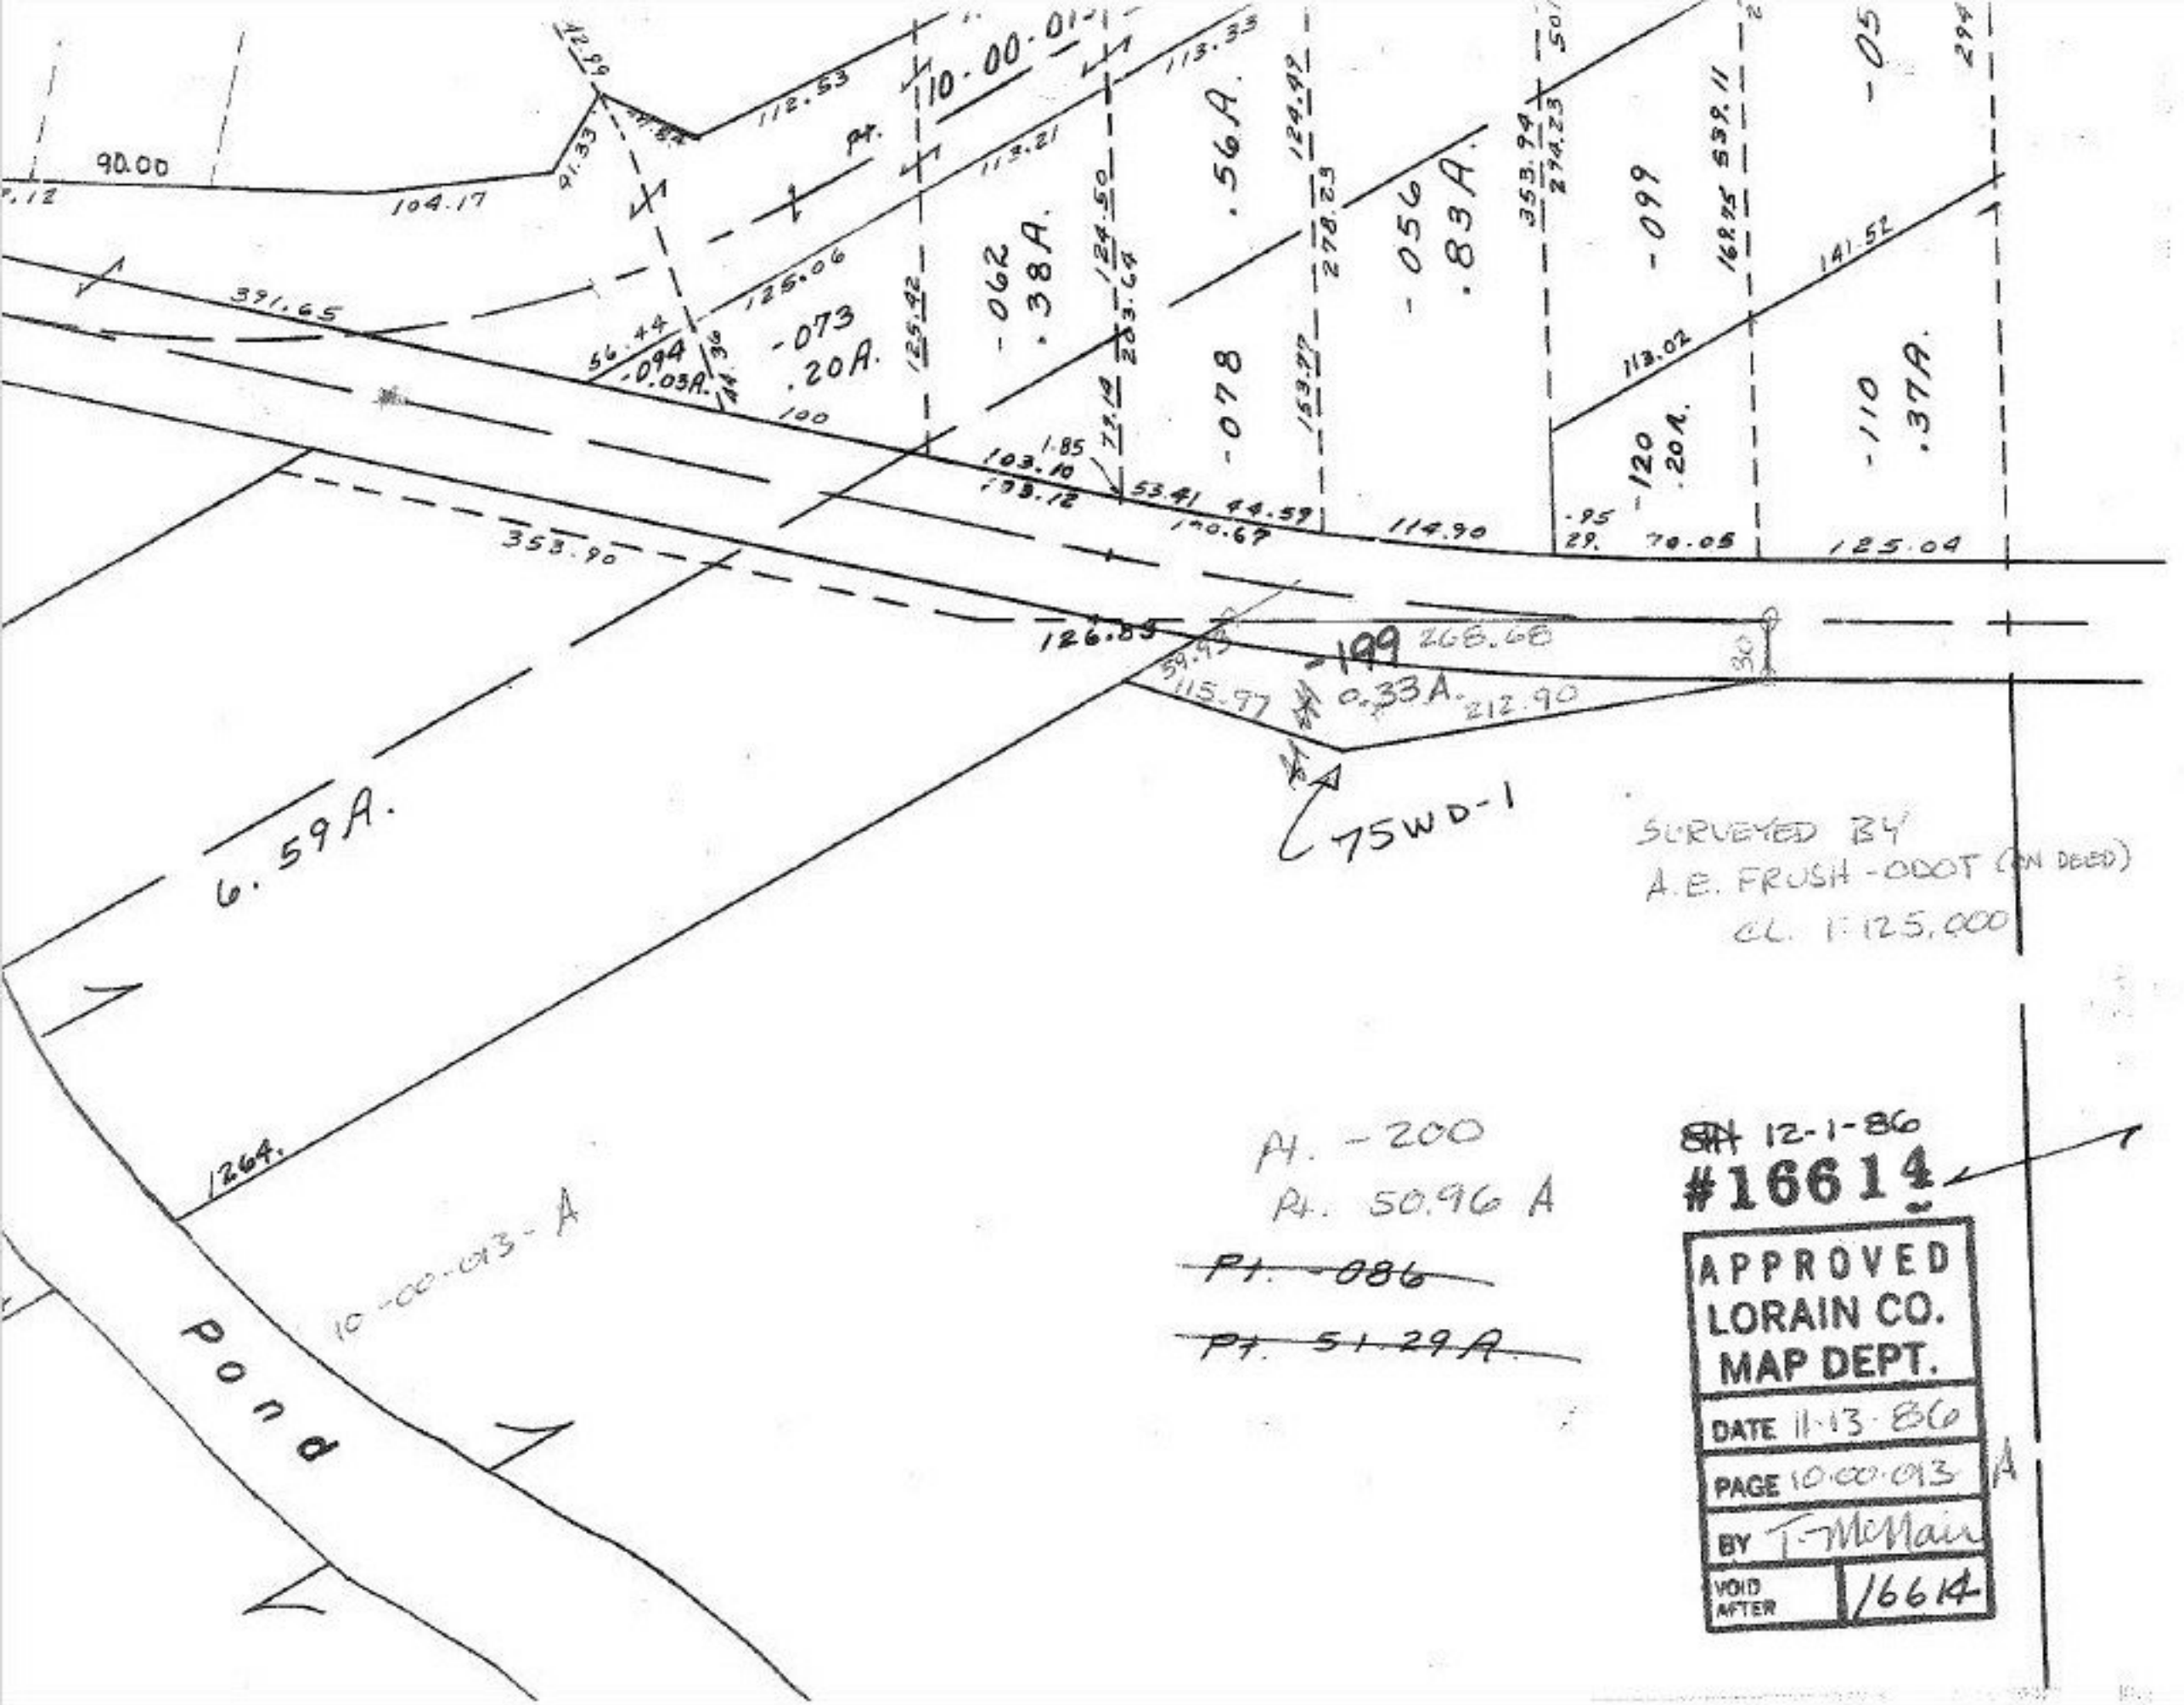
10-00-013-A
Pond
6.59A.
126.85
391.65
353.90
104.17
90.00
112.53
113.21
125.06
125.42
124.50
203.64
278.29
153.27
124.92
113.33
353.94
274.23
168.15
539.11
141.52
113.02
114.90
125.04
70.05
103.10
193.12
120.67
53.41
44.59
115.77
59.45
212.90
266.68
0.33A.
.56A.
.38A.
.20A.
.83A.
.37A.
.20A.
-062
-073
-078
-056
-099
-110
-120
-199
-094
-0.03A.
75WD-1
1264.
SURVEYED BY
A.E. FRUSH - ODOT (ON DEED)
CL. 1:125,000
A. -200
A. 50.96 A
~~P.I. -086~~
~~P.I. 51.29 A.~~
SM 12-1-86
#16614
APPROVED
LORAIN CO.
MAP DEPT.
DATE 11-13-86
PAGE 10-00-013 A
BY T-McMain
VOID AFTER 16614