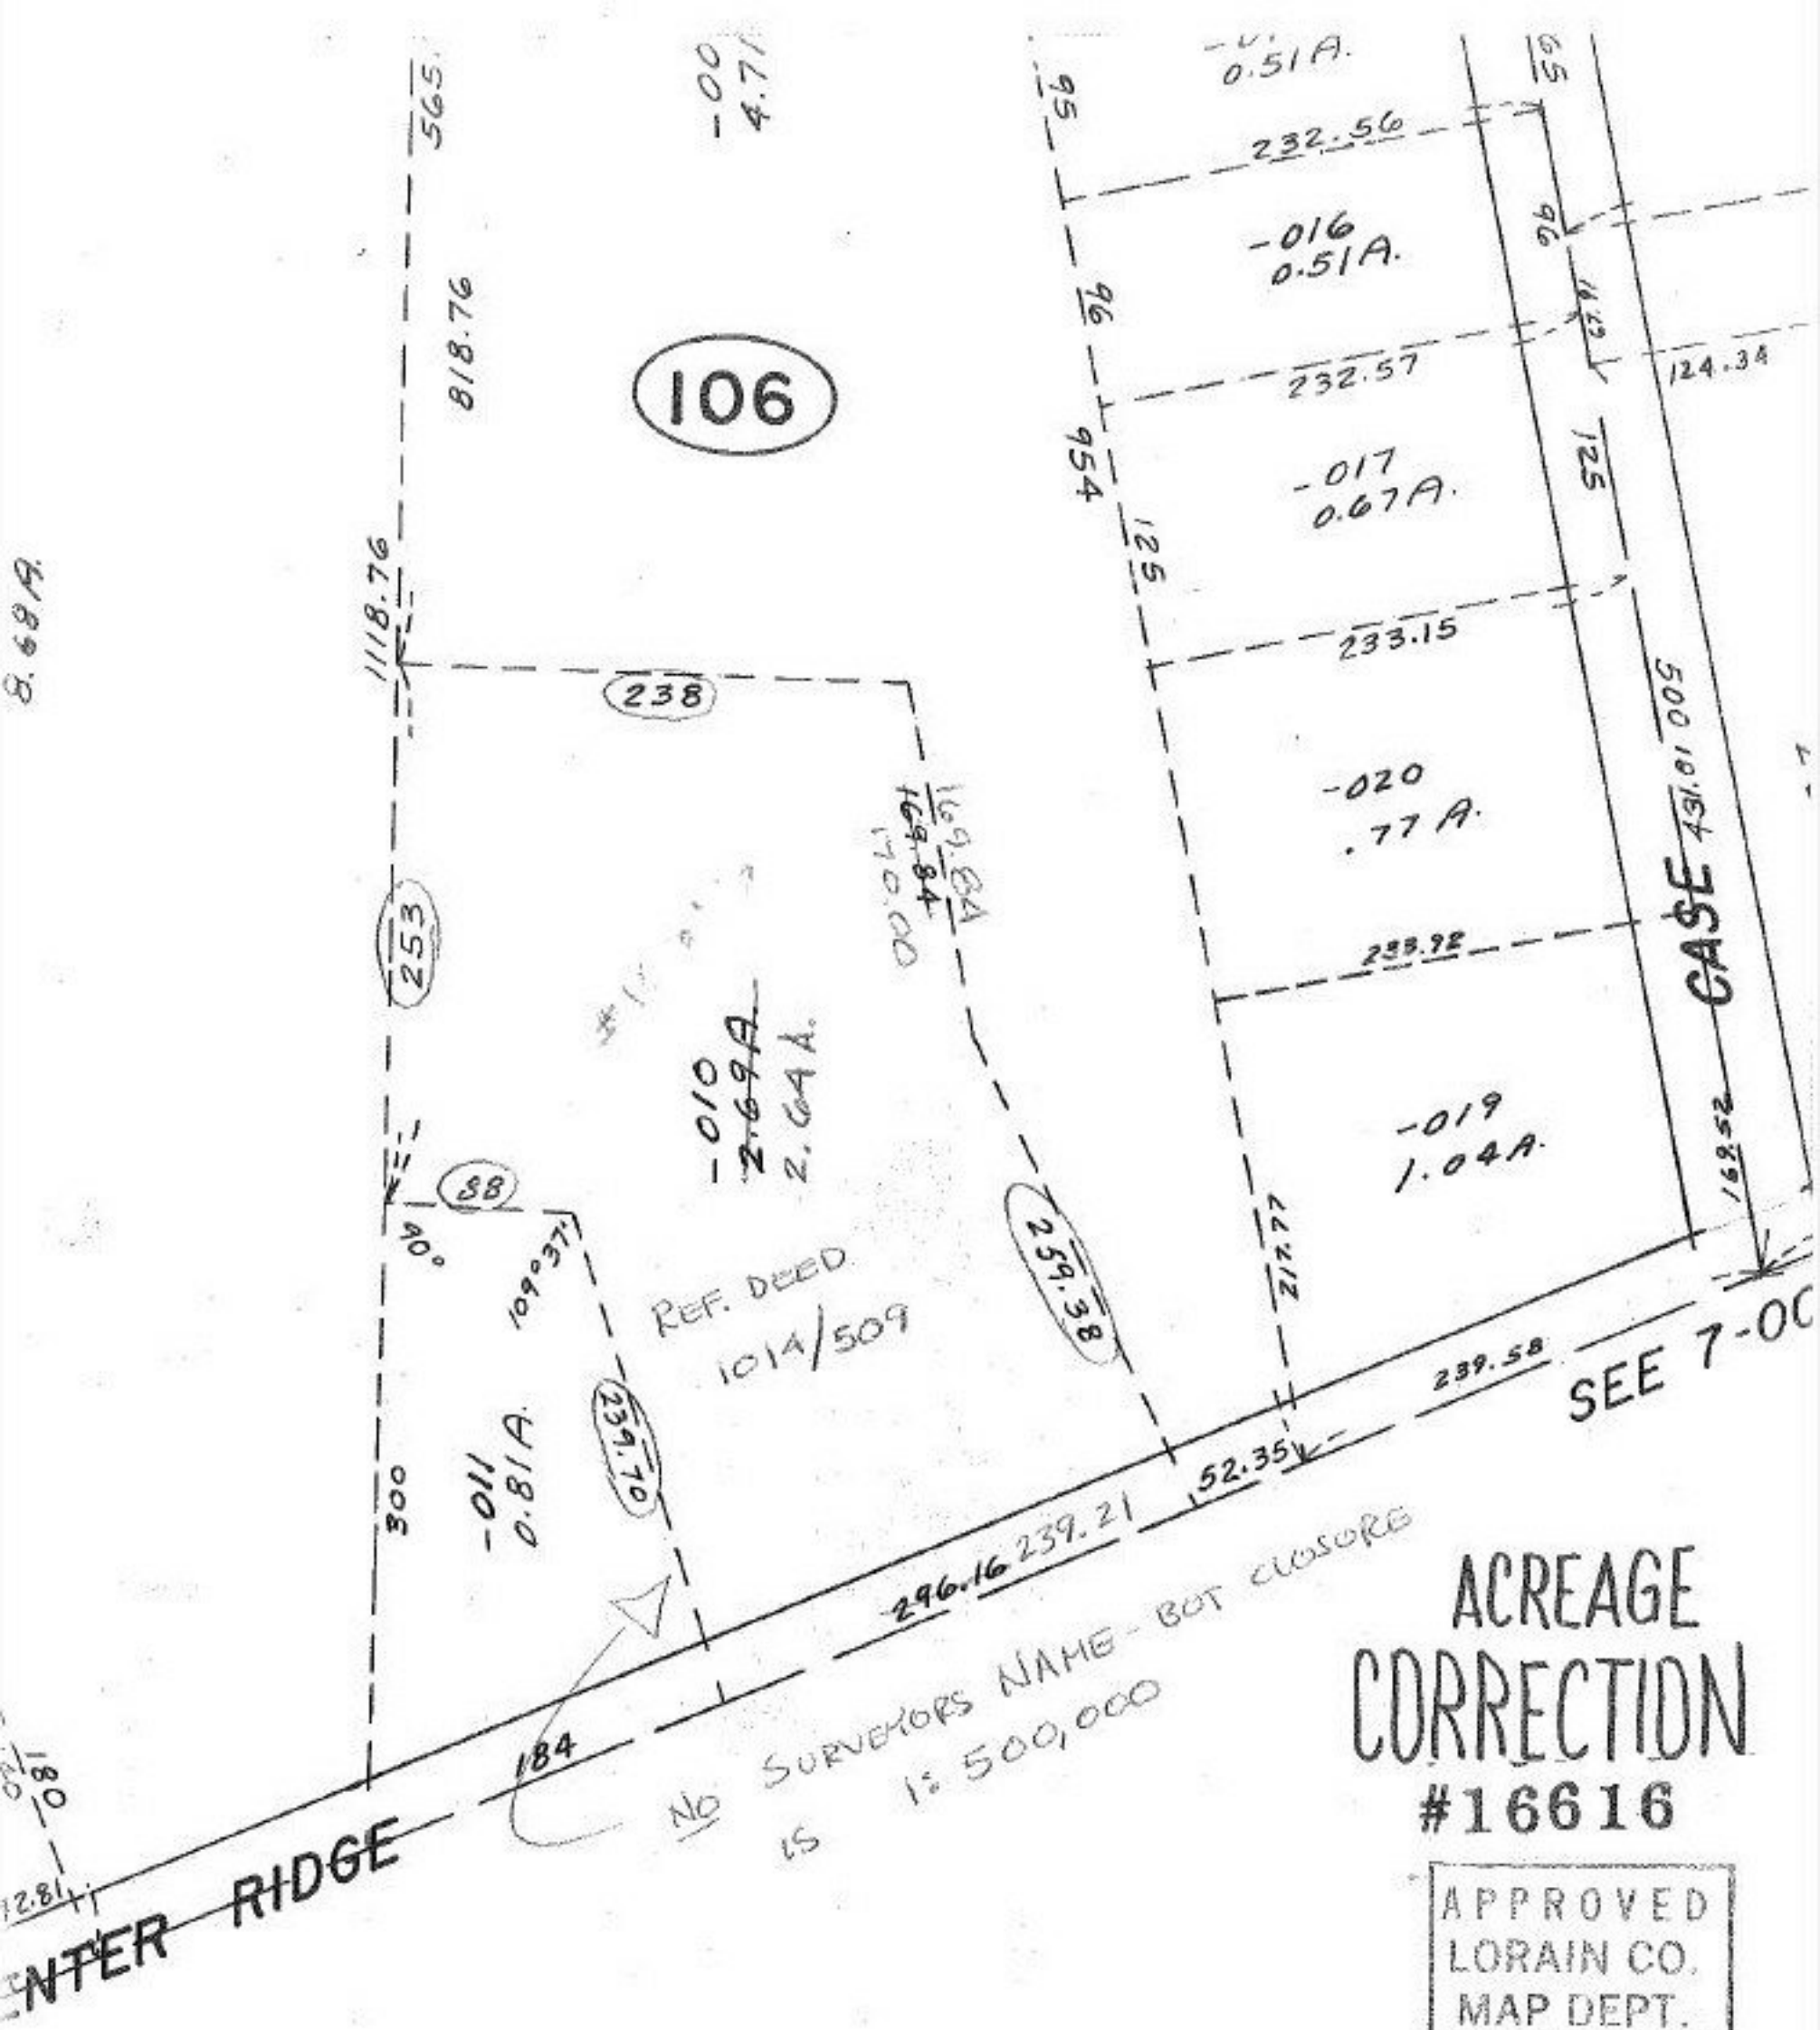

ACREAGE CORRECTION

#16616

APPROVED
LORAIN CO.
MAP DEPT.

DATE 2-28-86

PAGE 7.00.046 B

BY T. McNair

VOID AFTER

4-1-86