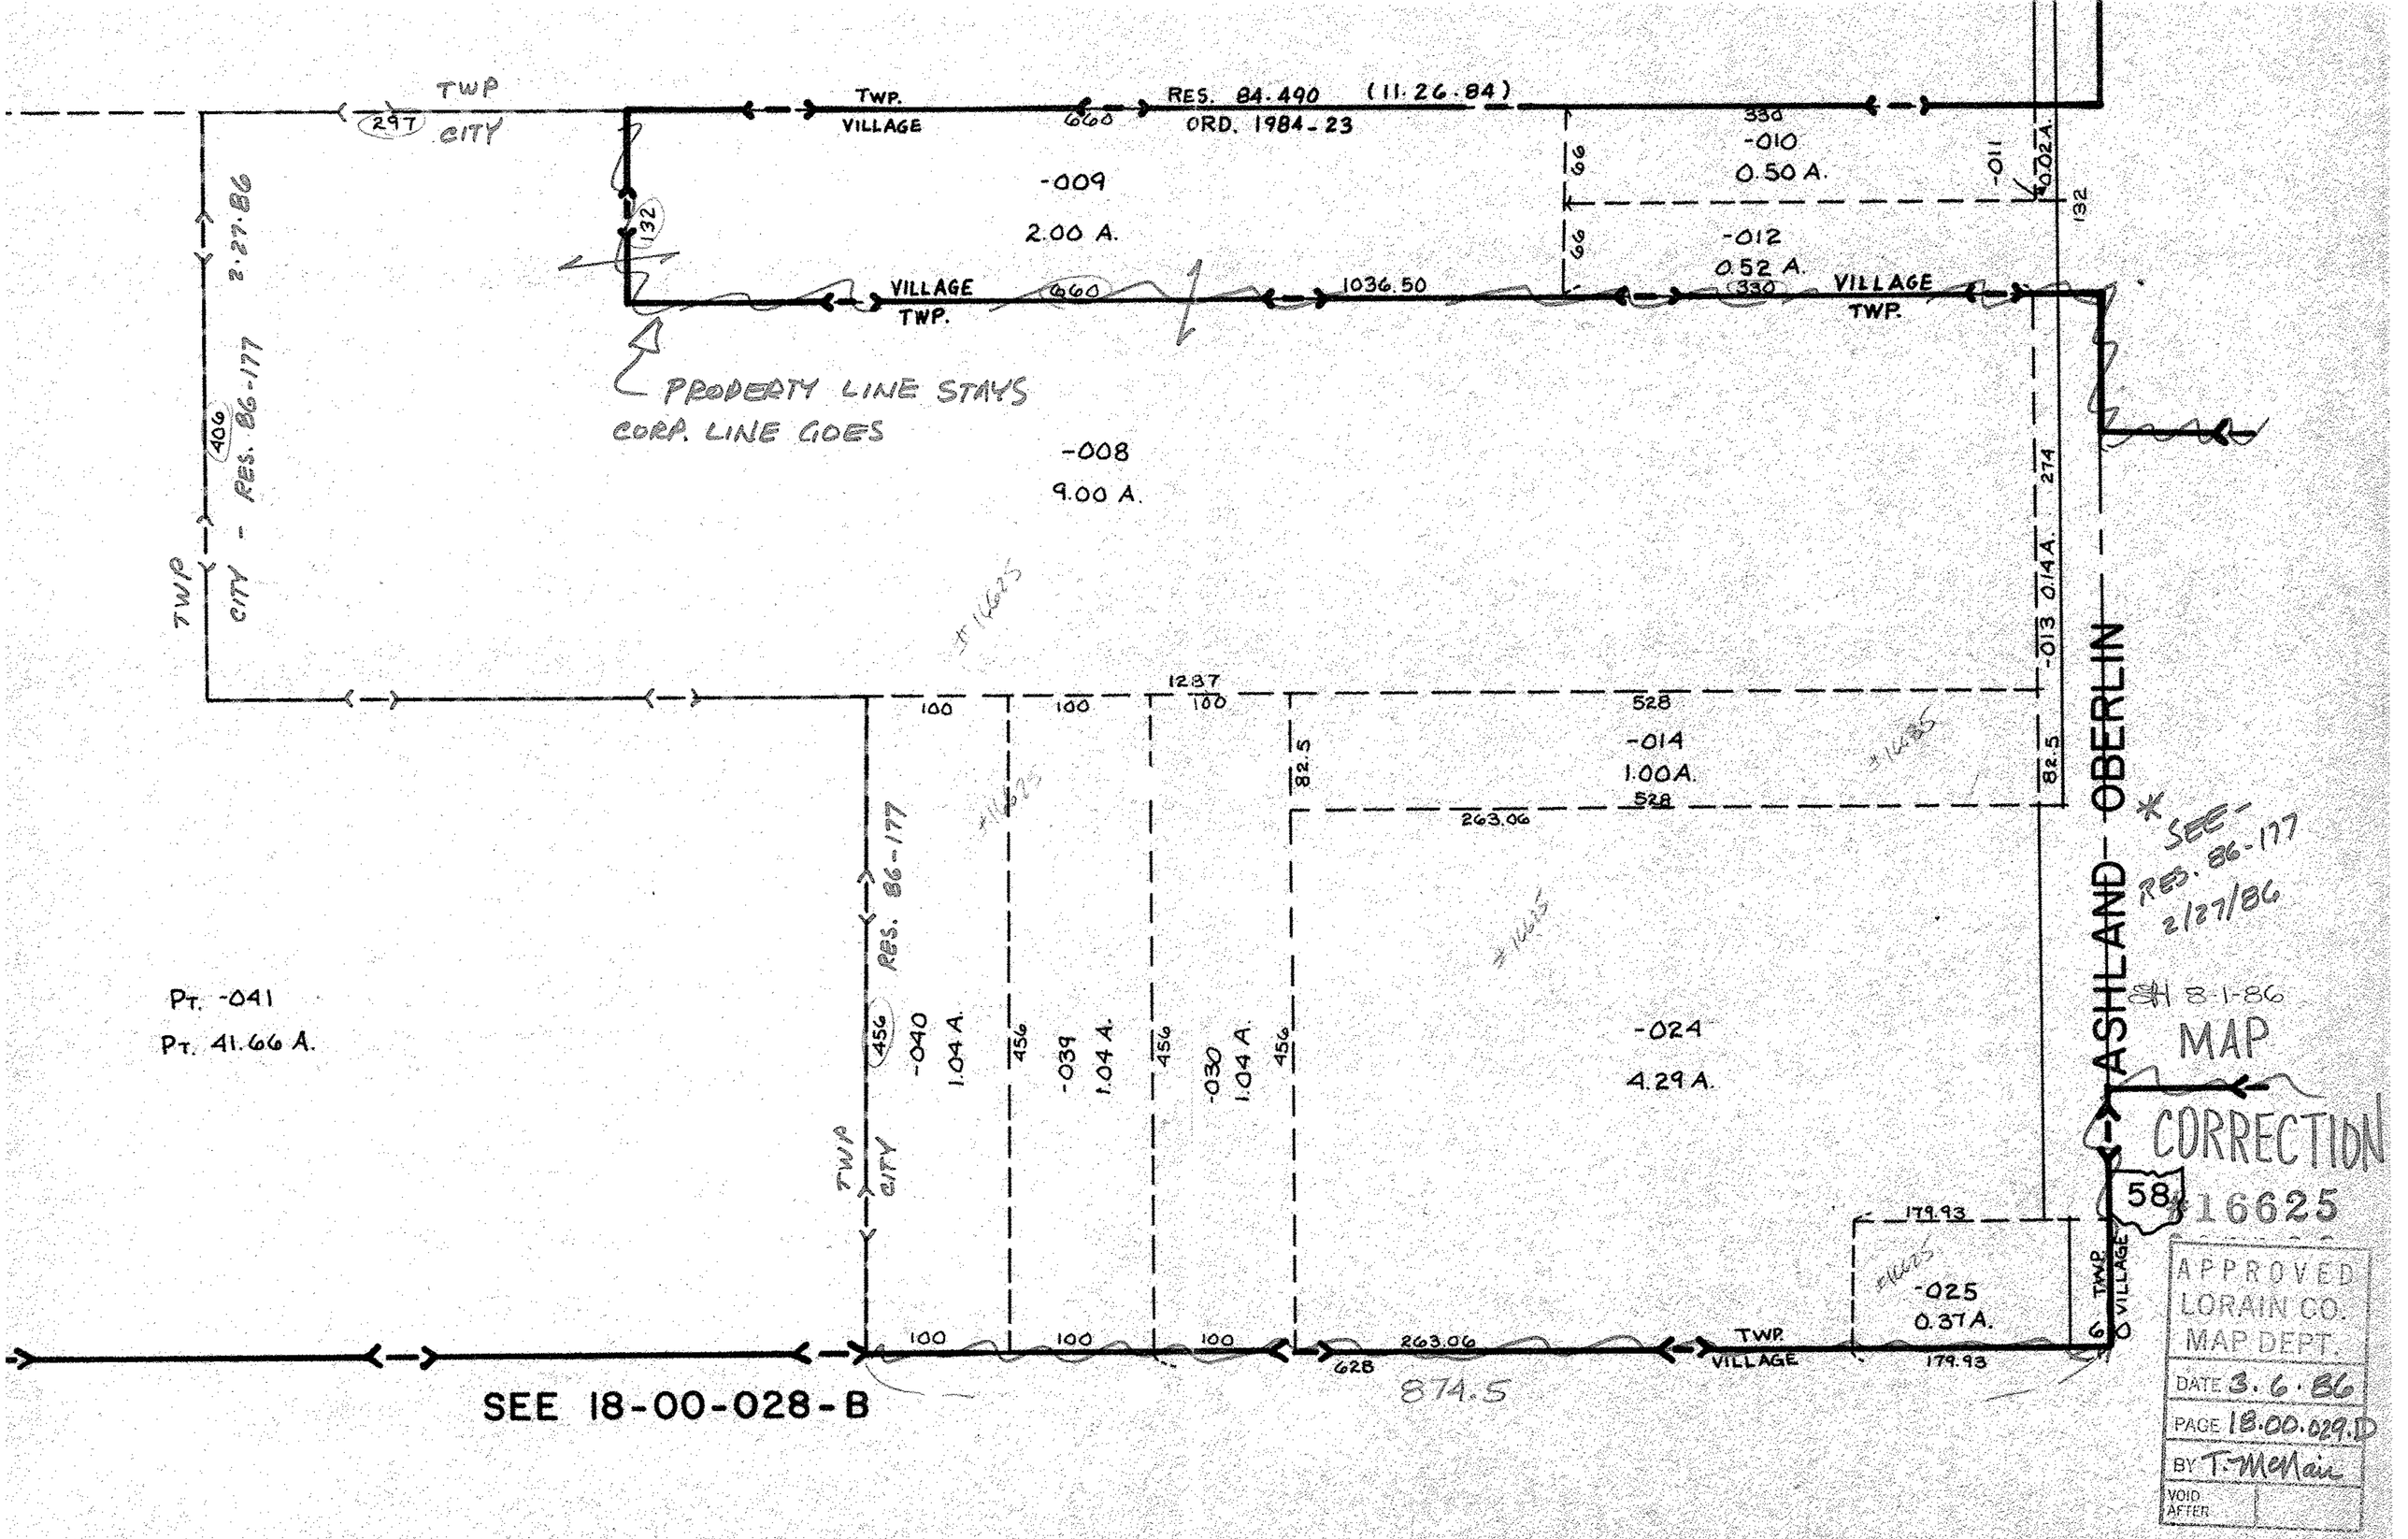
TWP
297
CITY
TWP.
VILLAGE
660
RES. 84.490 (11.26.84)
ORD. 1984-23
330
-010
0.50 A.
-011
0.02 A.
132
-009
2.00 A.
66
-012
0.52 A.
VILLAGE
TWP.
1036.50
PROPERTY LINE STAYS
CORP. LINE GOES
-008
9.00 A.
2.27.86
406
RES. 86-177
TWP
CITY
274
-013 0.14 A.
1287
100
528
-014
1.00 A.
82.5
263.06
ASHLAND - OBERLIN
* SEE - RES. 86-177 2/27/86
SH 8-1-86
MAP
CORRECTION
#16625
RES. 86-177
PT. -041
PT. 41.66 A.
456
-040
1.04 A.
-039
1.04 A.
-030
1.04 A.
-024
4.29 A.
58
179.93
-025
0.37 A.
TWP.
VILLAGE
628
874.5
SEE 18-00-028-B
APPROVED
LORAIN CO.
MAP DEPT.
DATE 3.6.86
PAGE 18.00.029.D
BY T. McNair
VOID AFTER