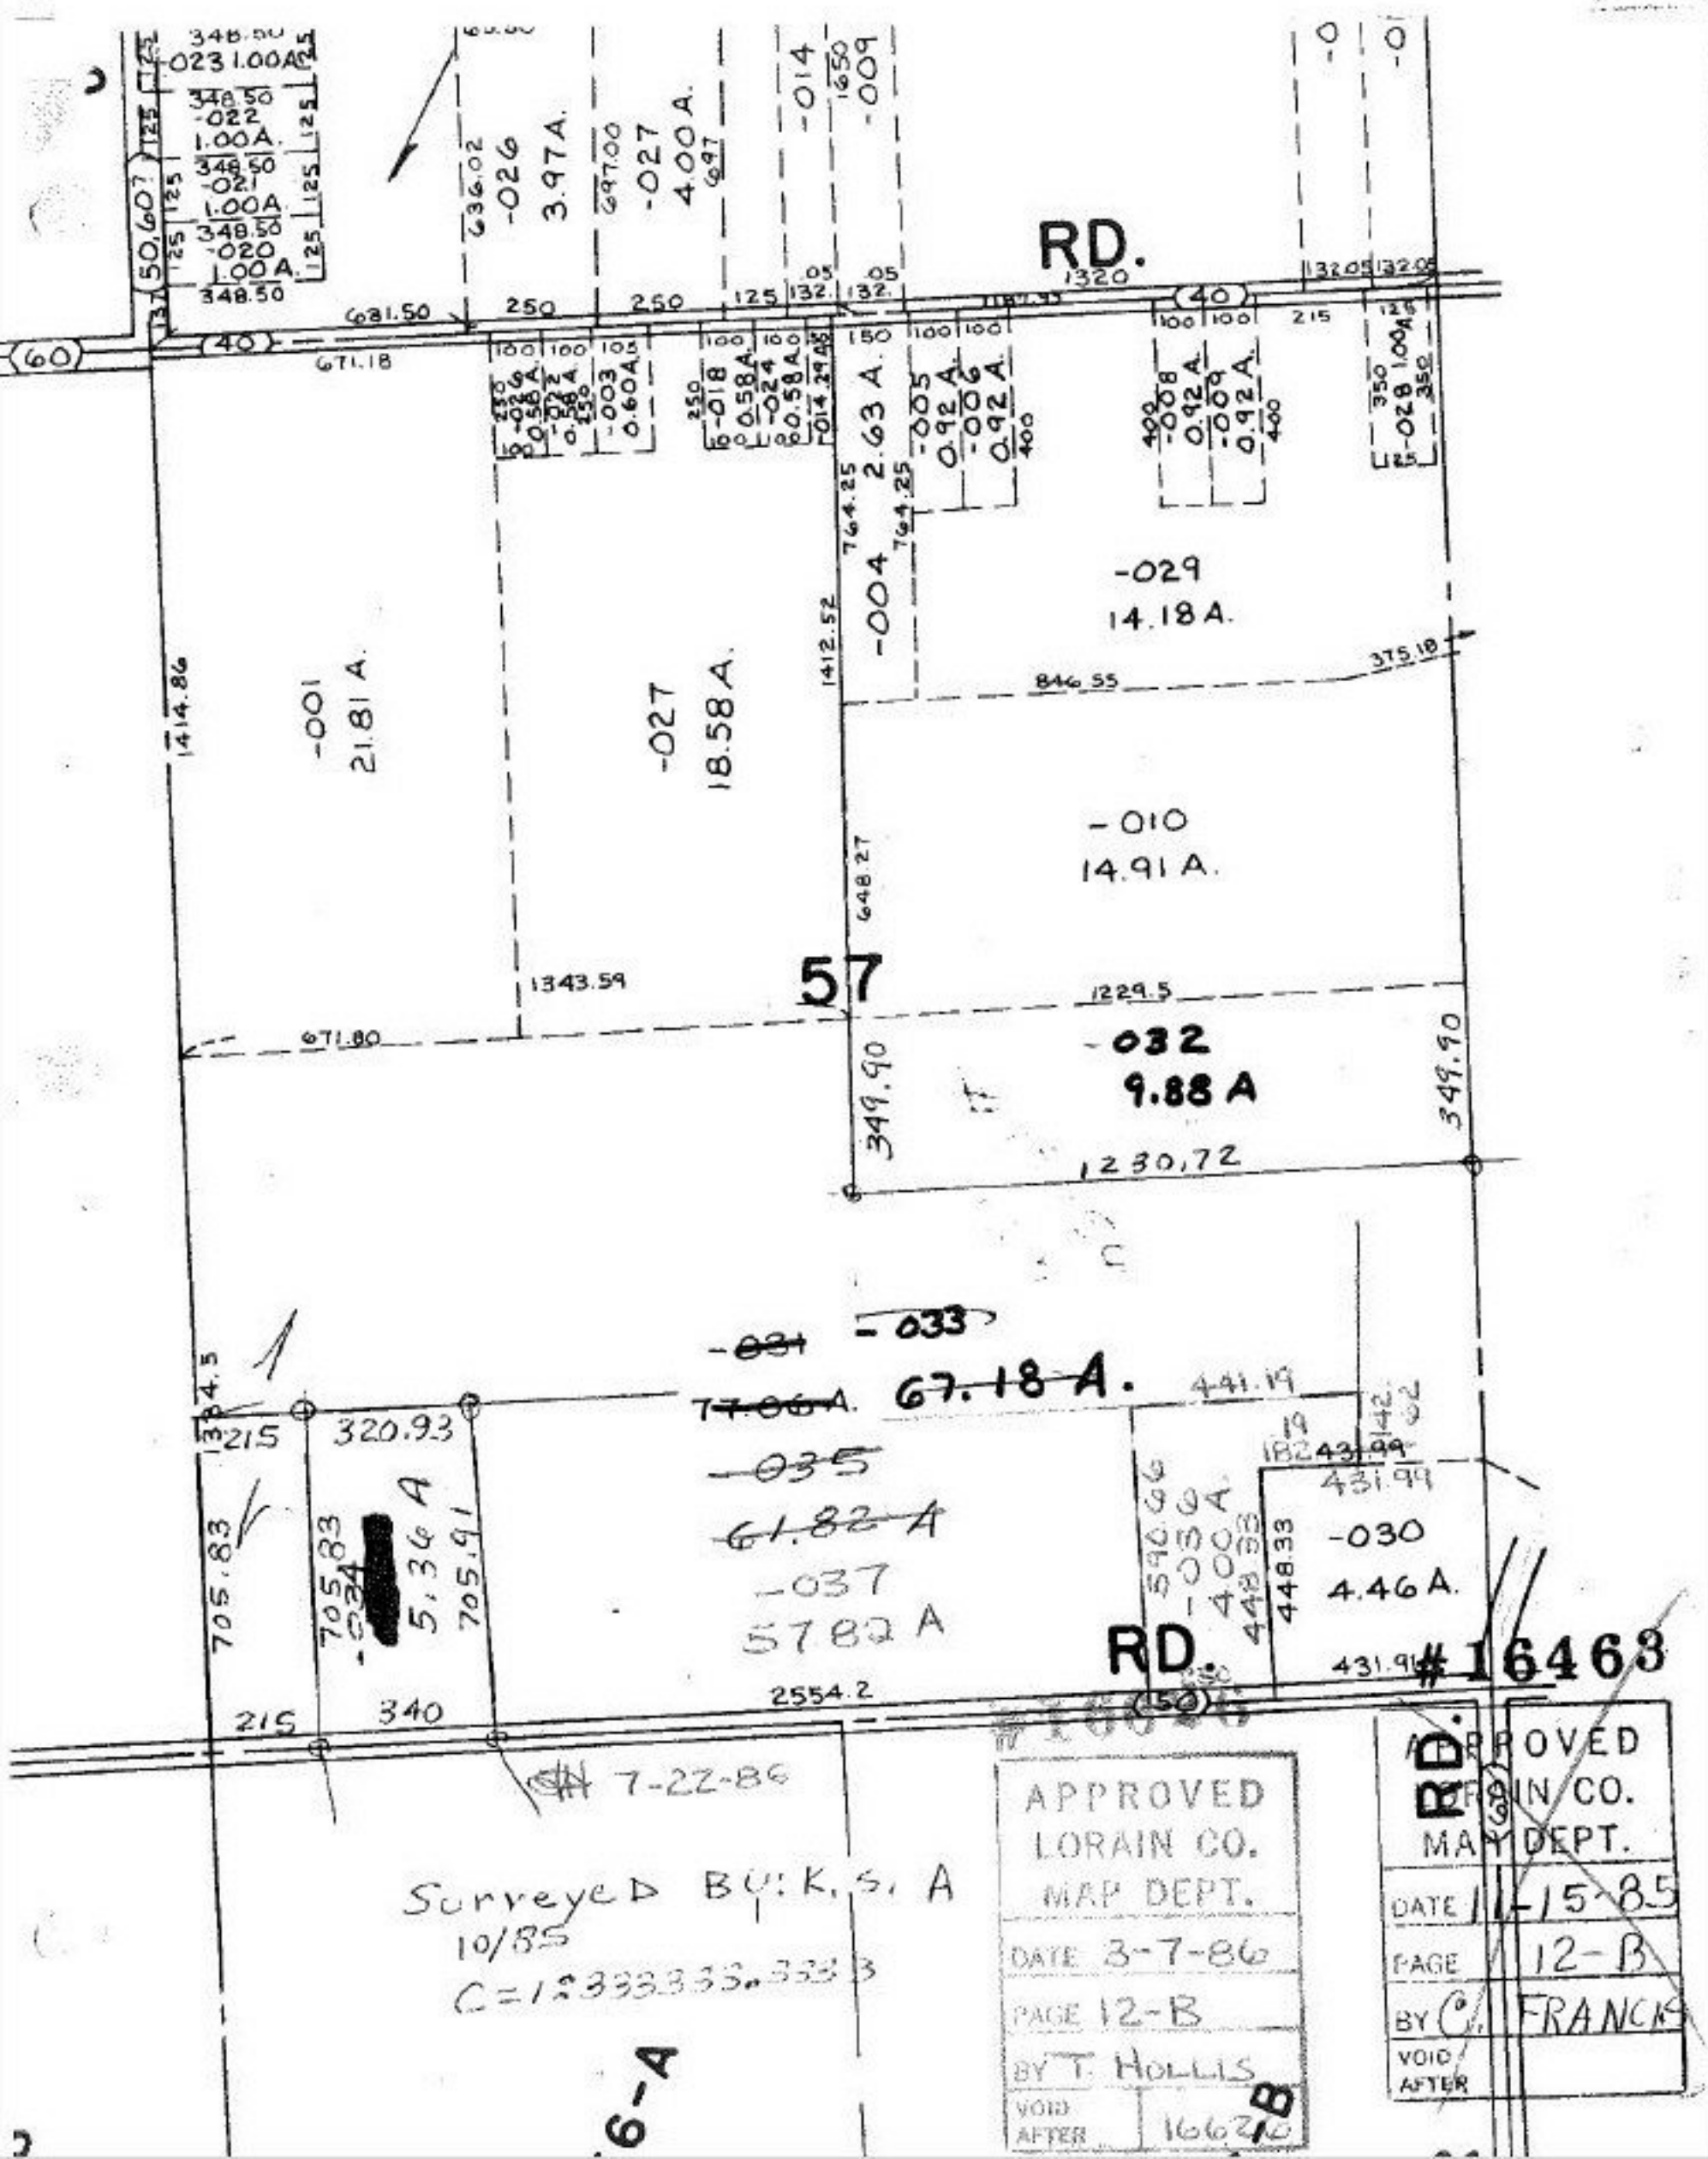

RD.
-029
14.18 A.
-010
14.91 A.
-001
21.81 A.
-027
18.58 A.
57
-032
9.88 A
-033
67.18 A.
-035
61.82 A
-037
57.82 A
-030
4.46 A.
RD.
#16463
7-22-86
Surveyed BY: K. S. A
10/85
C=1:333333.3333
APPROVED
LORAIN CO.
MAP DEPT.
DATE 3-7-86
PAGE 12-B
BY T. HOLLIS
VOID AFTER 16626
APPROVED
LORAIN CO.
MAP DEPT.
DATE 11-15-85
PAGE 12-B
BY C. FRANCIS
VOID AFTER