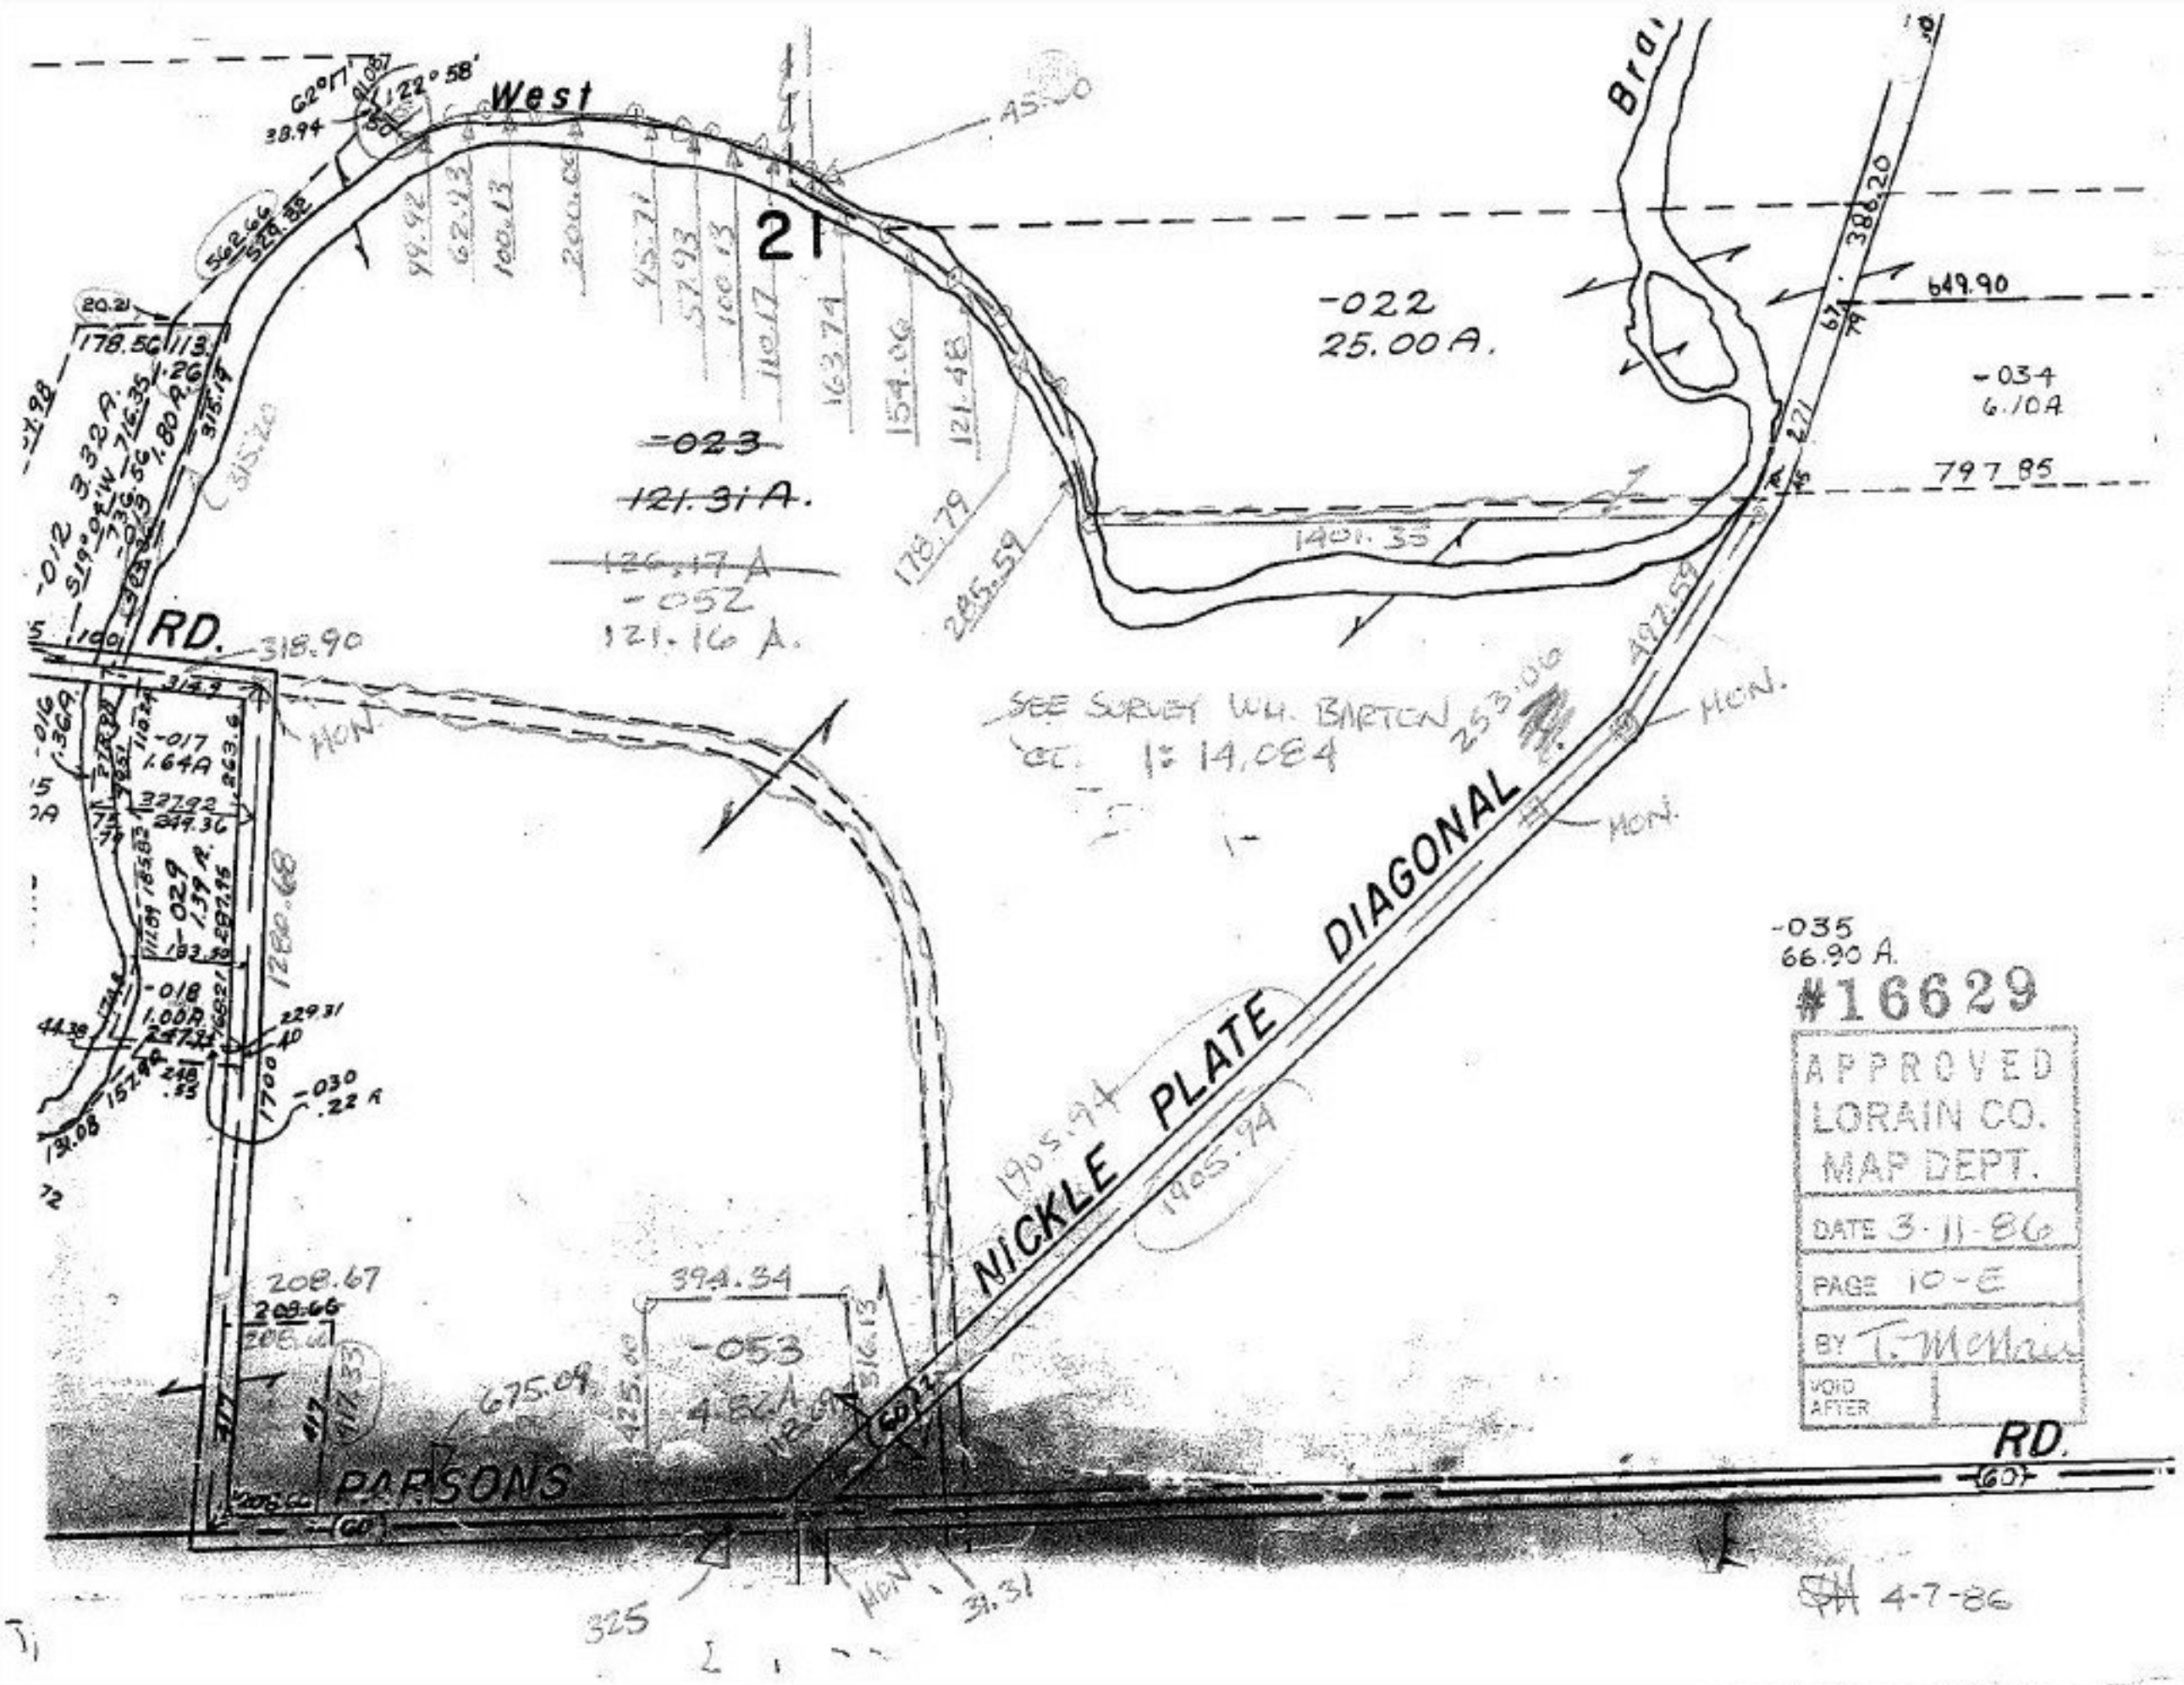
West
21
RD.
-022
25.00 A.
-023
121.31 A.
126.17 A
-052
121.16 A.
-034
6.10A
797.85
649.90
1401.35
SEE SURVEY WM. BARTON
CC. 1: 14,084
NICKLE PLATE DIAGONAL
-035
66.90 A.
#16629
APPROVED
LORAIN CO.
MAP DEPT.
DATE 3-11-86
PAGE 10-E
BY T. McNair
VOID AFTER
-053
4.82A
394.34
675.09
PARSONS
RD.
4-7-86