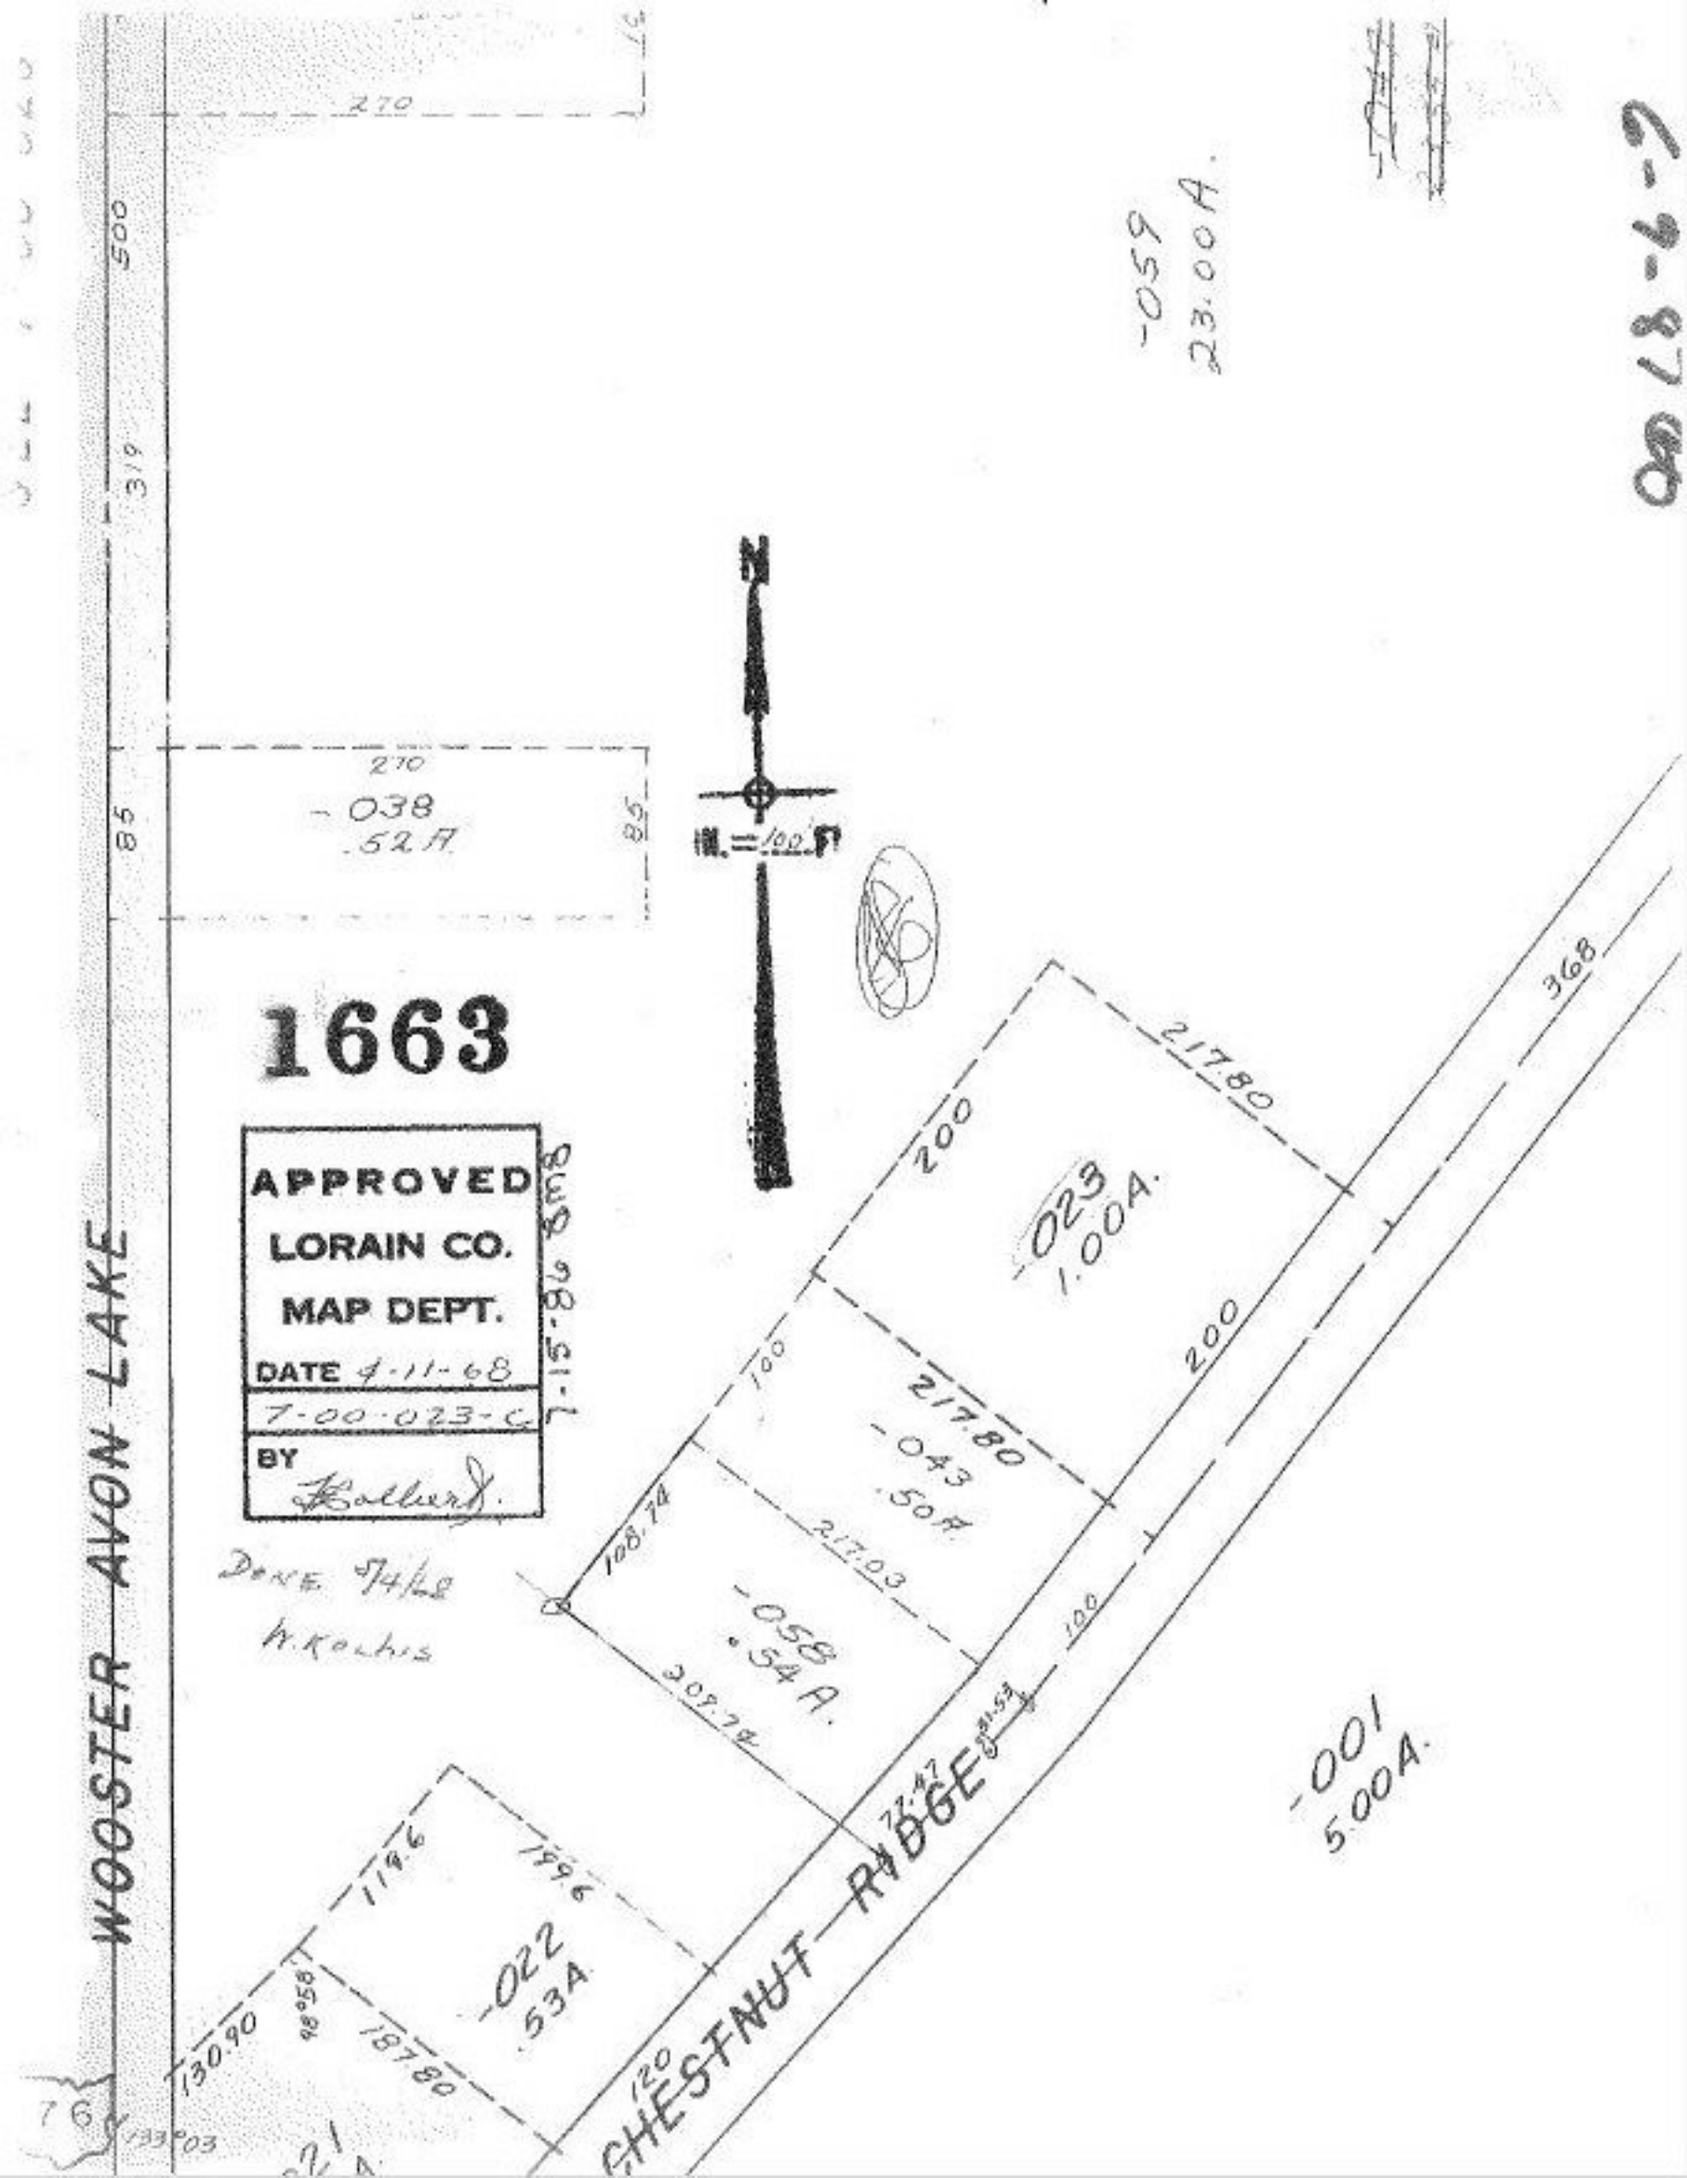

WOOSTER AVON LAKE
CHESTNUT RIDGE
270
500
319
85
-038
.52 A.
-059
23.00 A.
N
IN. = 100 FT
1663
APPROVED
LORAIN CO.
MAP DEPT.
DATE 4-11-68
7-00-023-C
BY
7-15-86 BMB
DONE 5/4/68
W. KOLLIS
200
217.80
368
-023
1.00A.
100
217.80
-043
.50A.
108.74
217.03
-058
.54 A.
209.74
100
72.47
-001
5.00A.
119.6
199.6
-022
.53A.
130.90
98°58'
187.80
120
133°03