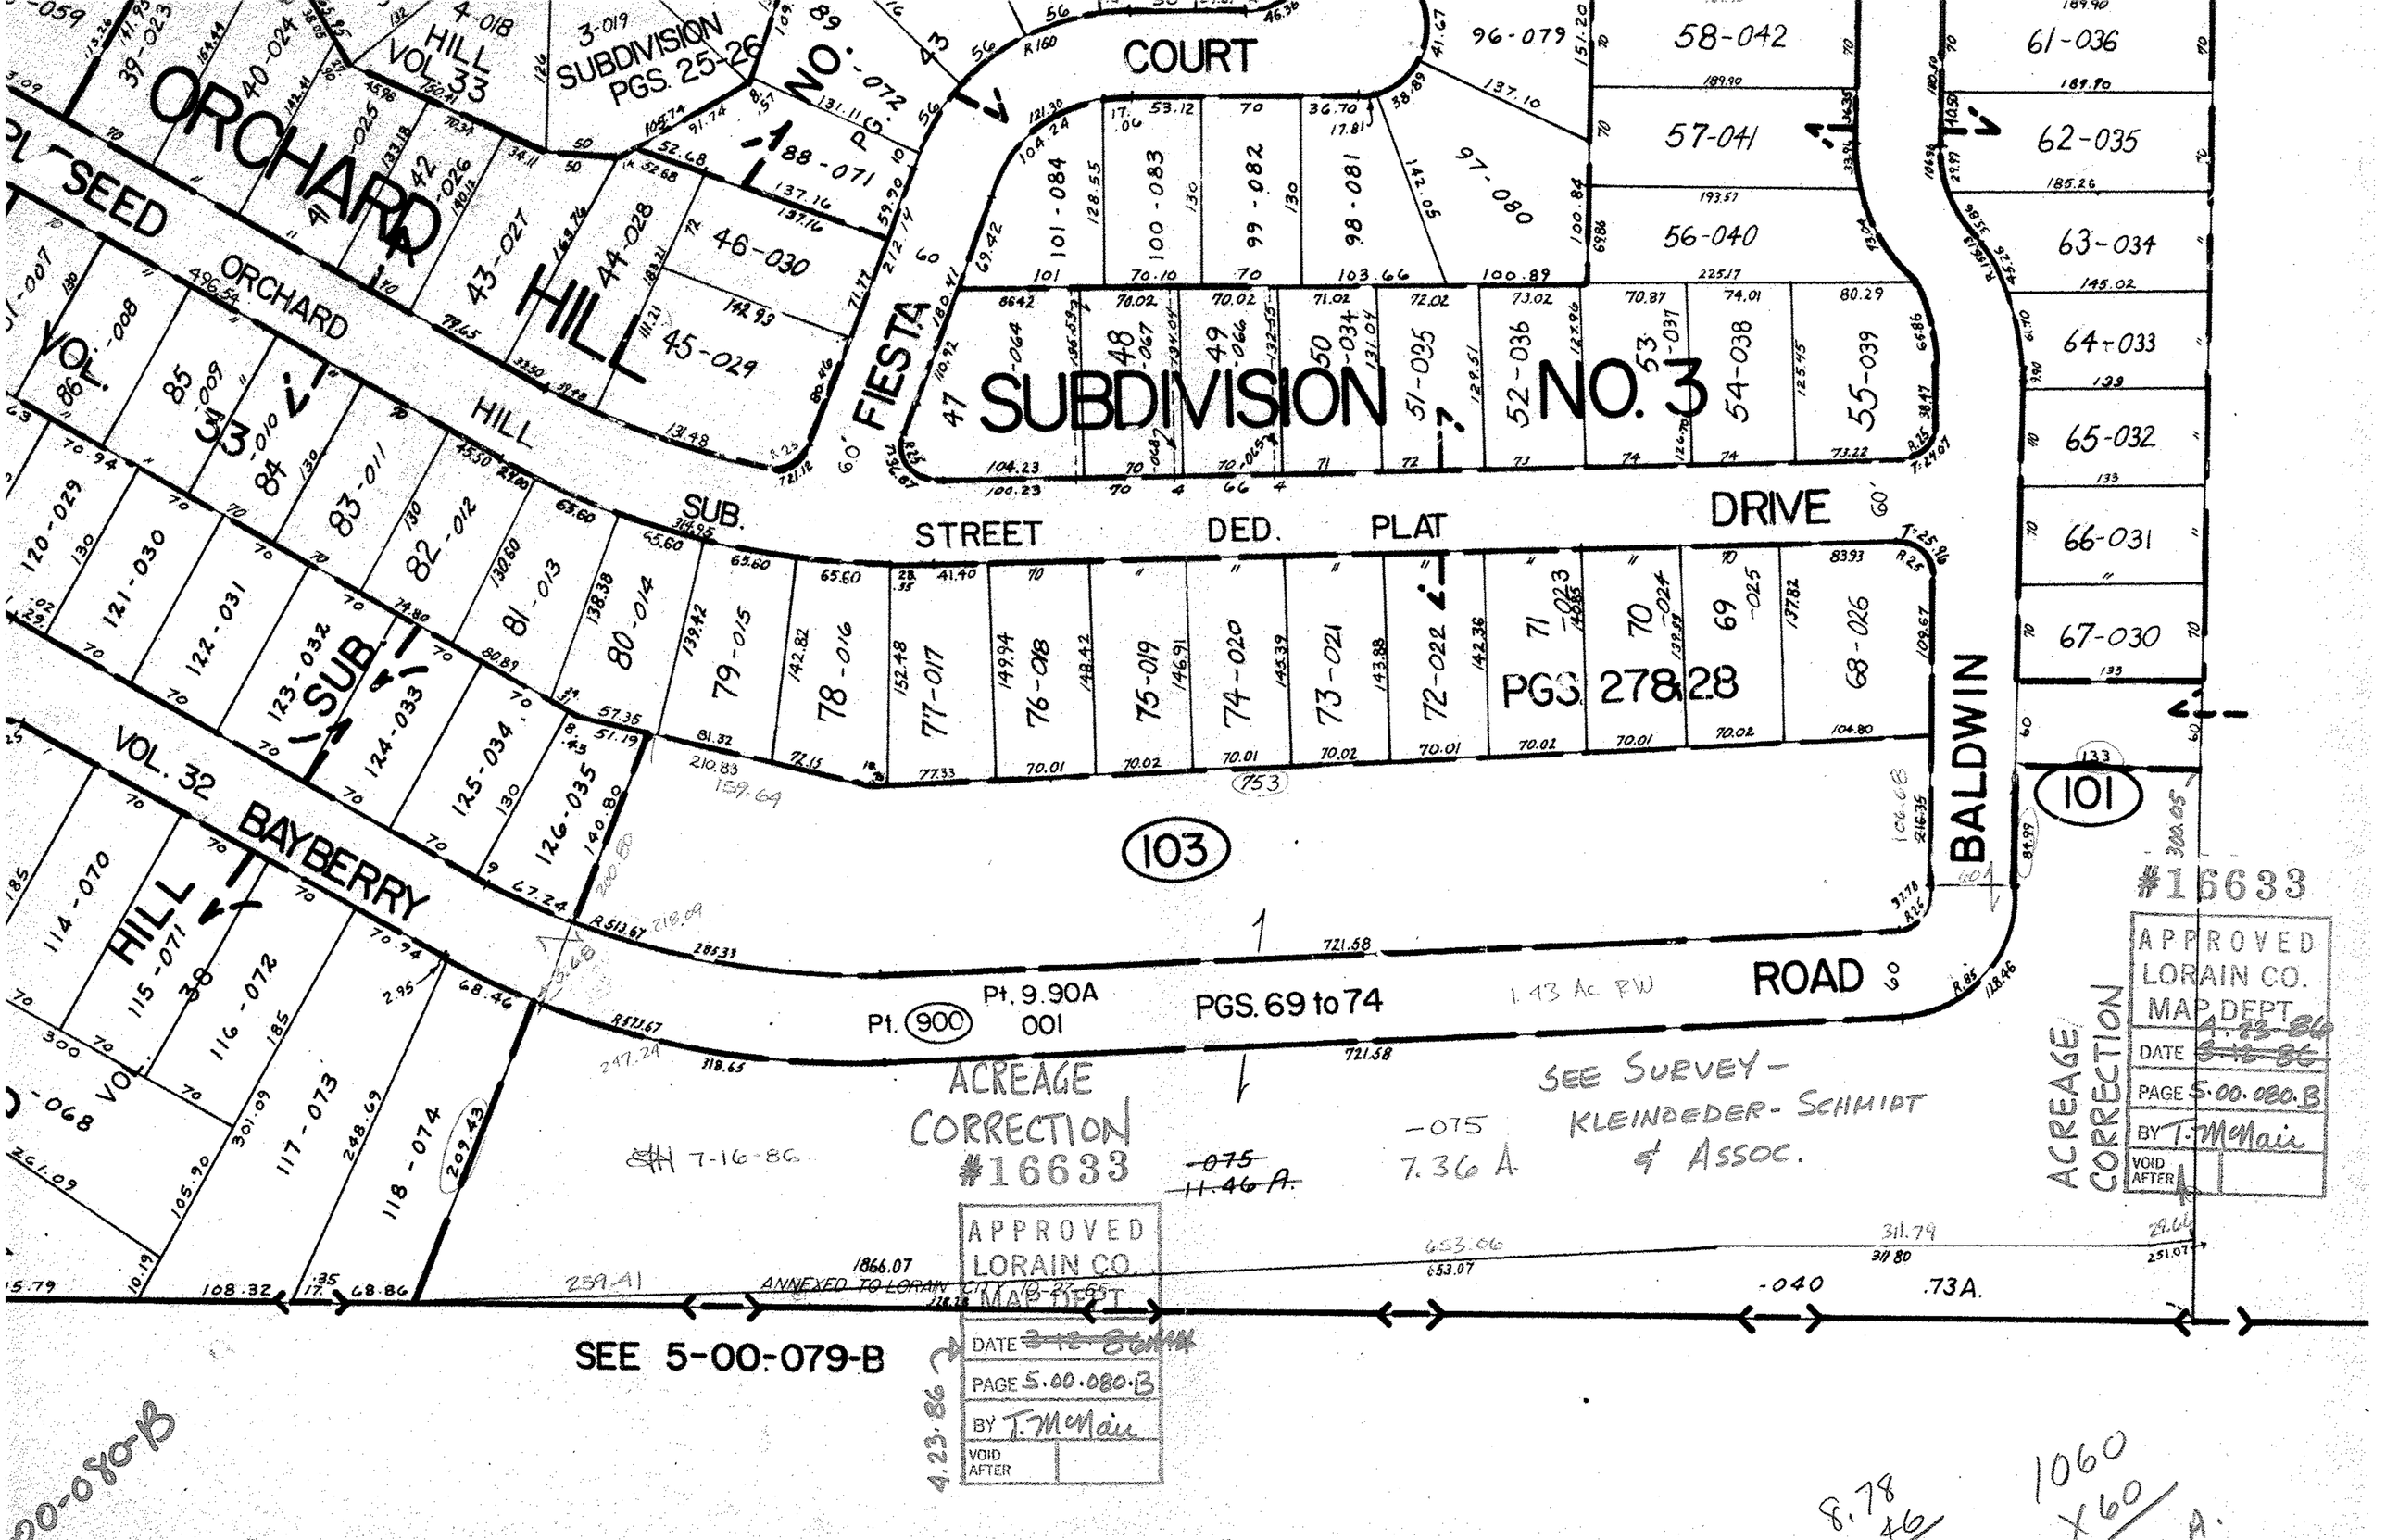

ORCHARD HILL
SUBDIVISION PGS. 25-26
COURT
FIESTA
SUBDIVISION NO. 3
ORCHARD HILL SUB. STREET DED. PLAT
DRIVE
PGS. 27 & 28
BALDWIN
ROAD
BAYBERRY
VOL. 32
VOL. 33
SUB.
HILL
103
101
Pt. 900
Pt. 9.90A
001
PGS. 69 to 74
1.43 Ac RW
ACREAGE CORRECTION #16633
SEE SURVEY - KLEINDEDER-SCHMIDT & ASSOC.
-075
7.36 A
-075
11.46 A.
ANNEXED TO LORAIN CITY 10-27-65
-040
.73A.
SEE 5-00-079-B
APPROVED LORAIN CO. MAP DEPT.
DATE 4-23-86
PAGE 5.00.080.B
BY T. McNair
VOID AFTER
#16633
APPROVED LORAIN CO. MAP DEPT.
DATE 4-23-86
PAGE 5.00.080.B
BY T. McNair
VOID AFTER
ACREAGE CORRECTION