SEE 3-00-079-A

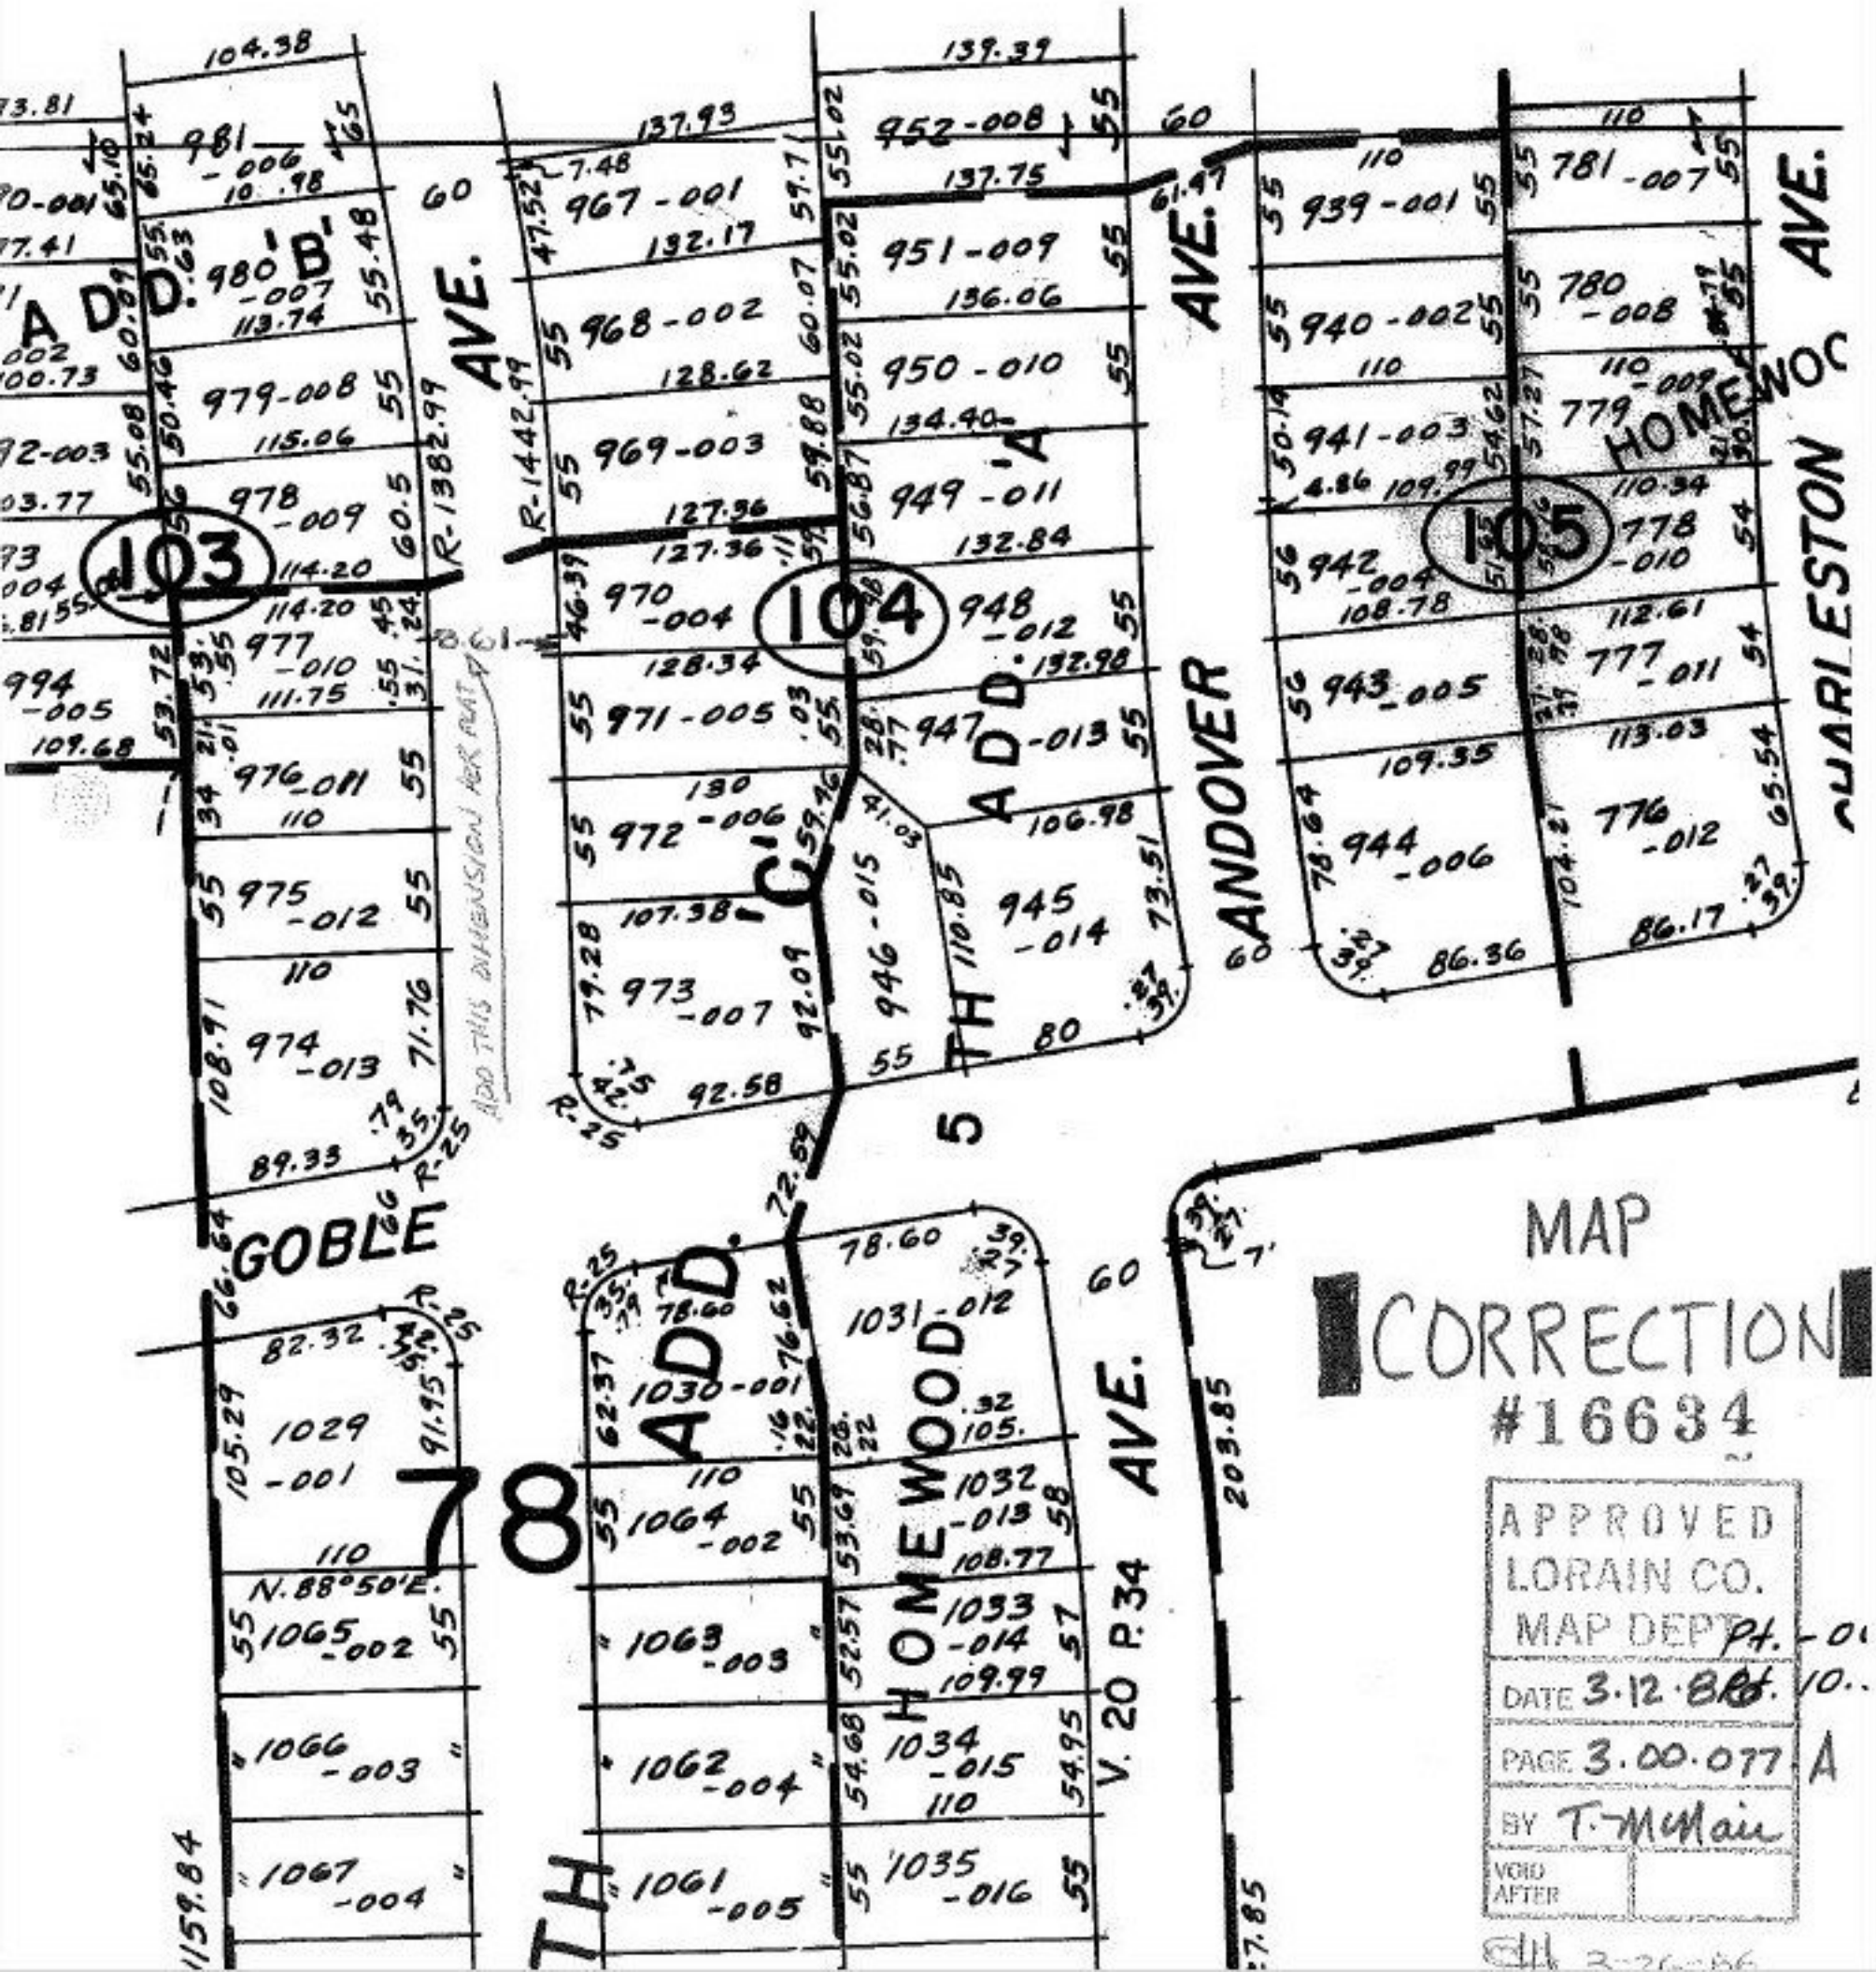

MAP CORRECTION #16634

APPROVED
LORAIN CO.
MAP DEPT.
DATE 3-12-86
PAGE 3.00.077 A
BY T. McMain
VOID AFTER

3-26-86