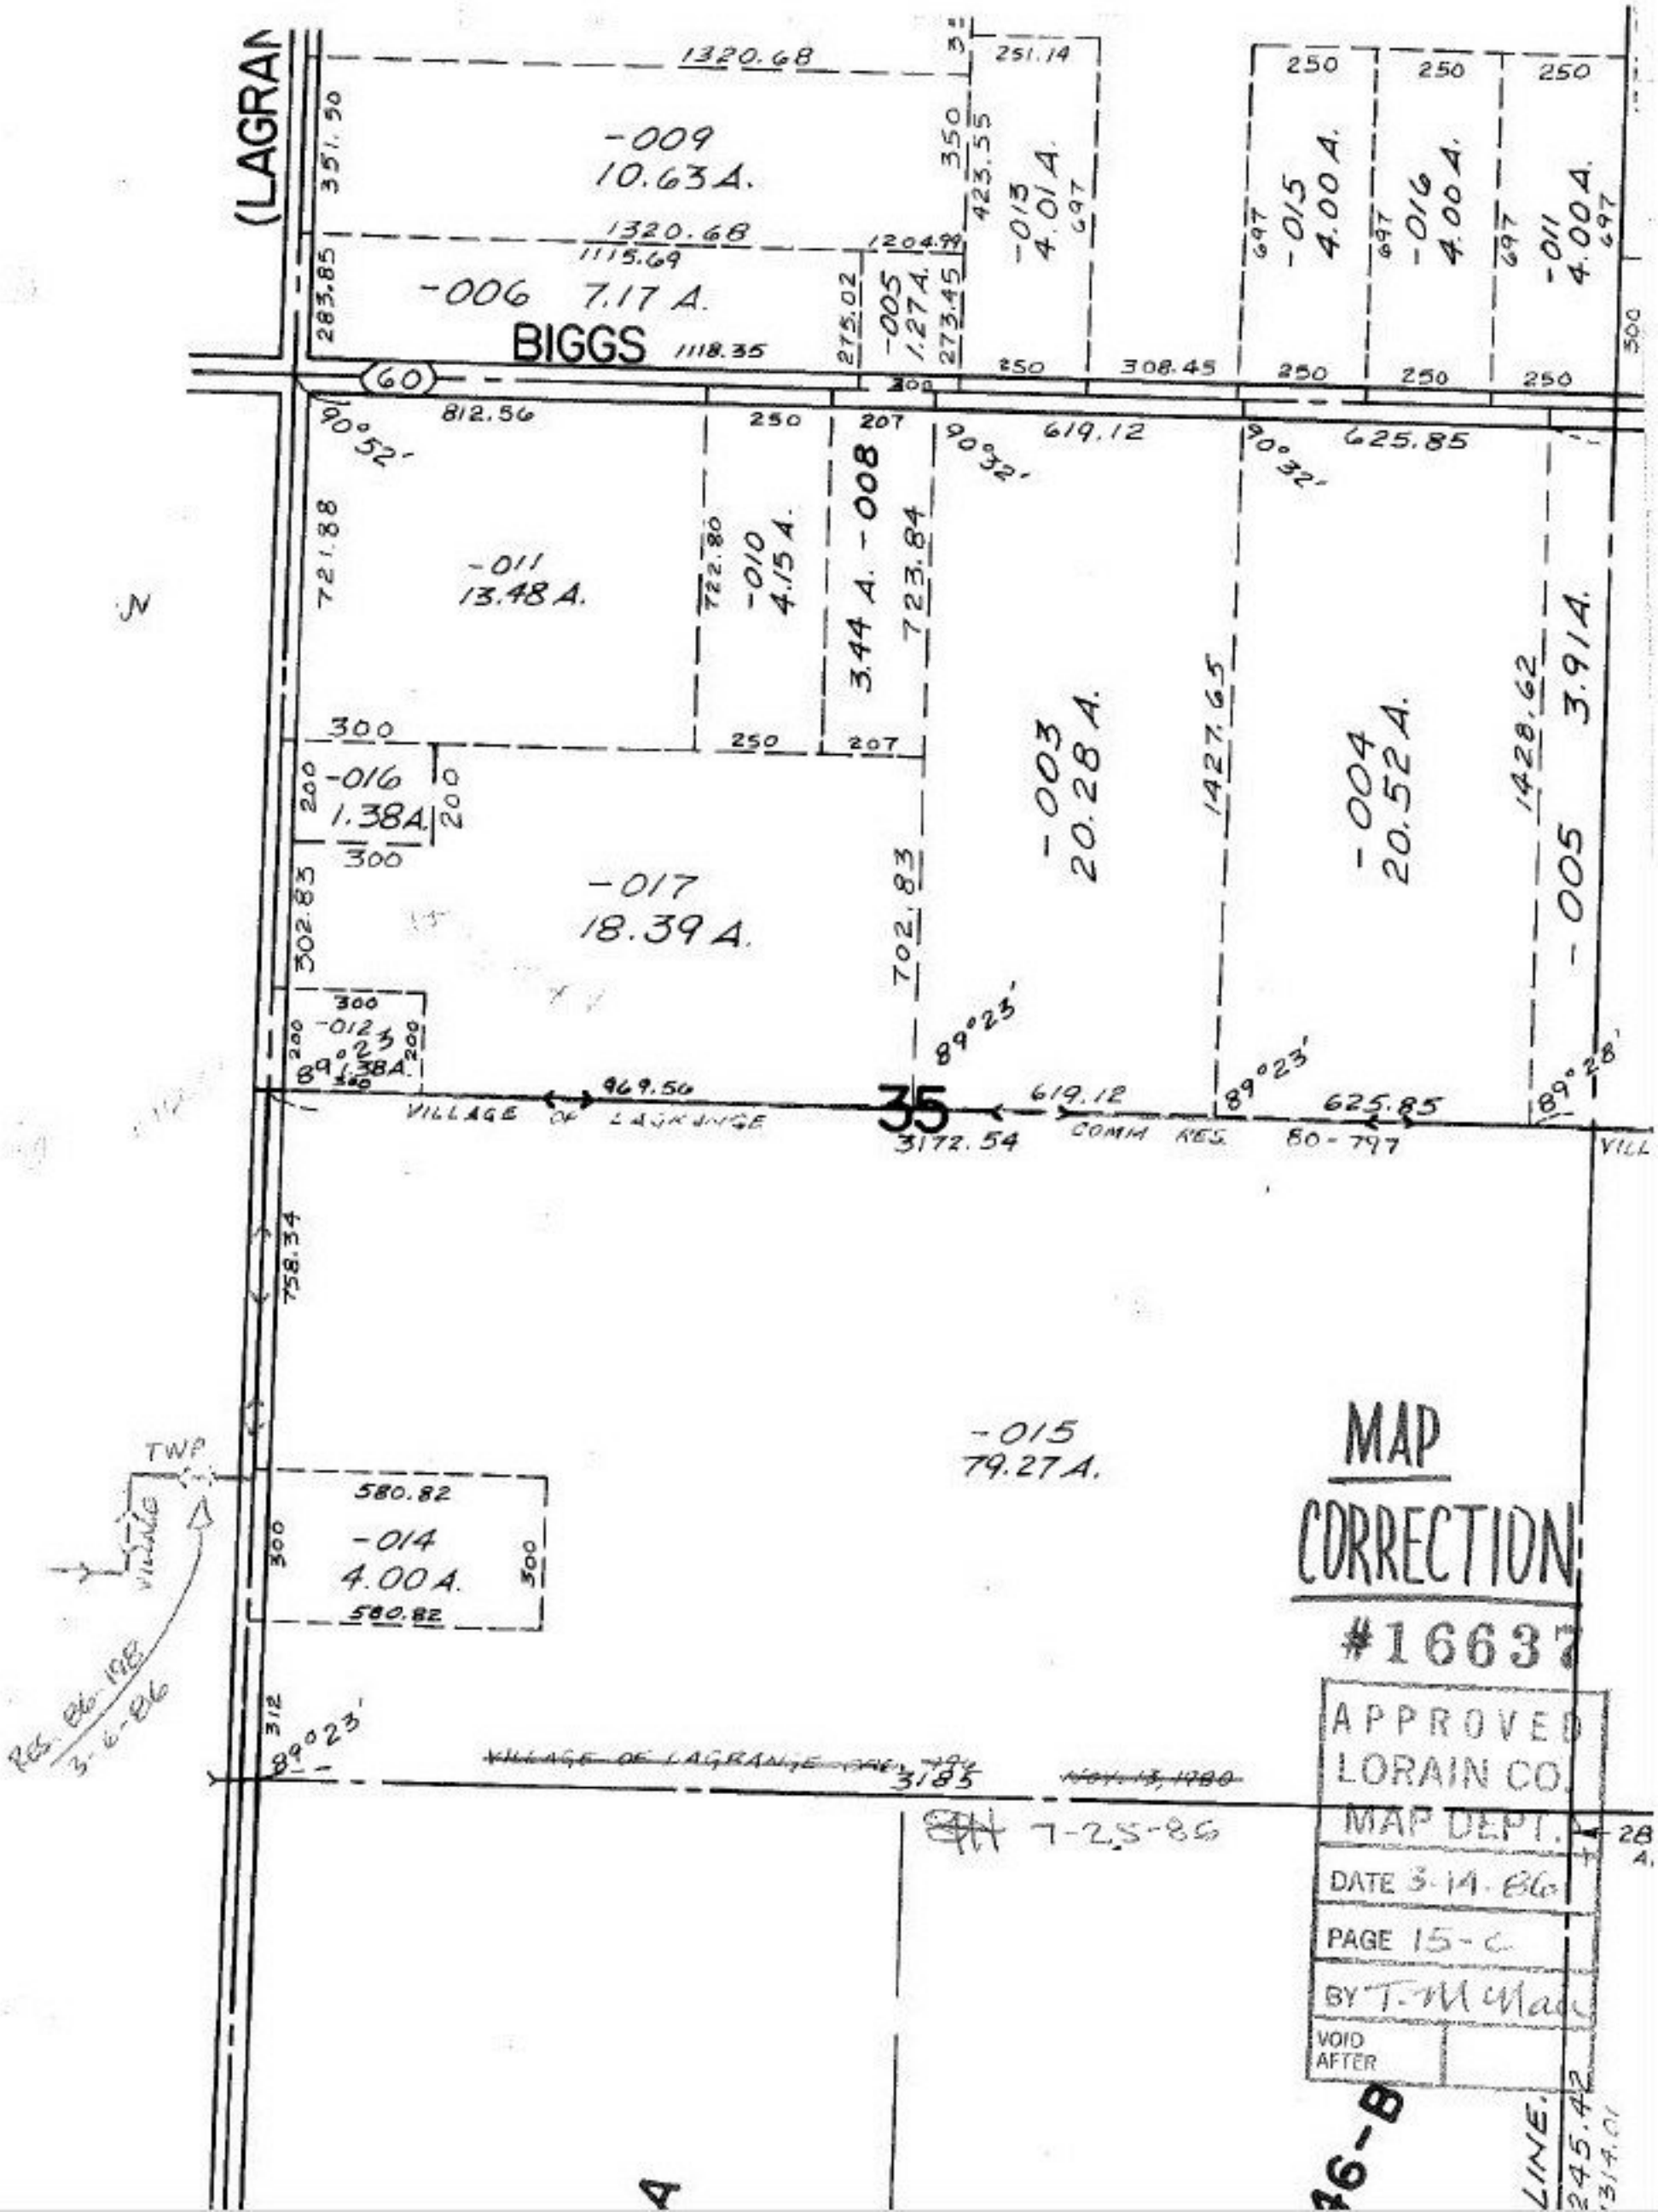

(LAGRAN
BIGGS
60
-009
10.63 A.
-006 7.17 A.
-005
1.27 A.
-013
4.01 A.
-015
4.00 A.
-016
4.00 A.
-011
4.00 A.
-011
13.48 A.
-010
4.15 A.
3.44 A. -008
-016
1.38 A.
-017
18.39 A.
-003
20.28 A.
-004
20.52 A.
-005
3.91 A.
-012
1.38 A.
35
VILLAGE OF LAGRANGE
COMM RES.
80-797
-015
79.27 A.
-014
4.00 A.
TWP
VILLAGE
RES. 86-198
3-6-86
VILLAGE OF LAGRANGE
3185
7-25-86
MAP
CORRECTION
#16637
APPROVED
LORAIN CO.
MAP DEPT.
DATE 3-14-86
PAGE 15-C
BY T. McMa
VOID
AFTER