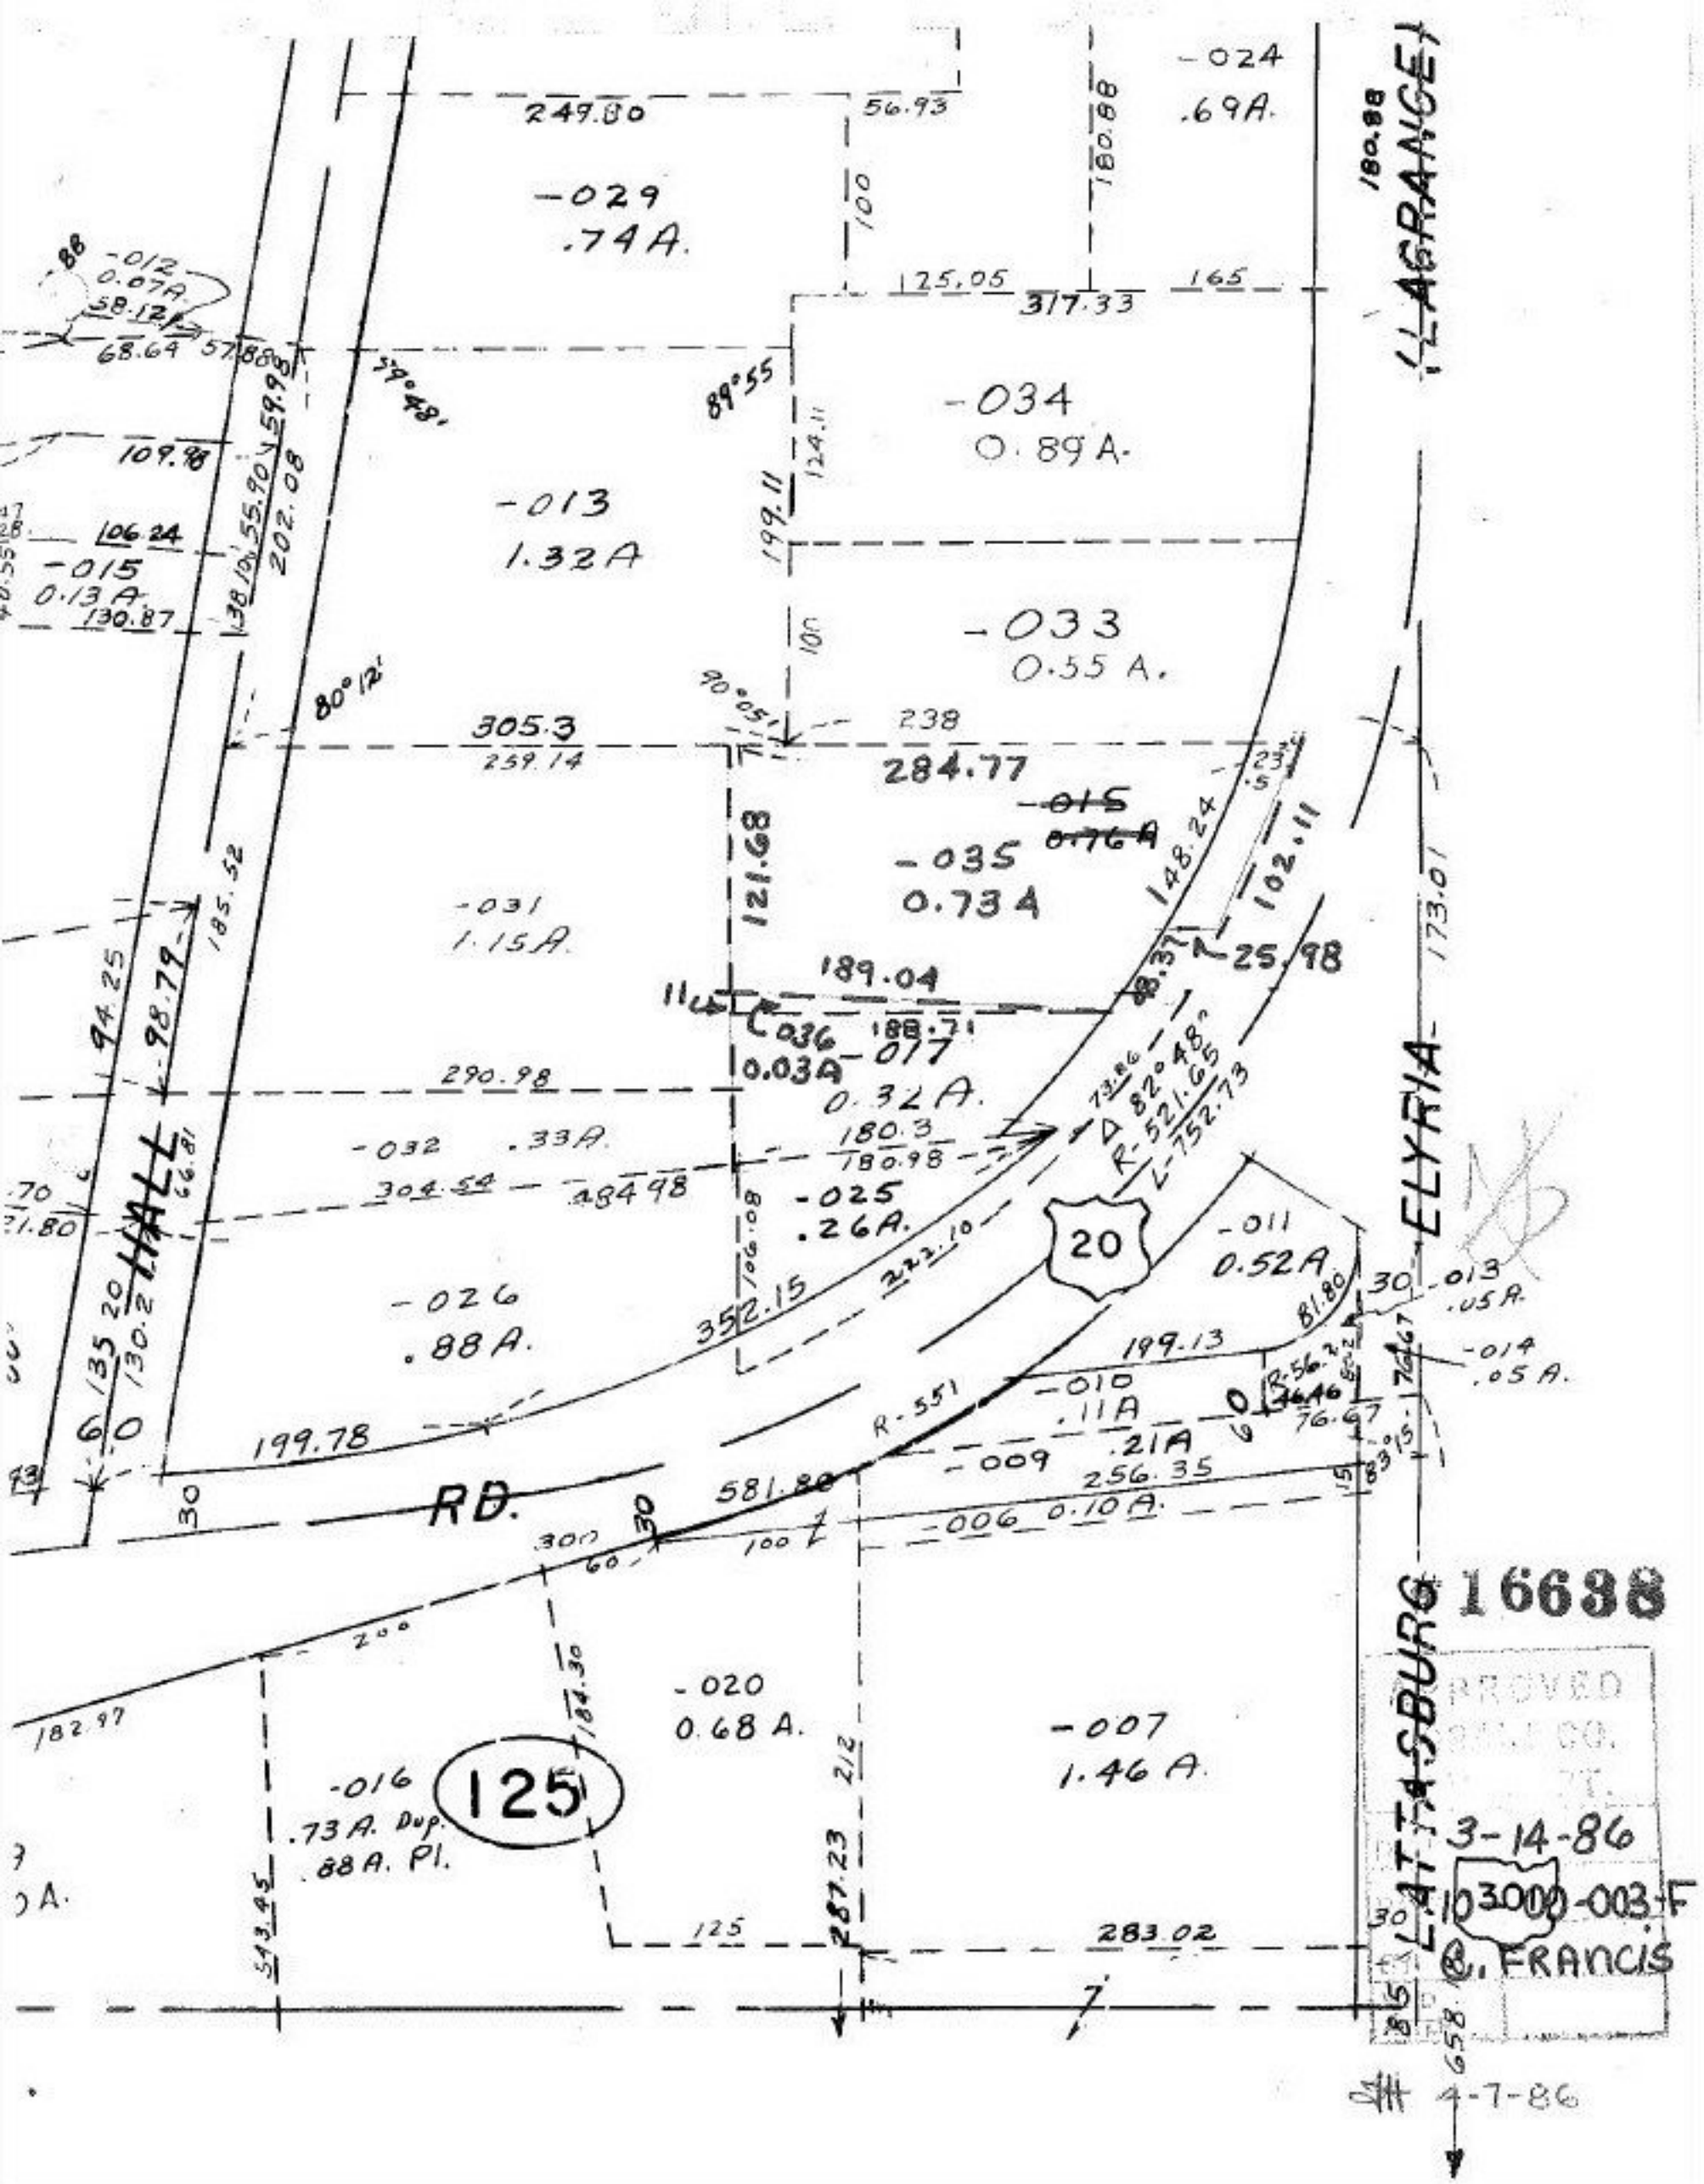

16638

APPROVED
SALE CO.
PT.

3-14-86

103000-003-F

C. FRANCIS

4-7-86